


PLC NEW COPPER CROSSING AFTER CONST COMPLETION - BORE

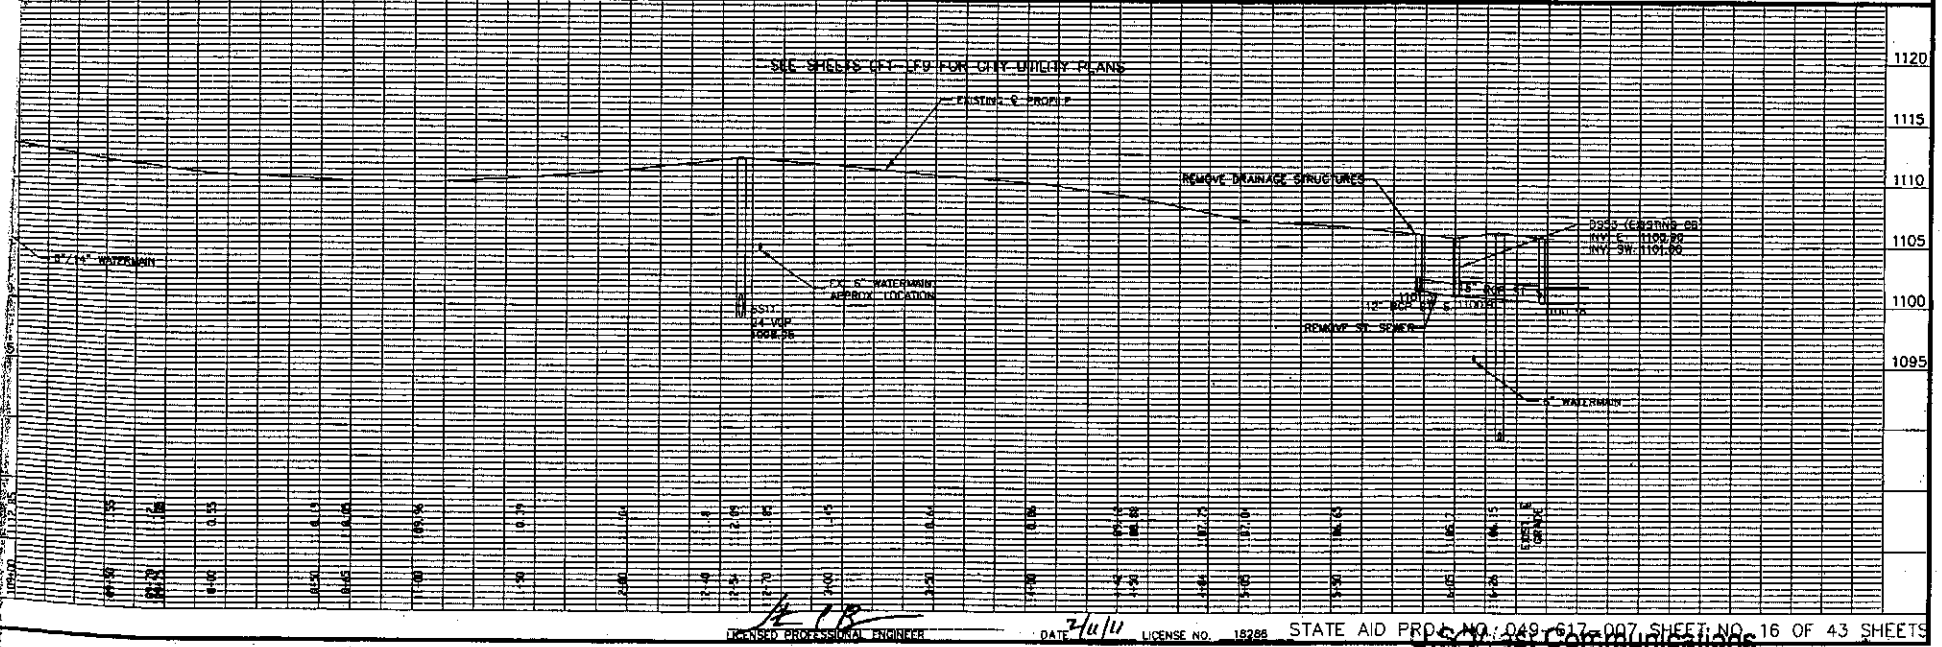

Licensed Professional Engineer DATE 7/10/11 LICENSE NO. 19288 STATE AID PROJ NO: 049-617-007 SHEET NO. 16 OF 43 SHEETS

COUNTY PROJ #049-617-007

Application for Permission to Place
 Telephone Company Plant on Highway
 Right of Way
 City LITTLE FALLS County MORRISON
 CO Highway Number 17 Control Sect
 J.O. 12M2H86 Date 4.29.11
 Engineer DJ BREHMERT Tel. No 320.255.8294
 Prt LOE 2

66+16.29

FIFTEENTH STREET

1" = 30'

RAYMOND VAN HERCKE

CYNTHIA CLUKA

**BORE ACROSS
CO RD 17
6' DEPTH**

REMOVE STORM SEWER

REMOVE MARIE CURB & GUTTER BOTH SIDES 22' TOTAL

66+18 15TH STREET SW
INP 18" X 38" CMP WA
DO NOT DISTURB

68+90 GRAY CONM ENT
INP 18" X 44" CMP NA REMOVE
18" X 48" CS PIPE CULY
2 CS PIPE APRONS

69+44 CL CULY
INP 28" SPAN X 48" CMP NA REMOVE
SEE STORM SEWER CHART

BEGIN S.A.P. 049-617-007
STATION 68+50

REMOVE BITUMINOUS PAVEMENT

CYNTHIA CLUKA

CRAIG & I

66+16 FE ENT
INP 15" X 32" CMP NA
DO NOT DISTURB

CULT


RICHARD & ALVINA RODEN

YARD

DOUGLAS WOJTANOWICZ

RODNEY SCHUETT

ALL CA 55' FROM E 36" DEPTH

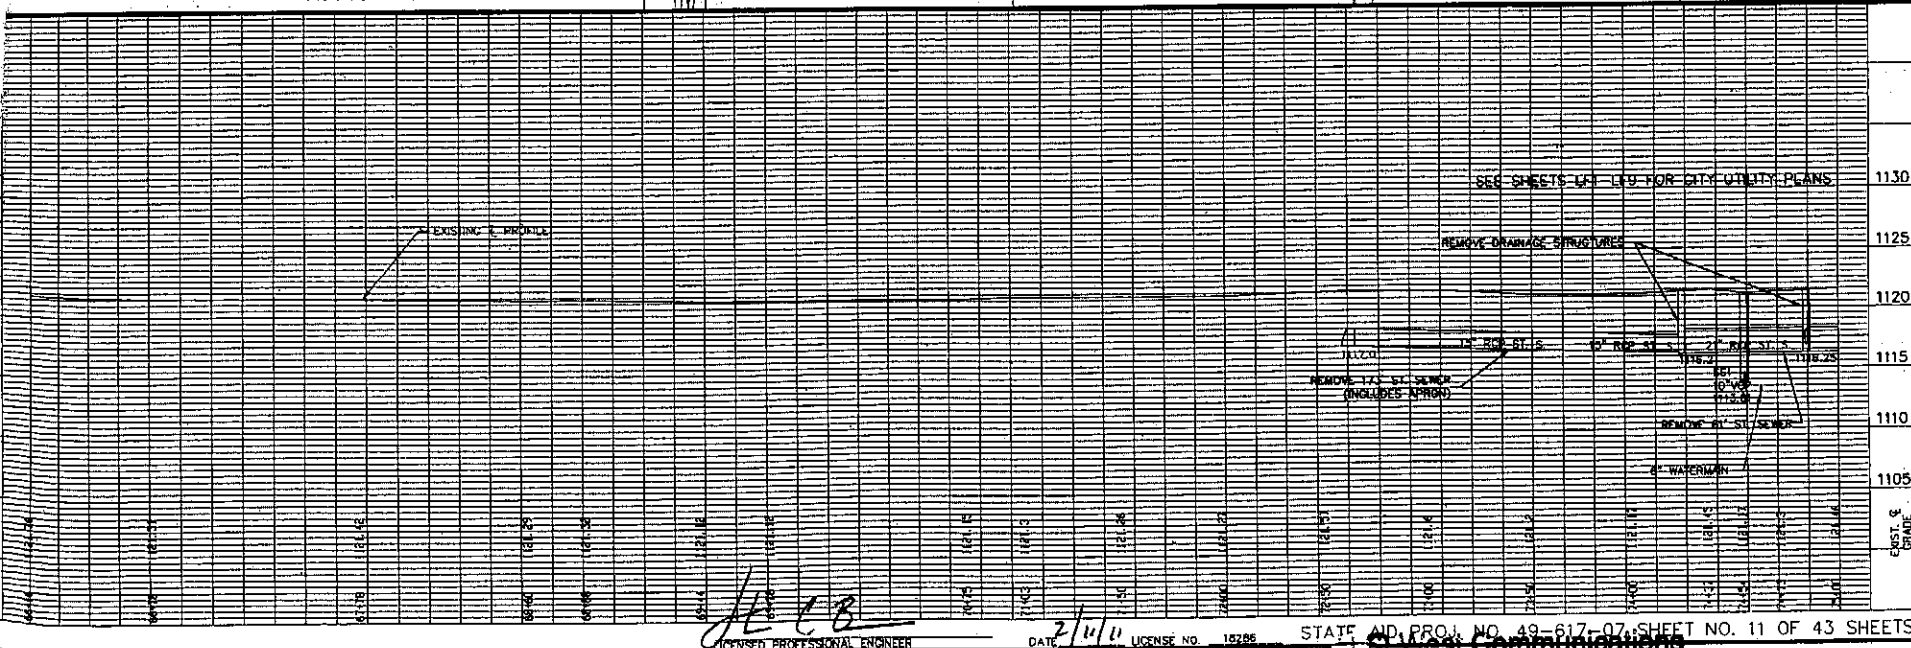

J.E. CB
LICENSED PROFESSIONAL ENGINEER

DATE 2/11/11 LICENSE NO. 18286

STATE HD PROJ. NO. 49-617-07 SHEET NO. 11 OF 43 SHEETS

COUNTY PROJ #049-617-007

J.G. West Communications
 Application for Permission to Place
 Telephone Company Plant on Highway
 Right of Way
 City LITTLE FALLS County MORRISON
 CO Highway Number 17 Control Sect
 J.O. 12M2H86 Date 4.29.11
 Engineer DJ BREHMER Tel. No. 320.255.8294
 P&E 2 OF 2