

BSW SKETCH FORM


NPA / NNX (Wire Center): 320-632

Area Code 320
FAX TO : 1-877-410-2631

NECTAS # _____

Date Submitted: 8/17/11

Install / Repair / Preprovisioning Job ID <u>0448207-229A</u> TN <u>320-632-5941</u>	Customer Name: <u>Richard FEDA</u> Address: <u>9373 Cable RD</u> City: <u>LITTLE Falls</u> 911 Address: _____ Phone: <u>320-632-5941</u> CBR: <u>320-761-2439</u> Hudson / King (circle one) _____ Year _____ County <u>Morrison</u> Section <u>4</u> Range <u>R.30w</u> Township <u>T.128N</u> Quarter Section (Circle one) <u>(NW)</u> - NE - SW - SE
1. Held for BSW <input type="checkbox"/> 2. Held - cannot locate ENCAP <input type="checkbox"/> 3. OOS - Can not lay temp <input type="checkbox"/> 4. Held for F1-F2, also need BSW <input type="checkbox"/> 5. Temp Placed - (See Sketch Below) <input type="checkbox"/> 6. Found Temp - Same Job <input type="checkbox"/> - Other Location <input type="checkbox"/> 7. Add Line <input type="checkbox"/>	Submitted By _____ Name: <u>Robert</u> EC: <u>343</u> Pgr/Cel: <u>320-291-9640</u> Supervisor: <u>Howard</u> Office #: <u>320-255-8575</u> Pager: <u>320255-8575</u> Customer was contacted: <input checked="" type="checkbox"/> N <input checked="" type="checkbox"/> Verbal <input type="checkbox"/> Card
Terminal Address: <u>F 9401 Cable RD CA</u> PR <u>308</u> BP <u>8</u> Gross Street: <u>CR 222</u> Total BSW Footage: <u>200</u> Type of Wire: <u>3pr</u> <input checked="" type="checkbox"/> (3pr/6pr)	
L-INFO: <u>L</u> <u>R</u> <u>E</u> <u>2</u> <u>C</u> <u>A</u> <u>3</u> <u>S</u> <u>N</u> <u>c</u> L,E F,R,S N,E,S,W 1-2-3-4-5-6-7 W,S,P,O,C G,A,M,N 3/6 S,N P,N c	

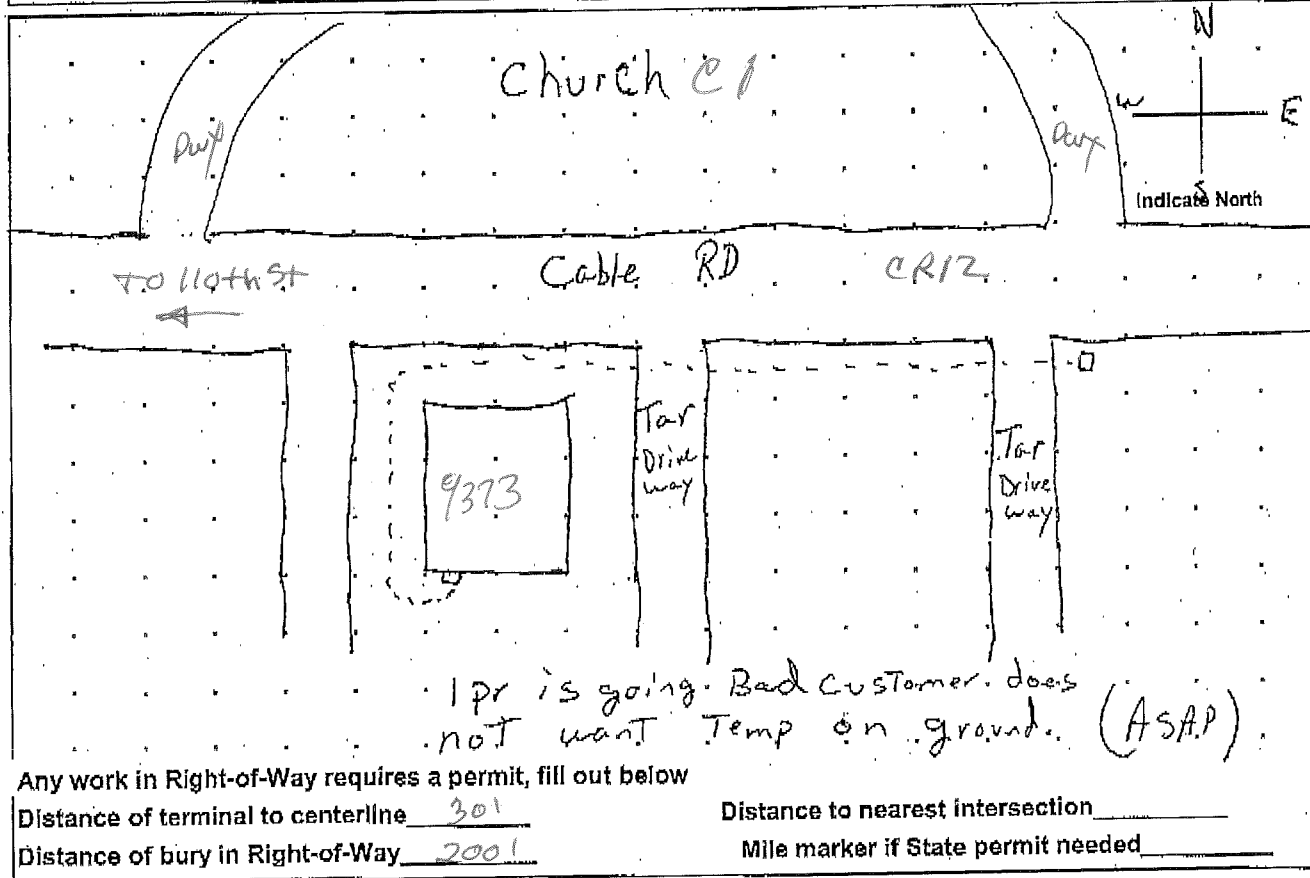

Any work in Right-of-Way requires a permit, fill out below
 Distance of terminal to centerline 301 Distance to nearest intersection _____
 Distance of bury in Right-of-Way 2001 Mile marker if State permit needed _____

Road Push Permit Required Hand Dig (Note: Hand Dig Must be 12")

8/22 Morrison County