


GENERAL LOCATION ONLY. DO NOT USE TO LOCATE FOR EXCAVATION. CALL 1-800-252-1166 FOR ONSITE LOCATIONS AND STAKING.

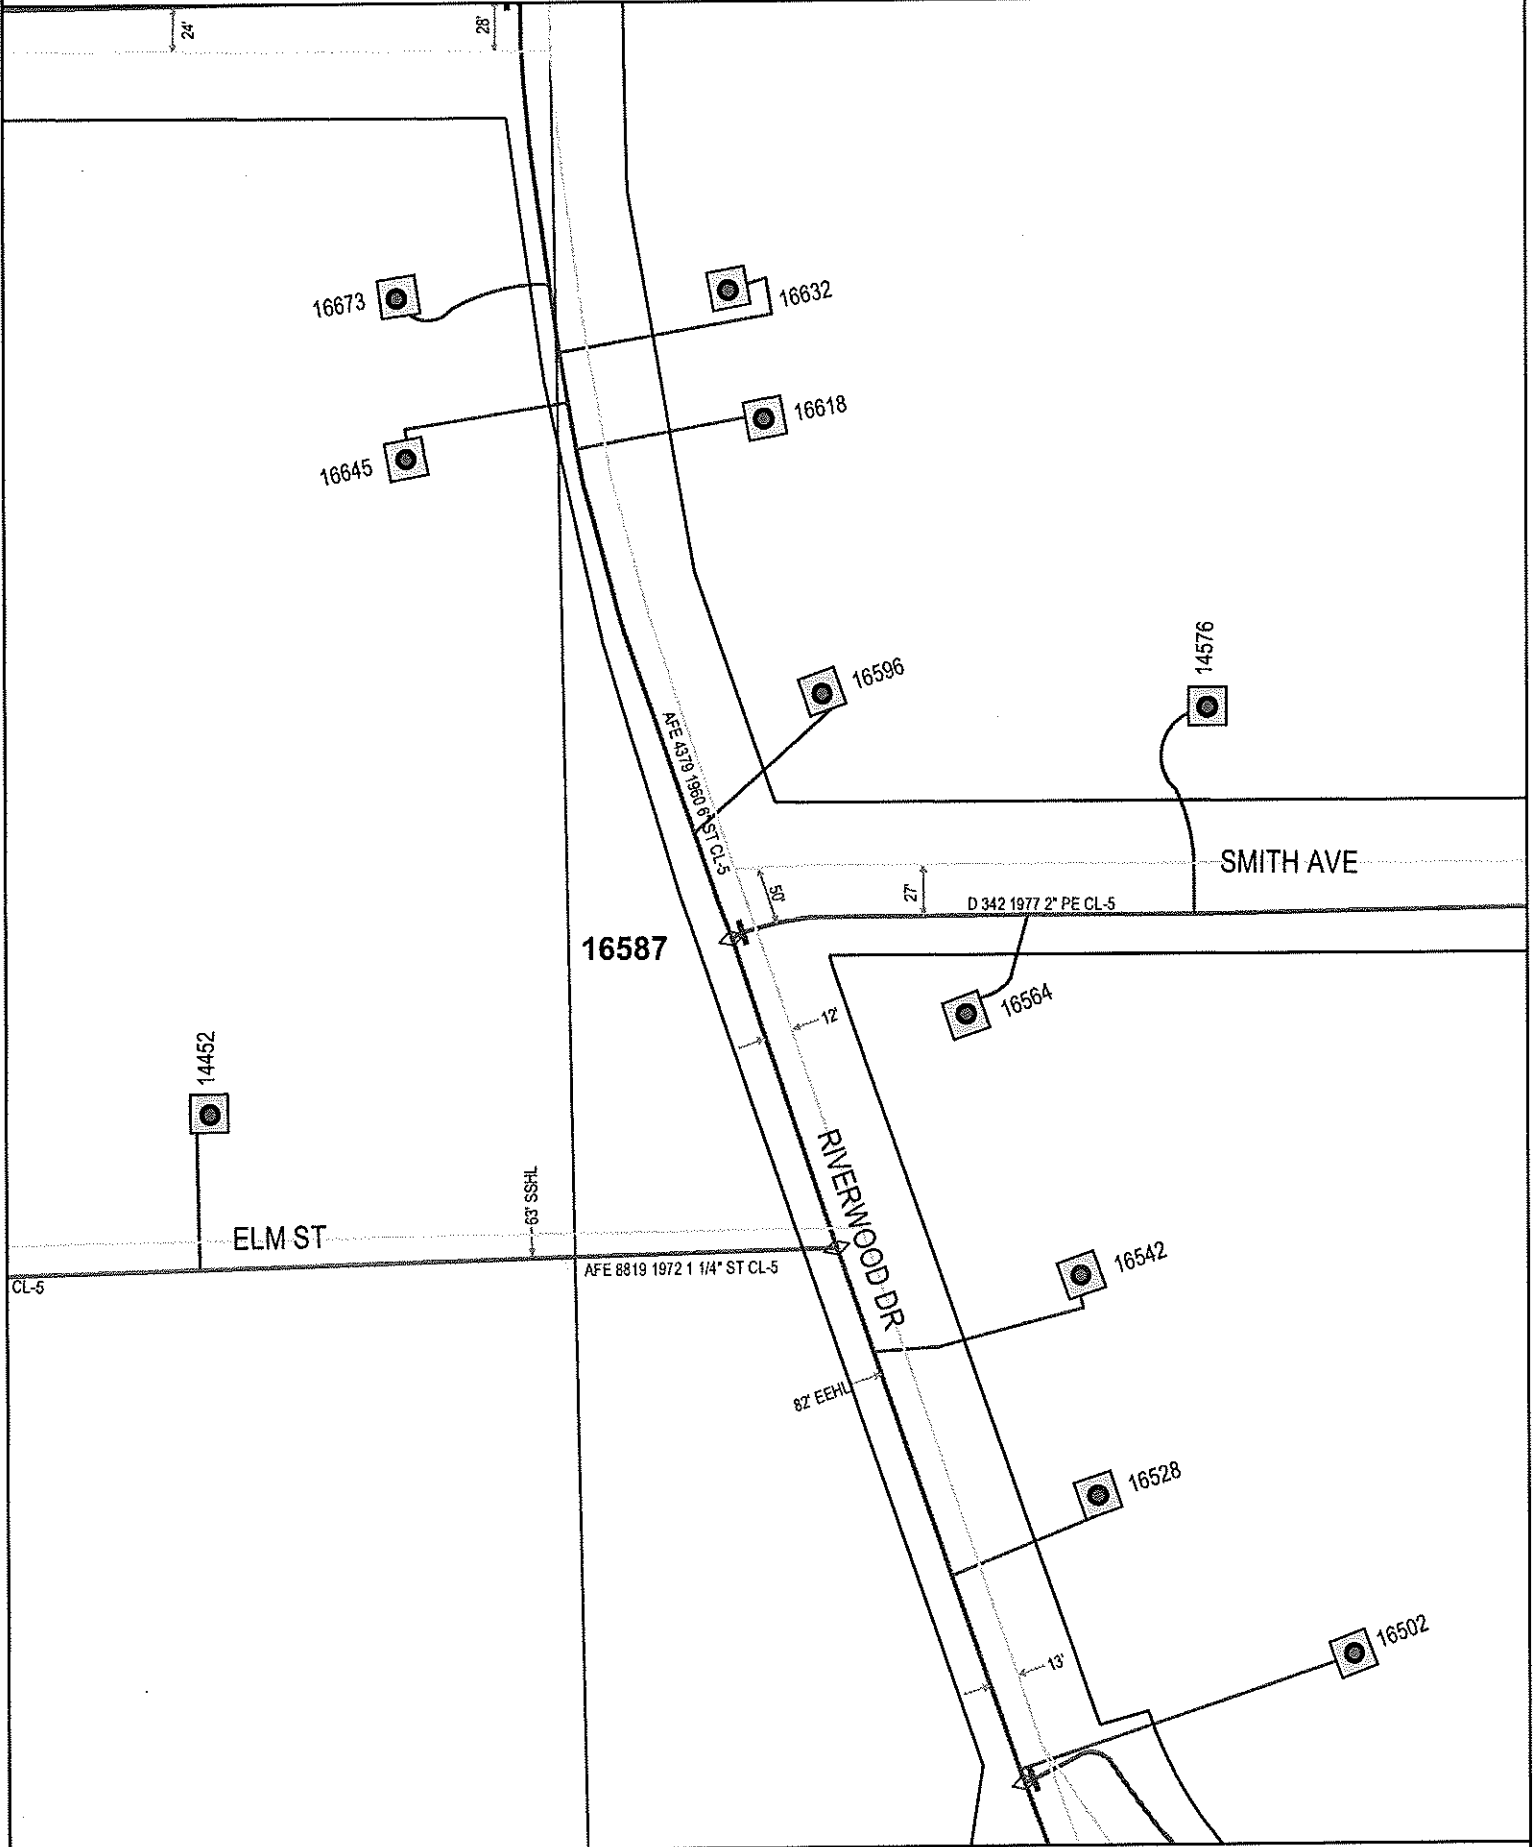

Plotted by: I216608
Plot Date: 9/19/2011

16587 RIVERWOOD DR (AKA CR260)
LITTLE FALLS, MN 56345

Scale: 1" : 100'

