


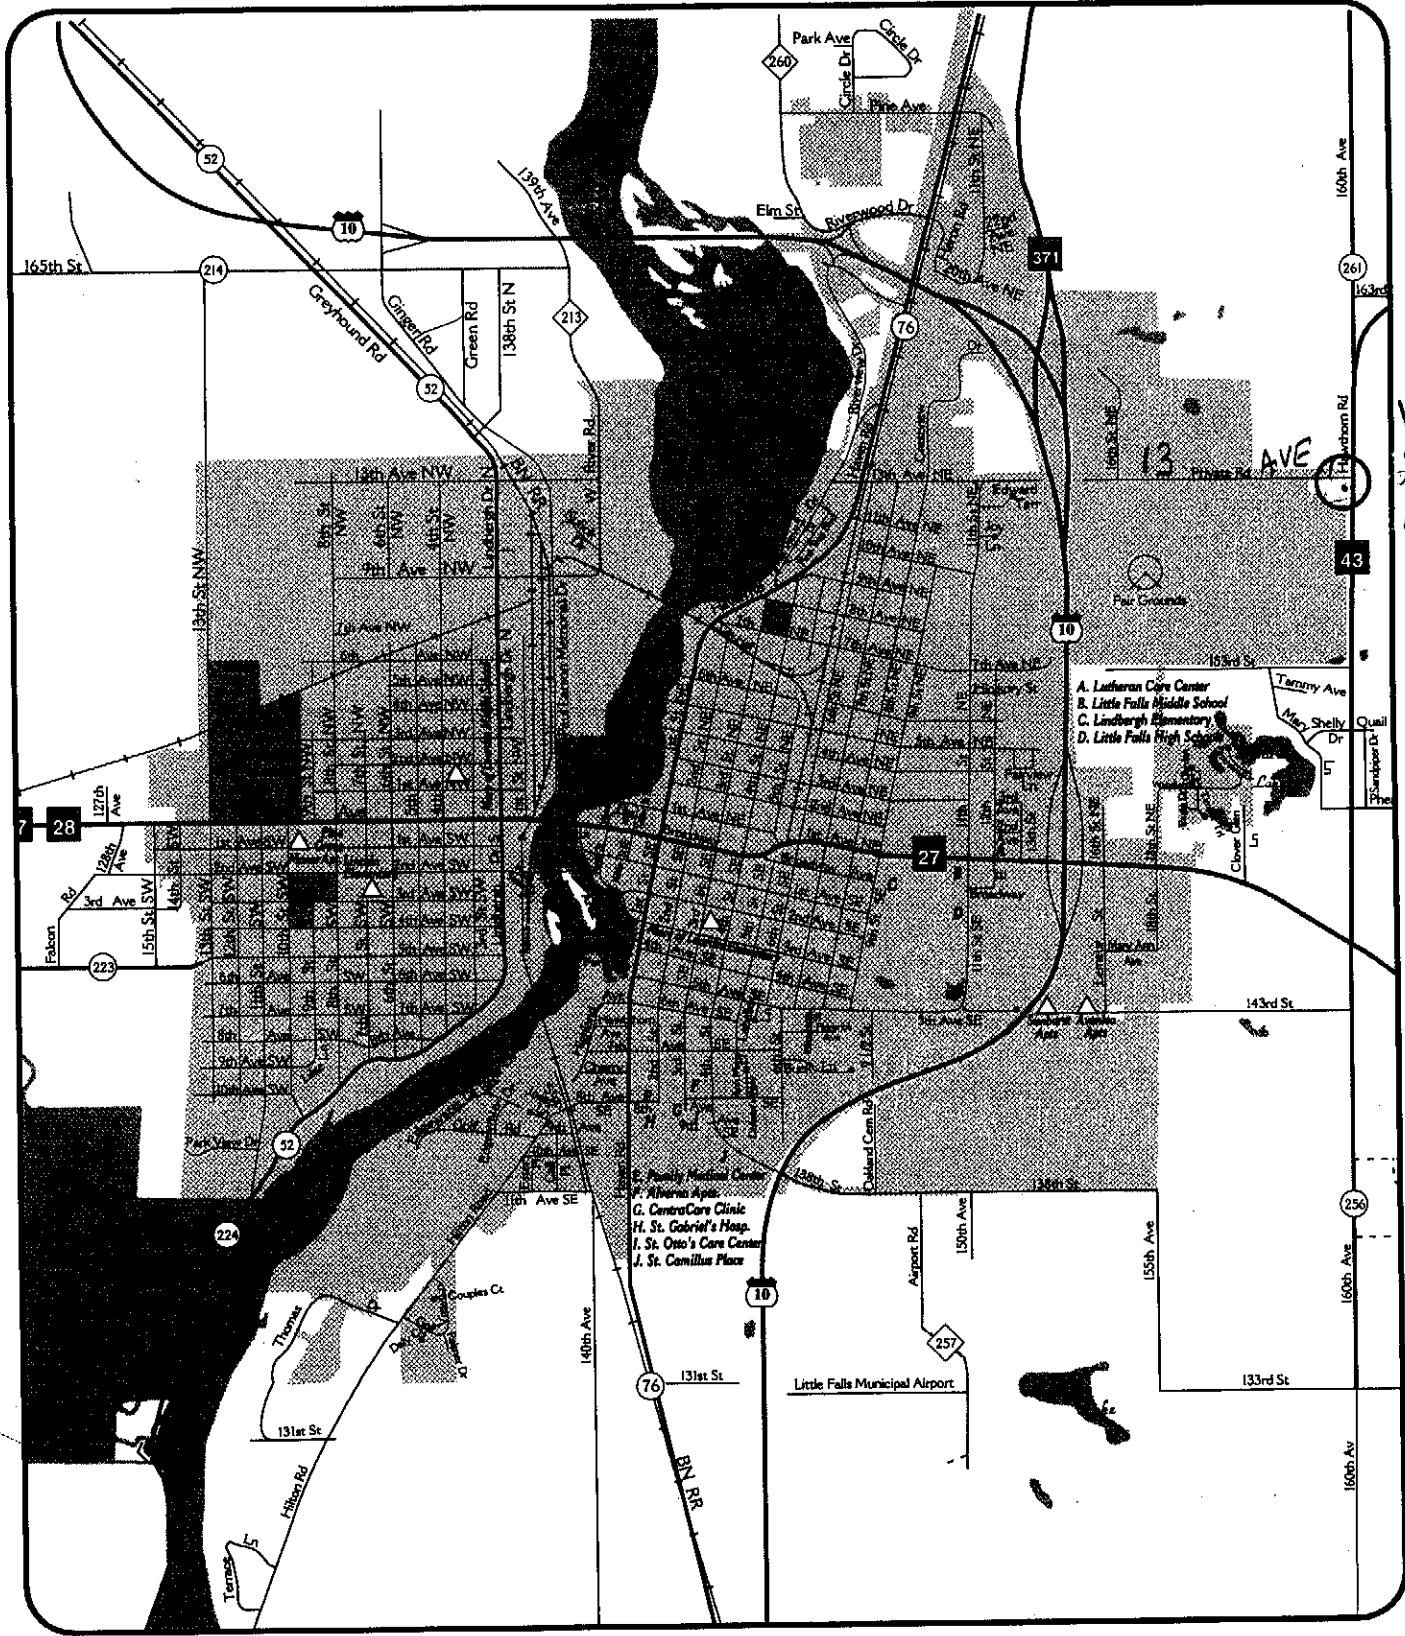

CITY OF LITTLE FALLS




WORK AREA
6'x6'x3'
PIT



BELLE PRAIRIE

T41N / R32W & R31W

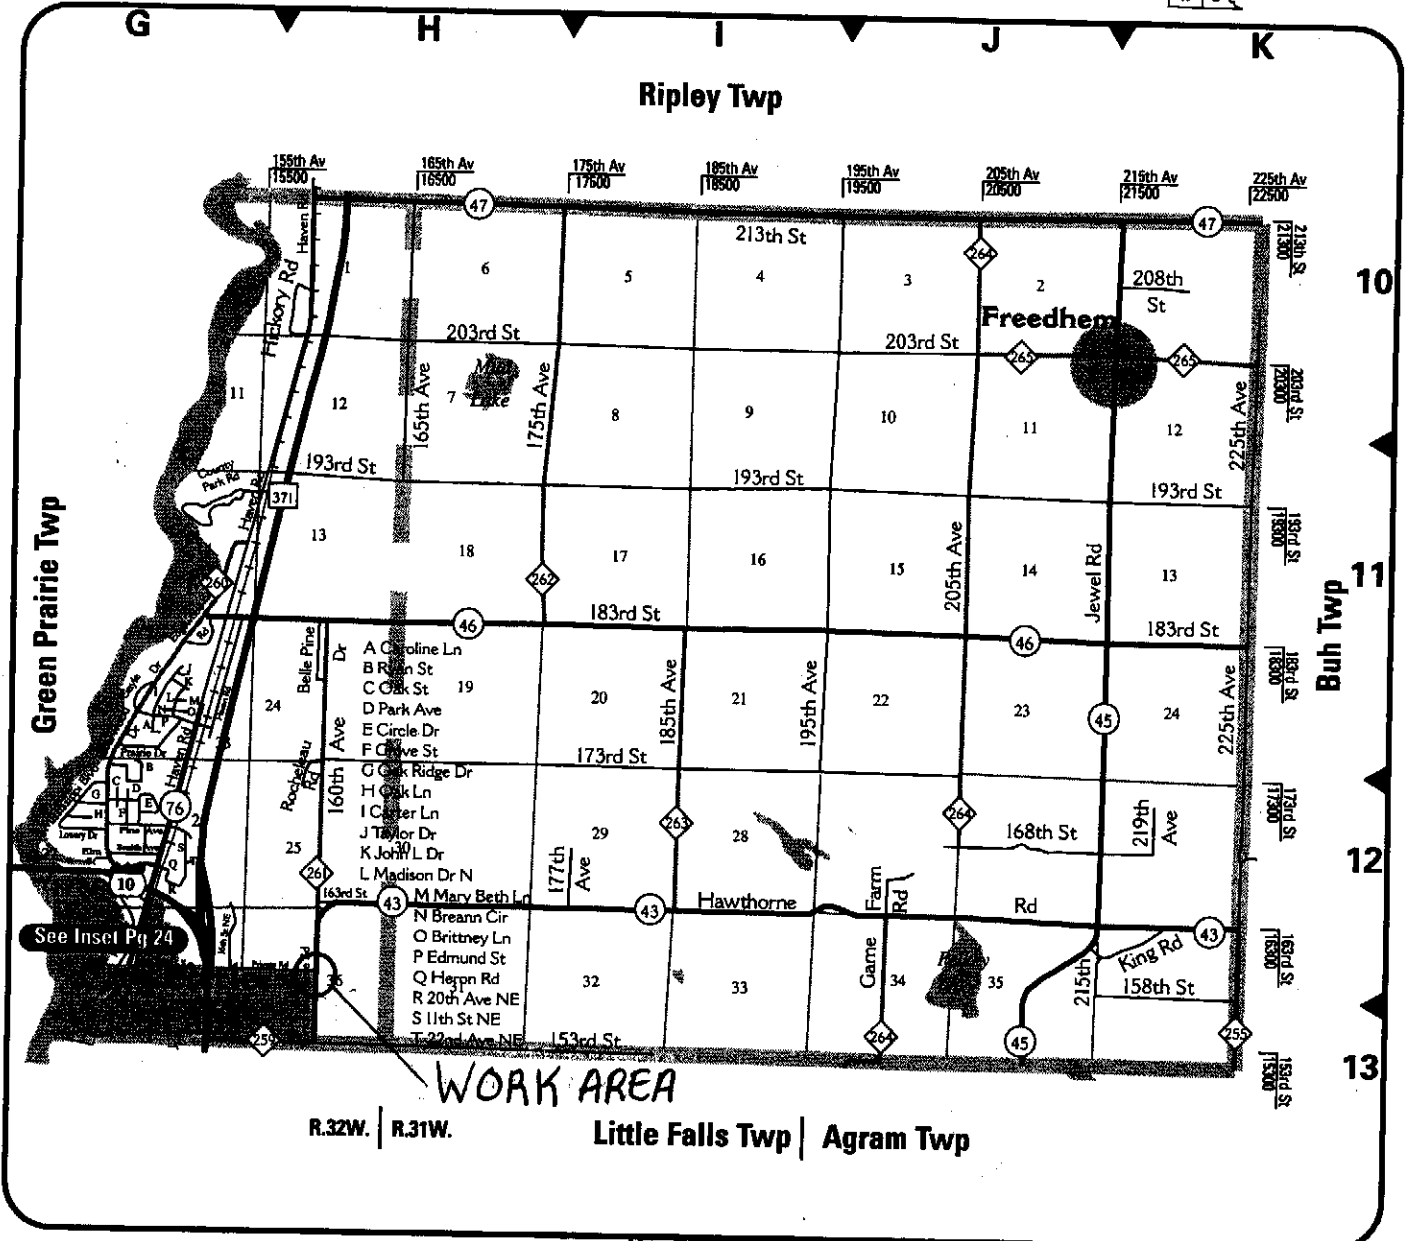

Road Index

11th St NE G 12	20TH AVENUE G 12	EDGEWOOD RD H 11	MARY BETH LN G 11
153RD ST H-I 13	22ND AVE NE G 12	EDMUND ST H 12	MISSISSIPPI BLVD G 12
158TH ST K 13	203RD ST H-K 10	ELM ST G 12	OAK LN G 12
160TH AVE H 11-13	205TH AVE K 10-12	GAME FARM RD J 12	OAK RIDGE DR G 12
163RD ST H 12	208TH ST K 10	GAYLE DR H 12	OAK ST G 12
165TH AVE I 10-11	215TH AVE K 13	GROVE ST G 12	PARK AVE G 12
168TH ST K 12	219TH AVE K 12	HAVEN RD H 12	PINE AVE H 12
173RD ST H-J 12	225TH AVE K 10-12	HAWTHORN RD H12-13	PRAIRIE DR H 12
175TH AVE I 10-11	BELLE PINE DR H 11	HERON RD G,H 11-12	RIVERVIEW DR G 13
177TH AVE I 12	BREANN CIR G 11	HICKORY RD H 10	RIVERWOOD DR G 12
183RD ST H-K 11	BRITNEY LN G 11	JEWEL RD K 11	ROCHELEAU RD H 12
185TH AVE J 11-12	CAROLINE LN H 12	JOHN L DR G 11	RYAN ST G 12
16TH AVE NE G 12	CARTER LN G 11	KING RD K 12	SMITH AVE G 12
193RD ST H-K 11	CIRCLE DR H 12	LOWERY DR G 12	TAYLOR DR G 11
195TH AVE J 10-12	COUNTY PARK RD H 11	MADISON DR G 11	