


Rebuild existing three-phase power line. New line will be built on the east side of Balcony Rd. The existing power line (located on west & east side) will be removed.



SWN 1

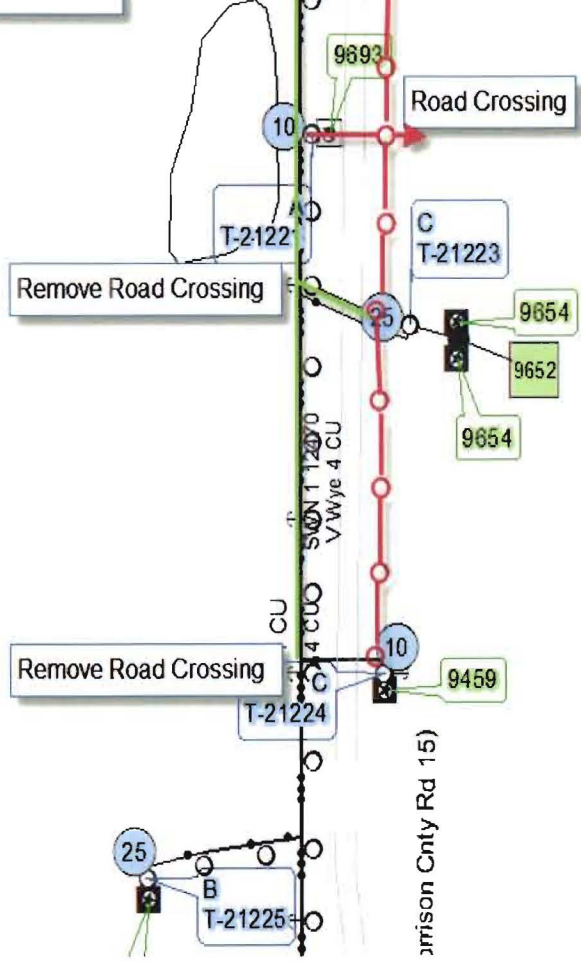