




DISTANCE FROM & ROAD: **SEE NOTATION**
 STAKED BY: **JDB** DATE: **8-4-11** REV: **1**
 PROJECT: **MIN37-2012** TOWNSHIP: **STANISLA VALLE-1**
 EXCHANGE: **LINCOLN** CO. **MORRISON**
 AS BUILT BY: DATE: **8-4-11** REV: **1**

THP: **132 N** ROUTE: **3D3C**
 RING: **3D W** SHEET: **1** OF **4**
 SEC: **31** SERVICE AREA: **LINCOLN**

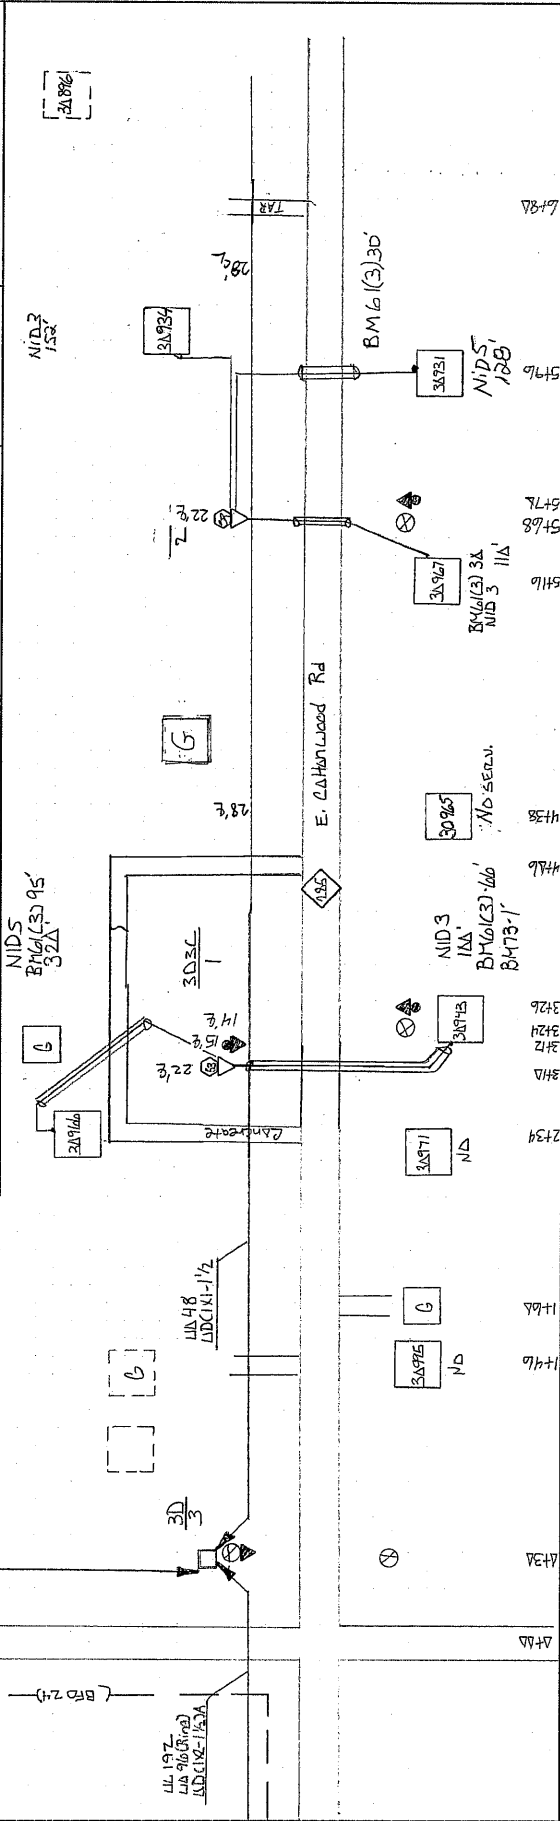

HOUSING NO.	BA	BDO	BFO	BH	BM	HBFB	HO	NID	SUB NO.	SE	UD	UO
1			5 (514)		2 (514)	73	1	3		B 4		4B
			1		1	666 95	2	1	30943 30946	100 320		297 414
2			1		1	20 20	3	1	30947 30931 30934	110 120 152		270 394
			2		2	221 1	5	3				567 834

DISTANCE FROM C ROAD			TWP <u>132</u> N	ROUTE <u>3D3C</u>
SEE NOTATION			RING <u>3D</u> W	
STAMPED BY: <u>EJB</u>	DATE: <u>8-4-11</u>	PROJECT: <u>MIN637-2012</u>	SEC: <u>31</u>	SHEET: <u>3</u> OF <u>4</u>
REV.	REV.	EXCHANGE: <u>LINCOLN</u>	CO. <u>MORRISON</u>	SERVICE AREA: <u>LINCOLN</u>
AS BUILT BY:	DATE:	TOWNSHIP: <u>SANDRIDGE VALLEY</u>		

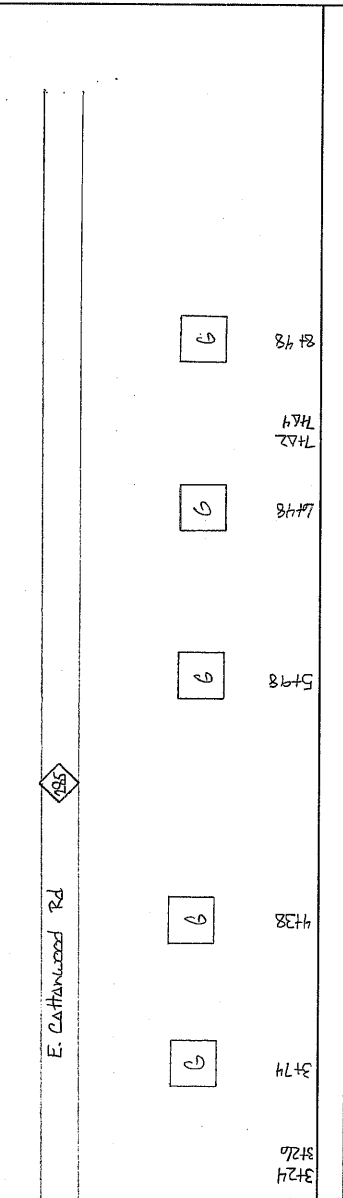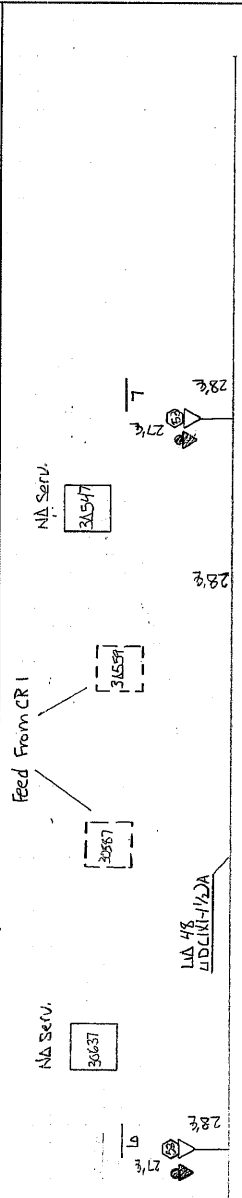

ROWING NO.	BA	BDO	BFO	BH	BM	HBFB	HO	NID	SUB NO.	SE	UD	UO
1			5 (SCL)		2 (SCL)		1					418
2			1		1		Loop					537
3			1		1		Loop					508
4			2		2							1040

7128	1472	184	2484	3424	3474	438	5498	8448	8478	742	8448	8478

CTC


SEE NOTATION

PROJECT: MNS37-2012
 EXCHANGE: LINCOLN
 TOWNSHIP: SCANSIA VALLEY

DATE: 8-4-11
 REV.
 AS BUILT BY:

TRIP: 132 N
 RING: 30 W
 SEC: 31
 CO: MORRISON

ROUTE: 3032
 SHEET: 4 OF 4
 SERVICE AREA: LINCOLN

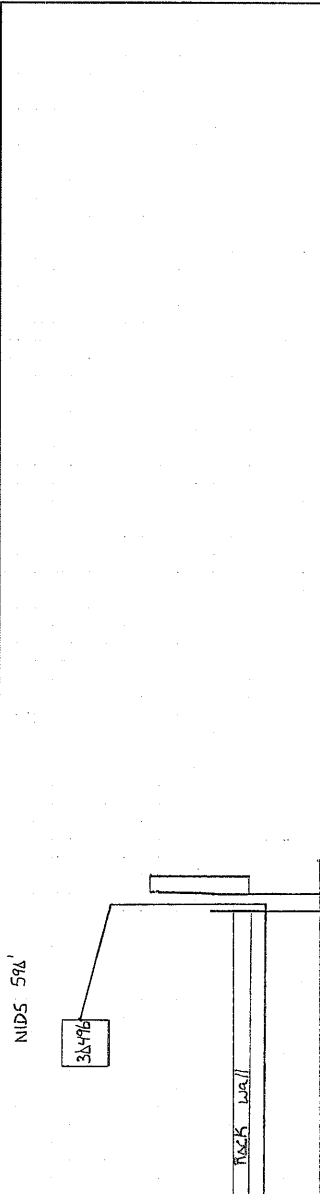

8446	[G]	118	H74	H74	1494	2776	8424	3476
	[G]							
	[G]							

Private Power

[G] [G] [G] [G]

HOUSING NO.	BA	BDO	BFO	BH	BM	HBFB	HO	NID	SUB NO.	SE	UD	UO
			5 (51x5)		2 (51x5)		1	5		84		478
									30536	224		
			1		1		2	1	304906	590		478
			1		1		2	2		814		478

Approved By: GIS 3/6/09

DISTANCE FROM Q ROAD
SEE NOTATION


CTC

PROJECT: MN537-2012
EXCHANGE: LINCOLN
TOWNSHIP: SLEASDIA VALLEY


DATE: 8/11
REV: []
AS BUILT BY: []

TWP 132 N
RNG 30 W
SEC 31
CO. MORRISON

ROUTE: 368A
SHEET: 3 OF 3
SERVICE AREA: LINCOLN

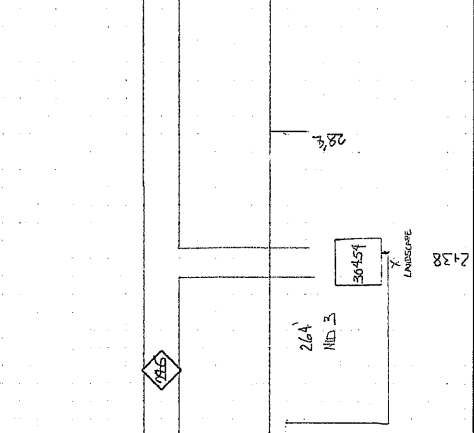

ON	BA	BDO	BFO	BH	BM	HB	HBF	HO	NID	SUB NO.	SE	UD	UO
4		4 (510)	24	7 (510)	53			1	3		B 4		
		1	410	1	1			3	1	204416	210		
									1	30454	264		
									1	30476	350		
		1	410	1	1			3	2		274		

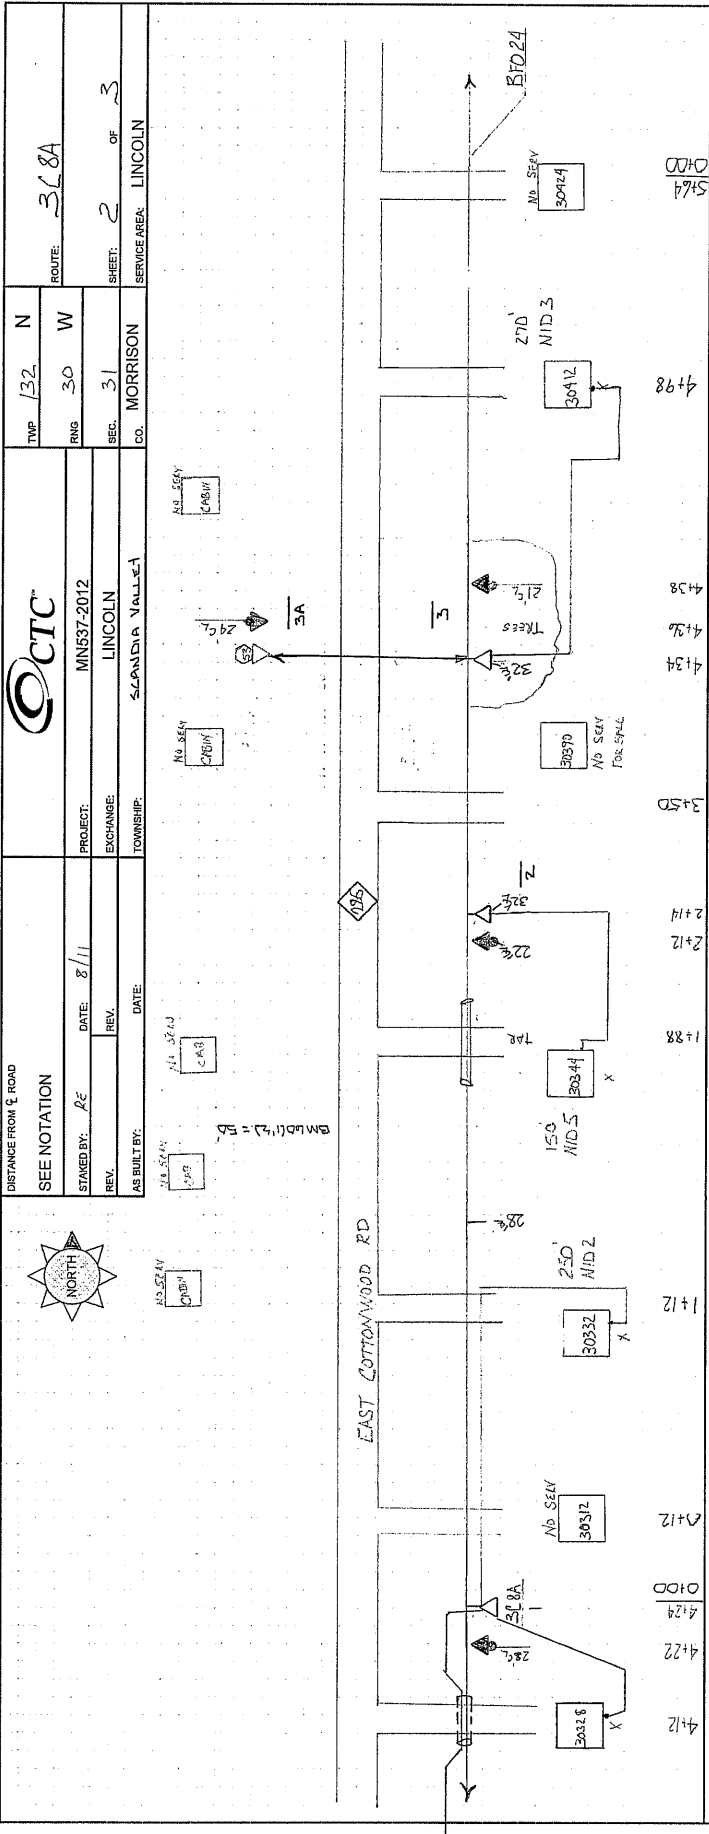

HOUSING	BA	BDO	H	BFO	Z4	BH	BM	53	50	L ^d	HBFB	HO	NID	SE	UD	UD	S44	
																	UO	UO
Z			1				1					1	3	B			(N1-1/2) A	Z4
3			1				1		50			2	1	150				
3A			1				1					2	1	270			78	177
							3	1	50			3	1	170			78	177

