

Project: E.301746

WC NAME: SWANVILLE

WC ID: SWVLANSV

Design Eng: Ben Buchholz

Telephone: 3202558533


Issue:

Issue Date:

Plot Ref.:

CONFIDENTIAL. Disclose and Distribute
Solely To CenturyLink Employees Having
a Need to Know.

Reason for Reissue:

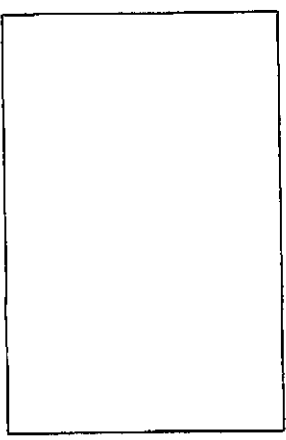


34' from c/l

Depth: 48'

BALCONY RD


COUNTY HWY 15

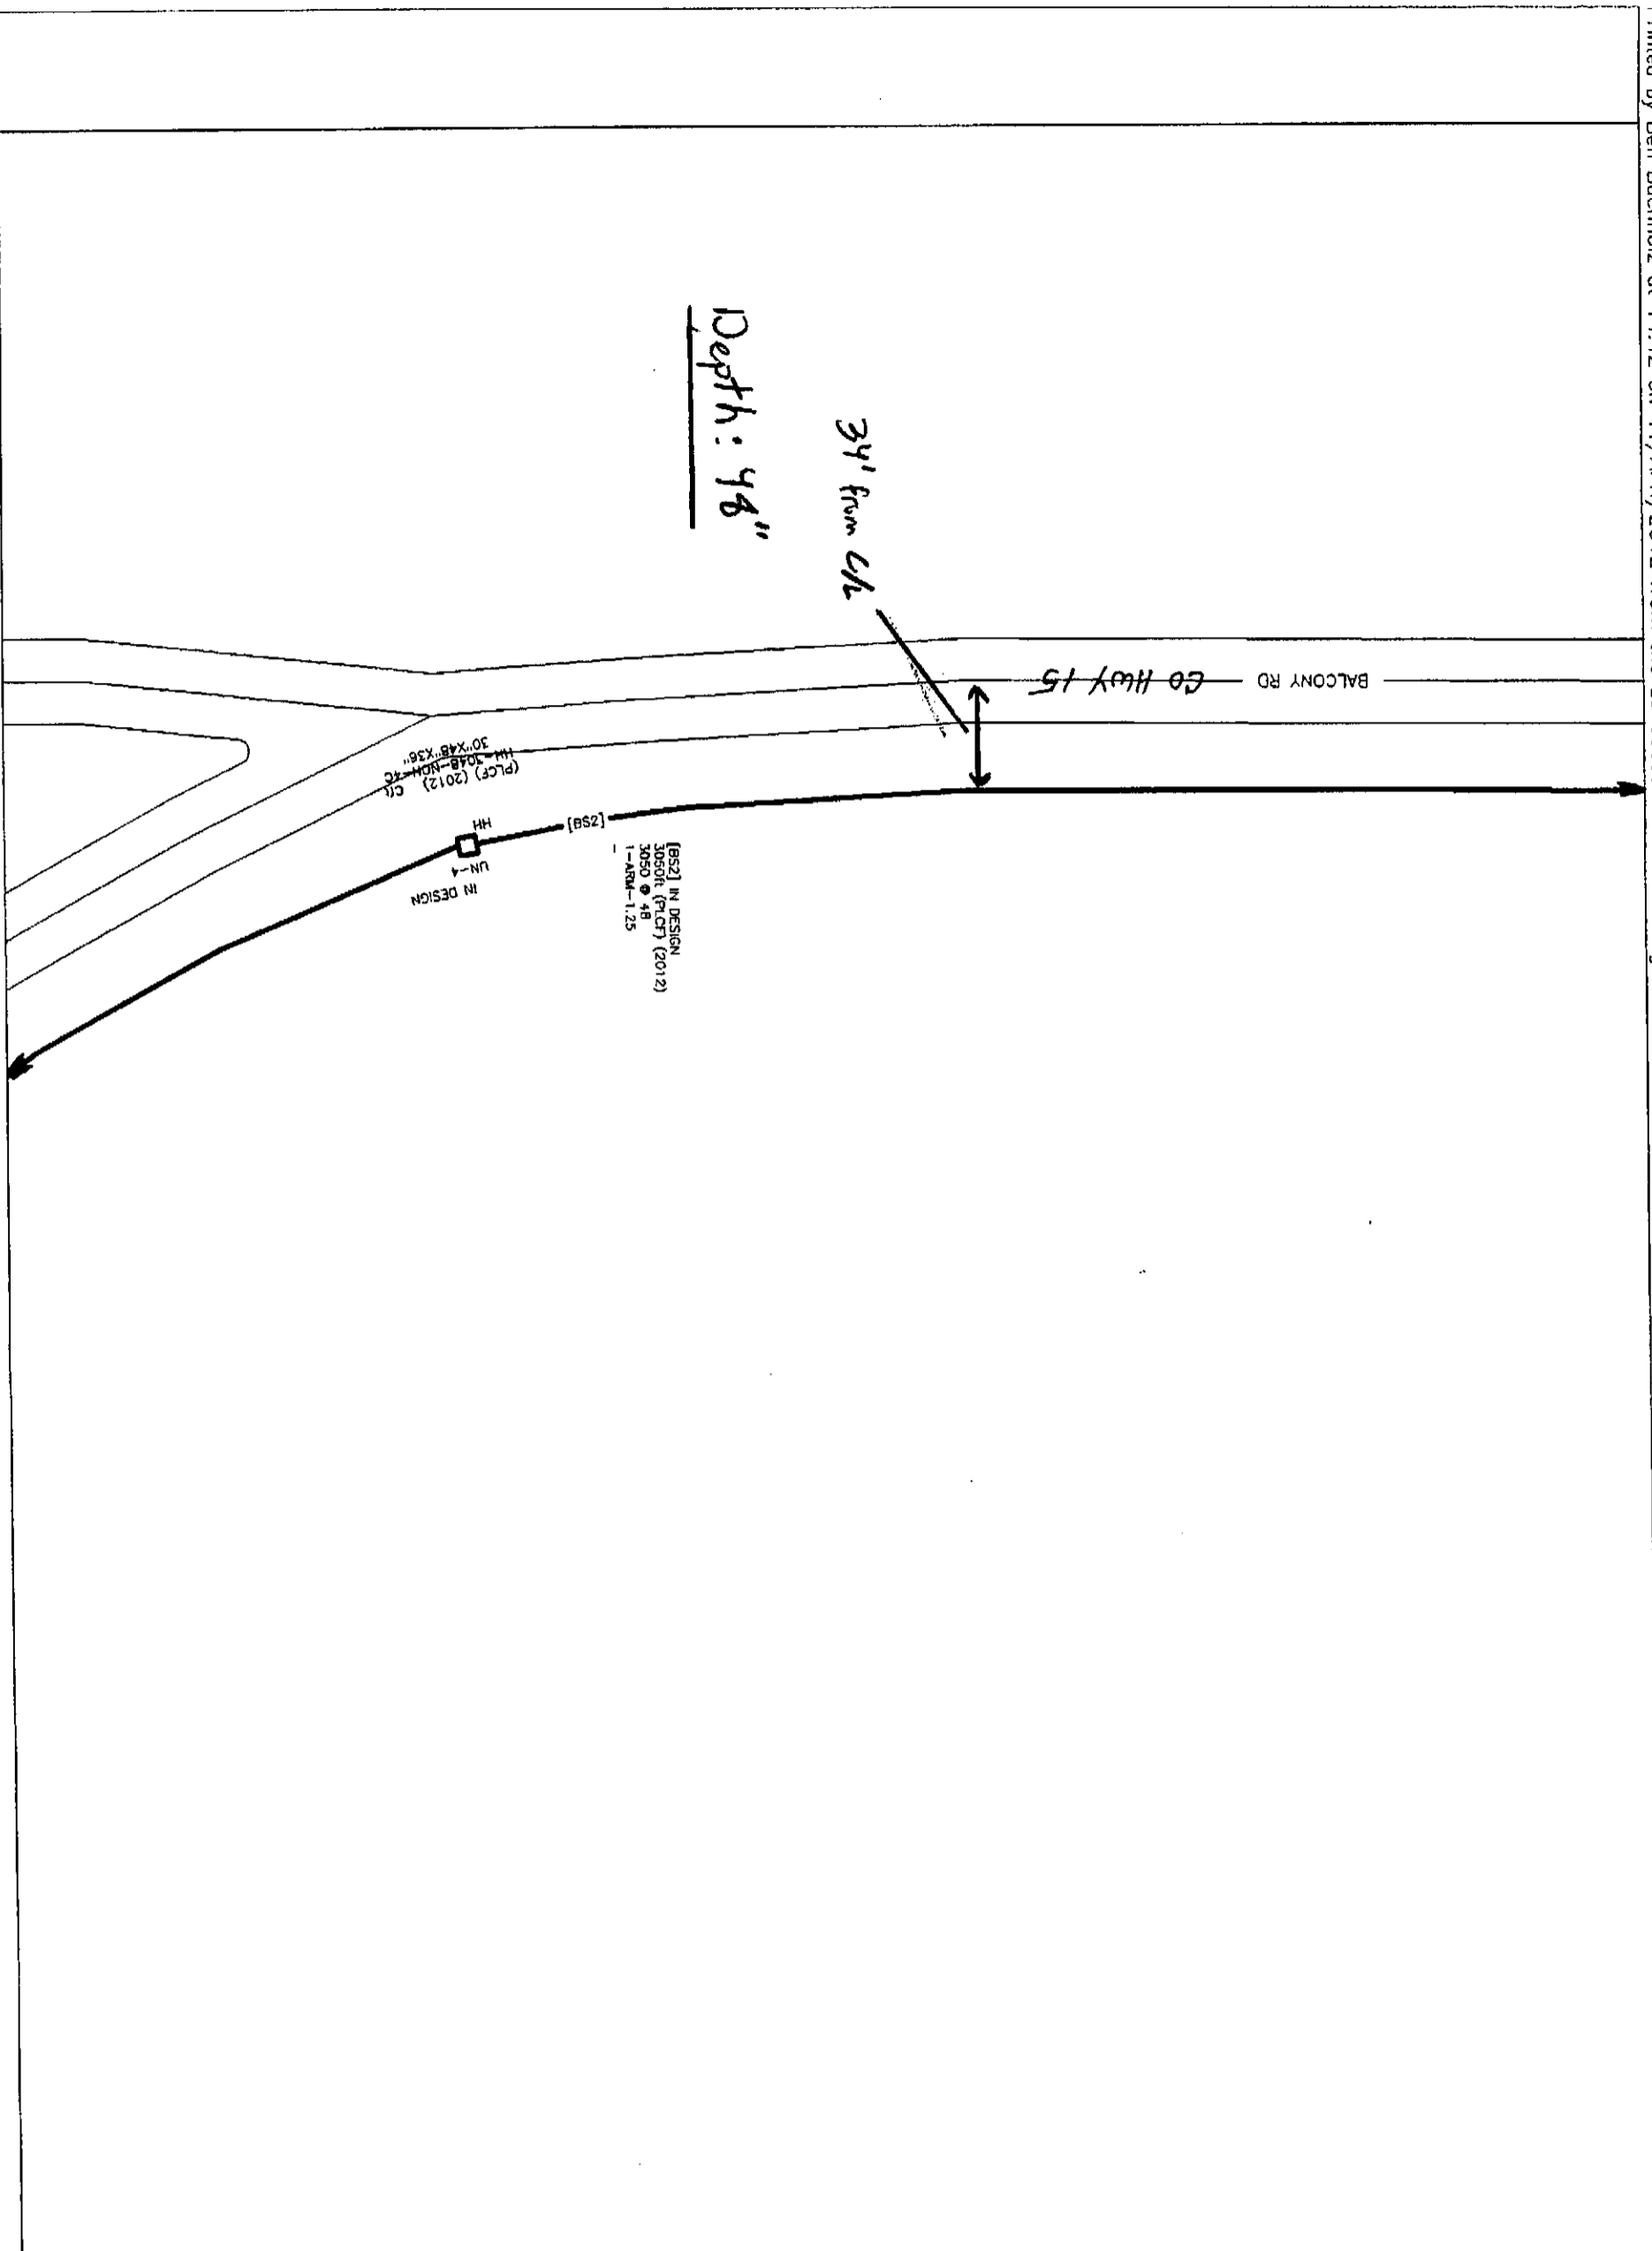

Project: E.301746
WC NAME: SWANVILLE
WC ID: SWMLANSY
Design Eng: Ben Buchholz
Telephone: 3202558333
Issue:
Issue Date:
Plot Ref.:

CONFIDENTIAL. Disclose and Distribute
Solely To CenturyLink Employees Having
a Need to Know.
Reason for Reissue:

Scale: 1" = 75'
Sheet: 018 of 1

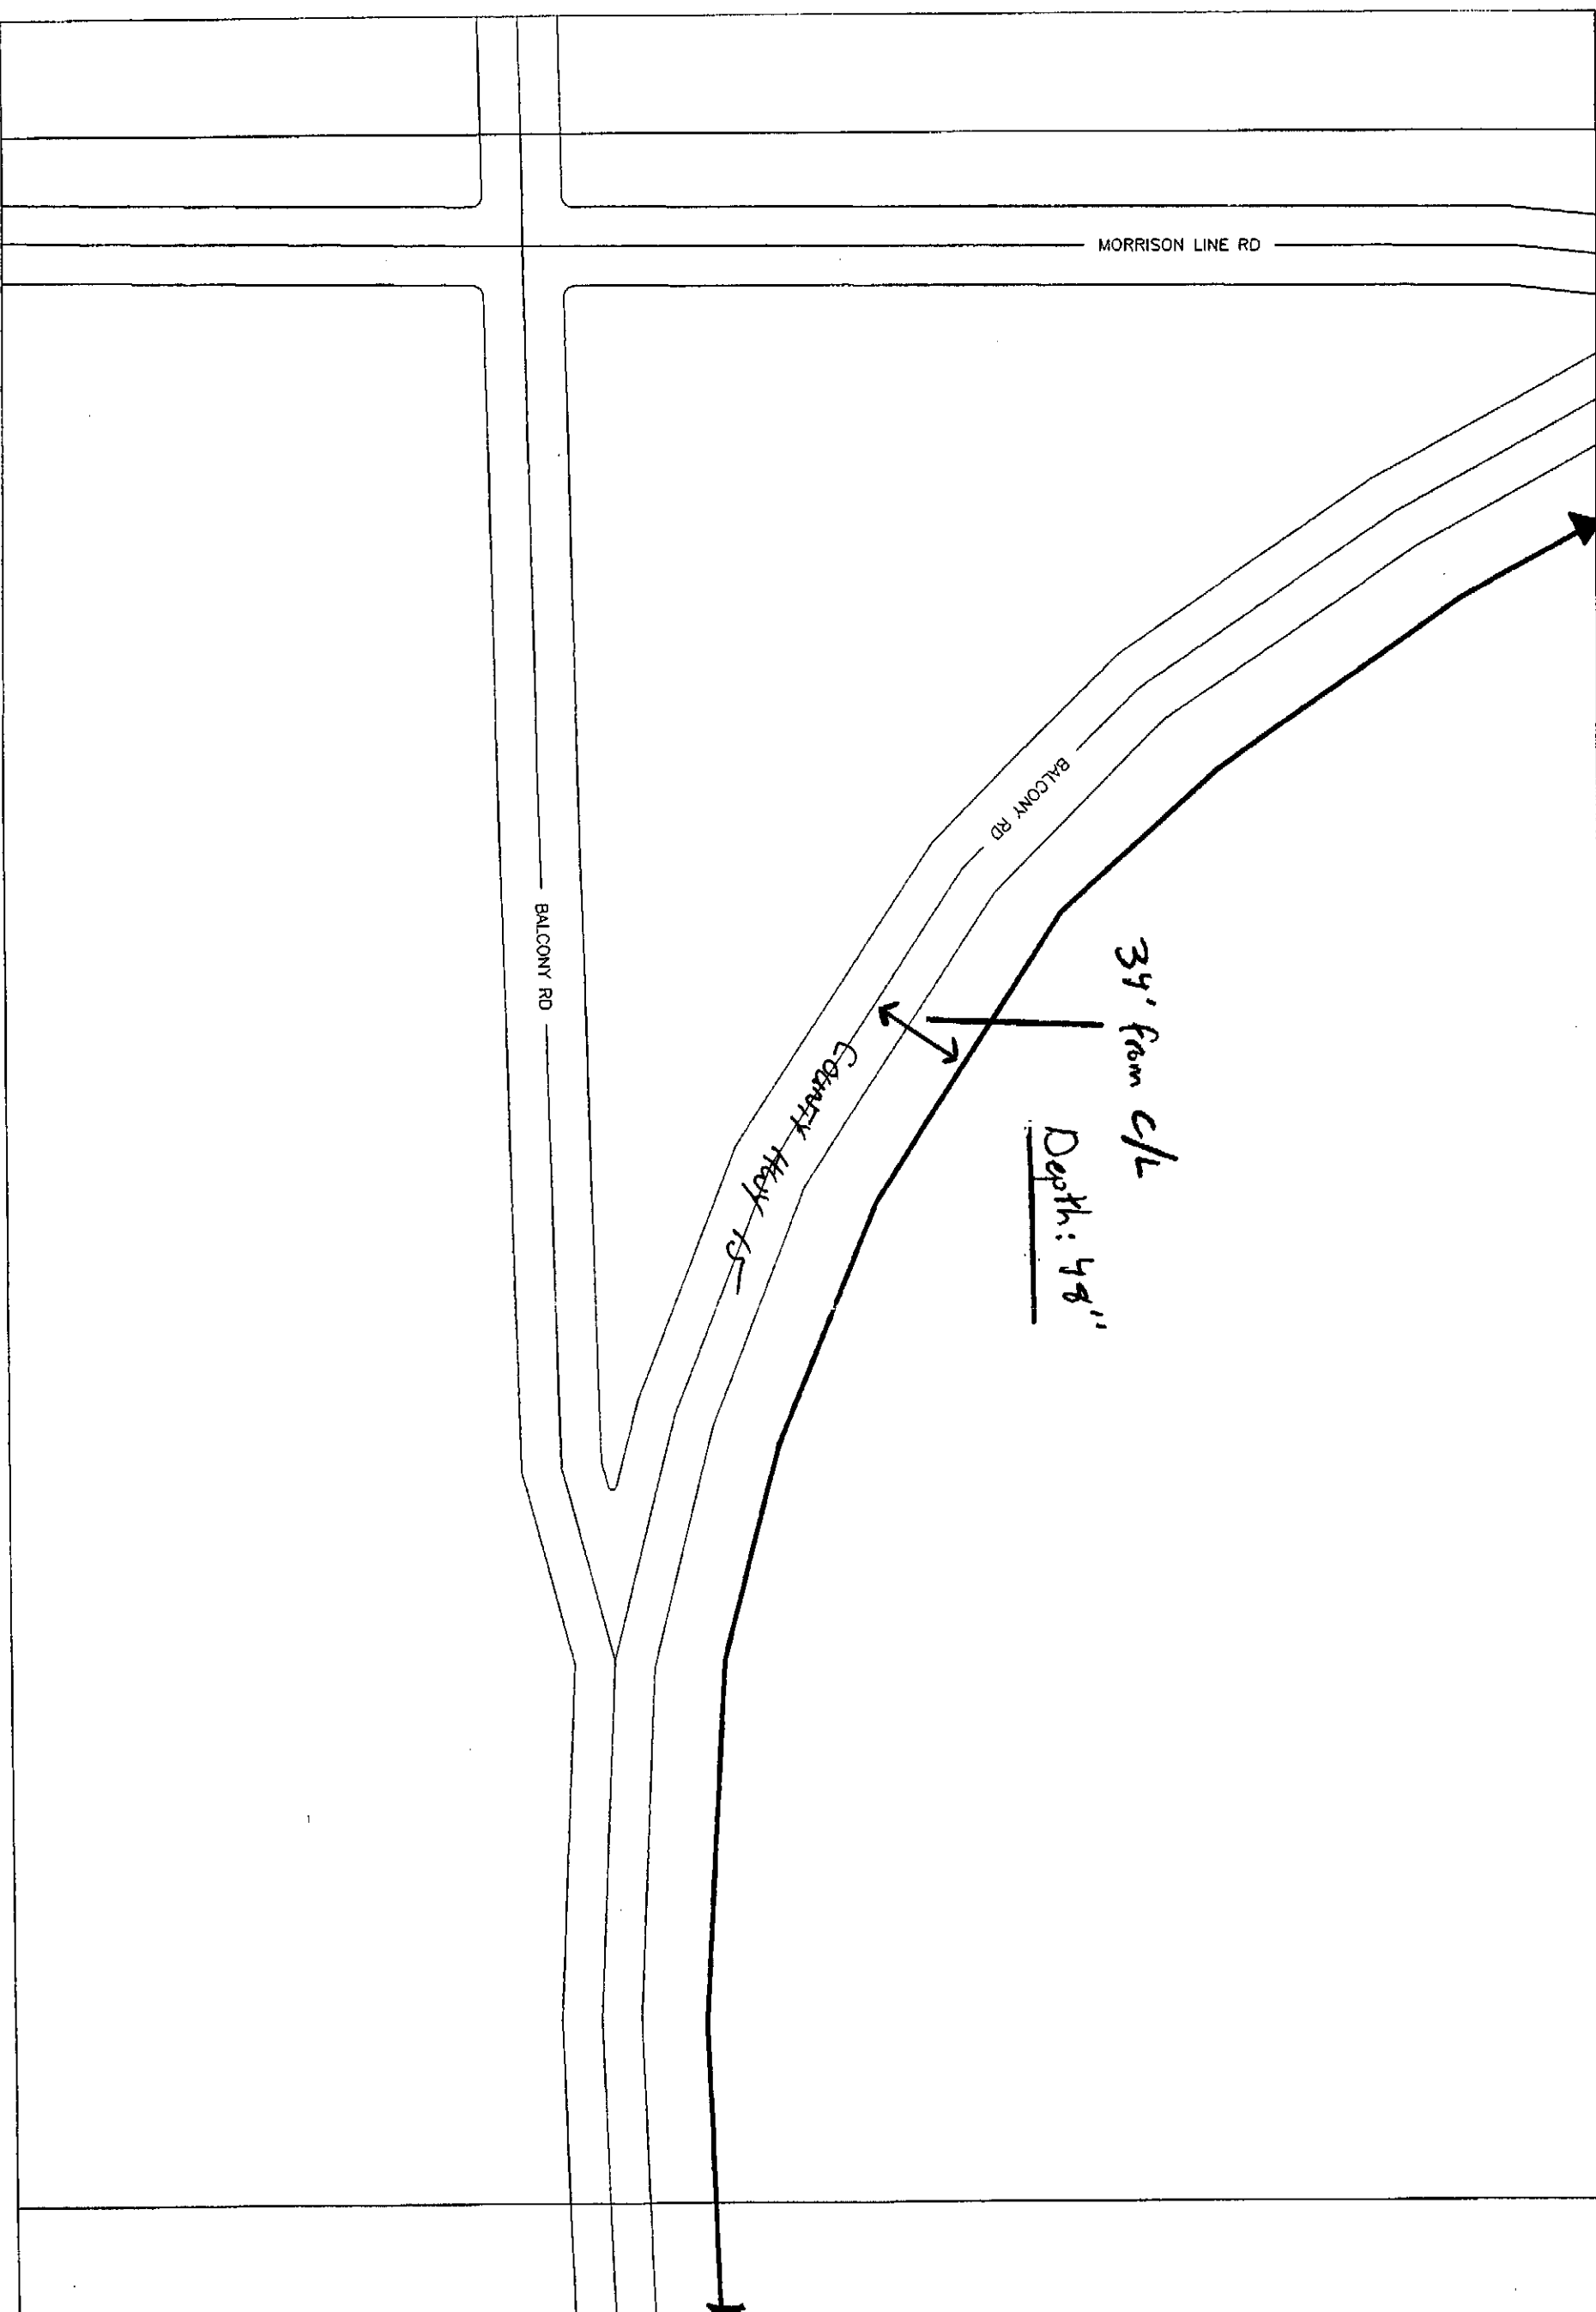

Project: E.301746
WC NAME: SWANVILLE
WC ID: SWILMINSV
Design Eng: Ben Buchholz
Telephone: 3202558533
Issue:
Issue Date:
Plot Ref.:

CONFIDENTIAL. Disclose and Distribute
Solely To CenturyLink Employees Having
a Need to Know.

Reason for Reissue:

Project: E.301746
WC NAME: SWANMILE
WC ID: SWANLANSV
Design Eng: Ben Buchholz
Telephone: 320258533

Issue:
Issue Date:
Plot Ref.:

CONFIDENTIAL. Disclose and Distribute
Solely To CenturyLink Employees Having
a Need to Know.
Reason for Reissue:


[BS3] IN DESIGN
1750 (PLCF) (2012)
1-ADM-48
1-ADM-125


COUNTY HWY 15

BALCONY RD

3y' from C/L

Depth: 48"

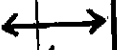

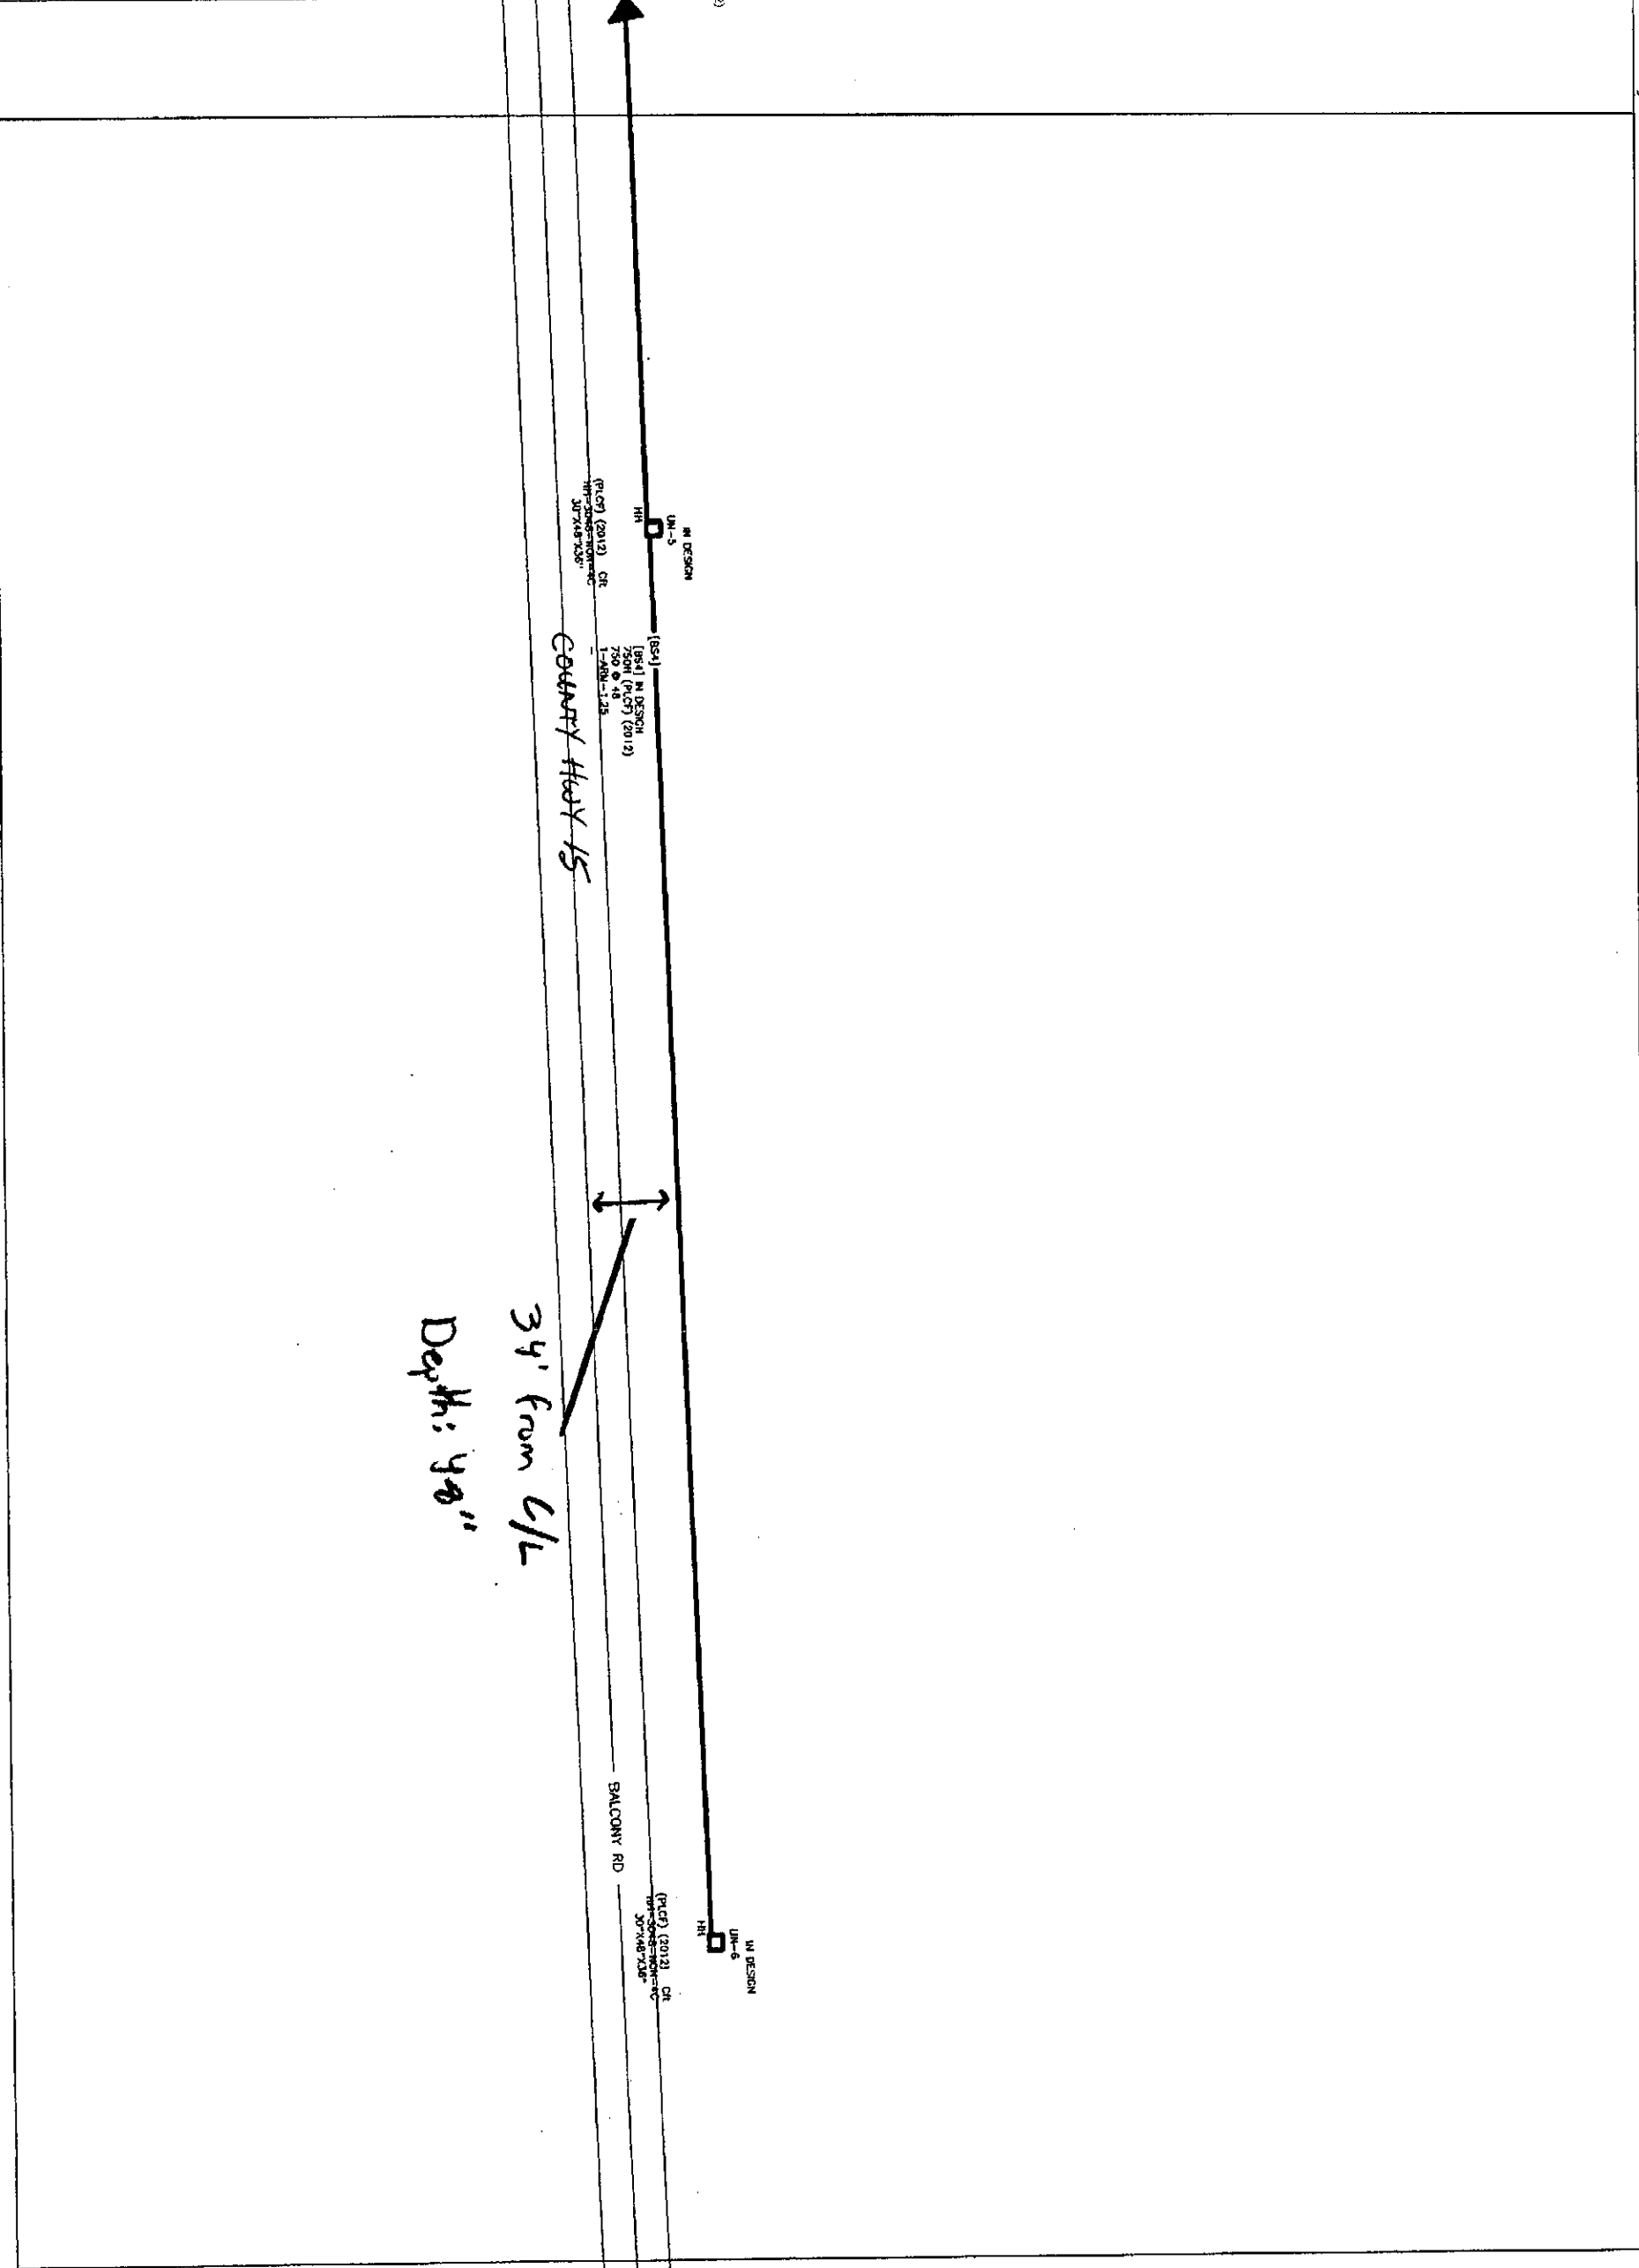

Project: E.301746
 WC NAME: SWANVILLE
 WC ID: SWMLANSV
 Design Eng: Ben Buchholz
 Telephone: 3202558333
 Issue:
 Issue Date:
 Plot Ref.:

CONFIDENTIAL. Disclose and distribute
 solely to CenturyLink Employees Having
 a Need to Know.

Reason for Reissue:

Scale: 1" = 95'
 Sheet: 021 of 1