

GAS ASBUILT

LITTLE EIK JOT

W.O. #

13-SN-LP-77-SWS-JOT LITTLE EIK (8000)

STREET ADDRESS


17801 Autumn Rd., Long Prairie  
T129N - R31W - SECT. 6

CITY/Twp

White Flag

CITY/Twp

tc = 177

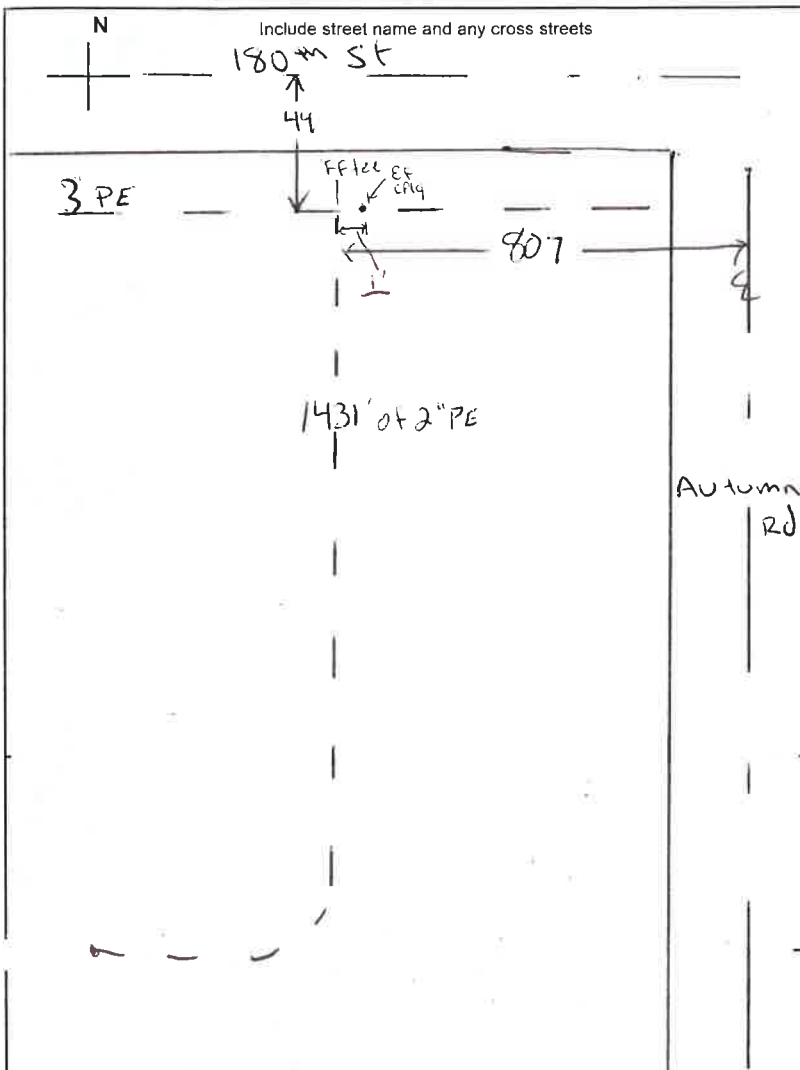

Pipe & Fitting Type  High D  Medium D

Material List	Lot #	Qty
Pipe 5/8" or 1"		
Tee 2x5/8 or 2x1		
Tee 4x5/8 or 4x1		
Tee 6x5/8 or 6x1		
EFV 5/8 or 1"		
2, 5, 10 or 12 # Meter Bar		
Cplg 5/8 or 1 or 2" (EF)	293826	1
FF tee 2"		1
5/8 or 1" ELL	Cap 5/8 or 1"	
PE Tee 5/8 or 1"	PE Reducer 5/8x1"	
2" PE	See Remarks	1431
2" Riser		1
3x2 Reducer		1
Carsonite	Anode 3#	
# of Heaters	Restoration	Y <input type="checkbox"/> N <input type="checkbox"/>

**Meter**

Locked  Unlocked

Size Nr Location \_\_\_\_\_

MFG \_\_\_\_\_ Reading \_\_\_\_\_

New Meter # \_\_\_\_\_

Reg. Type/Press. 2# 5# 10# 12#

Old Meter# \_\_\_\_\_

Old Meter Reading: \_\_\_\_\_

Does Winter Construction Apply? Y  N

Remarks:

2" HOPE @ 2' CEEASTM D2513 NR CO 2m 16 SEC 14 Aug 13 coil 0000004  
 @ middle " " NR CO 2m 16 SEC 14 Aug 13 coil 0000015  
 @ Riser " " NR CO 2m 16 SEC 14 Aug 13 coil 0000005

**Condition of Existing Pipe**

	Outside	Inside	Coating
Good	<input type="checkbox"/>	<input type="checkbox"/>	<input type="checkbox"/>
Fair	<input type="checkbox"/>	<input type="checkbox"/>	<input type="checkbox"/>
Bad	<input type="checkbox"/>	<input type="checkbox"/>	<input type="checkbox"/>

Anode # \_\_\_\_\_ MV Reading \_\_\_\_\_

Existing Main	
Size <u>4</u> Pressure <u>100</u> Type/Mfr <u>Dura-Line</u>	
Lot # _____ Cover <u>36</u> Location _____	
New Service / Main	
Size <u>2</u> Lot # <u>See Remarks</u>	
Poly Mfr <u>Dura-Line</u> Nature of Soil <u>sandy</u>	
Tap Size <u>FF</u> Cover <u>30</u> Completion Date <u>9-5-13</u>	
Foreman ID <u>5578</u> Welder/Fuser ID <u>7945</u>	
Pressure Test	
Test With: <u>(Air) &amp; (Nitrogen)</u> Duration <u>30</u> Emp ID <u>7945</u>	
Date Tested <u>9</u> PSI <u>154</u> Soap Test Final Tie-in? Y <input checked="" type="checkbox"/> N <input type="checkbox"/>	
Filled out by Mapping Dept.	
Mapped in System Maps _____ Date _____	
Mapped in GIS _____ Date _____	
Entry Person _____ Date _____	
GSOC Polygon Available Yes <input type="checkbox"/> No <input type="checkbox"/>	

Description	Install Footage
Directional Bore	
Pneumatic Bore	
Backhoe	
Inserting	
Trench	
Plow	1431
Hand Digging	
Joint Trench	
Gopher Pipe	
Cust. Perf. Loc.	

Permit Required Y  N

updated 8/12/2013

Final  
as built - SS  
Morrison County