

**GAS ASBUILT**


STREET ADDRESS

of Morrison Line Rd 132602304 W.O. # 13-SC-SW-81-SWS-5108  
 9658 10th Ave. 9-19 (L/S) CITY/Twp  
 T128N/31N/SEC18 CITY/Twp

**White Flag**

Flagged 9/6 C.S.

Pipe & Fitting Type  High D  Medium D

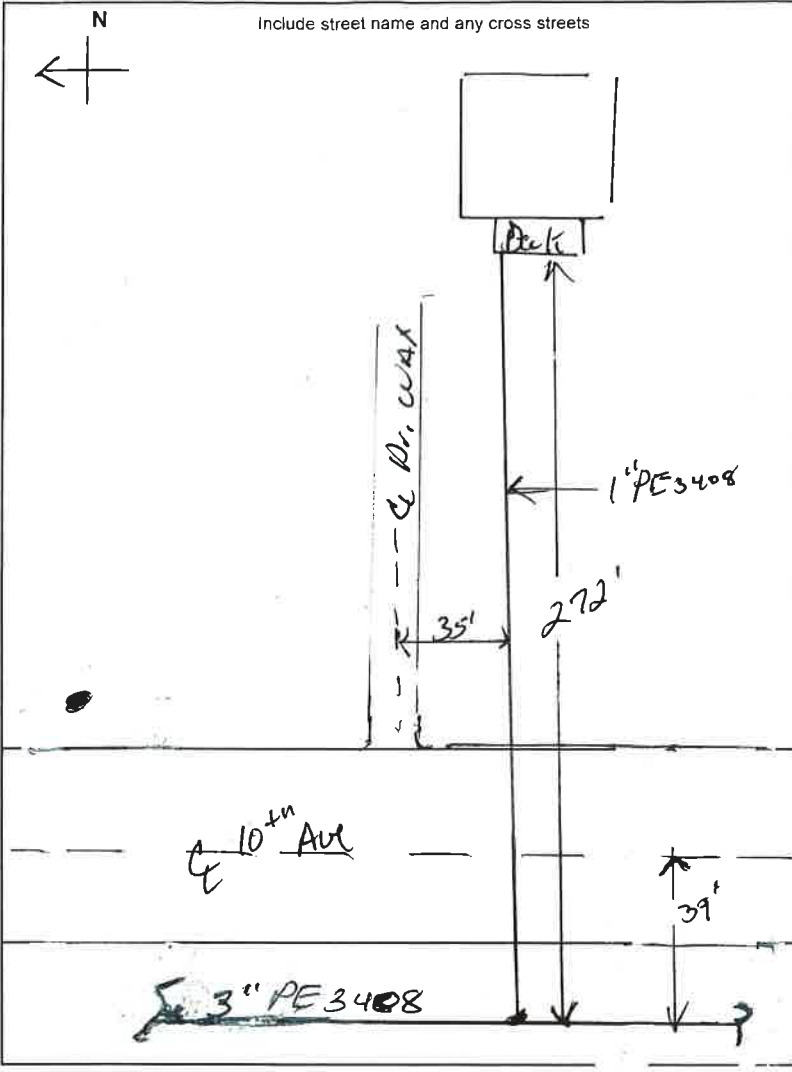

Material List	Lot #	Qty
Pipe 5/8" or 1"		272
Tee 2x5/8 or 2x1		
Tee 4x5/8 or 6x1	258594	1
Tee 6x5/8 or 6x1		
EFV 5/8 or 1"	13171	1
5, 10 or 12 # Meter Bar		1
Cplg 5/8 or 1 or 2"	Bracket post - Foundn.	1
Split Bolt	Riser 5/8 or 1"	1
5/8 or 1" ELL	Cap 5/8 or 1"	
PE Tee 5/8 or 1"	PE Reducer 5/8x1"	
Carsonite	Anode 3#	
# of Heaters	Restoration	Y <input type="checkbox"/> N <input type="checkbox"/>

**Meter**

Locked  Unlocked

Size 275 Location Front Deck

MFG Sensus Reading 0000

New Meter # 18171130

Reg. Type/Press. 2# 5# 10# 12#

Old Meter# \_\_\_\_\_

Old Meter Reading: \_\_\_\_\_

Does Winter Construction Apply? Y  N

Remarks: \_\_\_\_\_

**Condition of Existing Pipe**

	Outside	Inside	Coating
Good	<input type="checkbox"/>	<input type="checkbox"/>	<input type="checkbox"/>
Fair	<input type="checkbox"/>	<input type="checkbox"/>	<input type="checkbox"/>
Bad	<input type="checkbox"/>	<input type="checkbox"/>	<input type="checkbox"/>

Anode # \_\_\_\_\_ MV Reading \_\_\_\_\_

**Existing Main**

Size 3" Pressure \_\_\_\_\_ Type/Mfr Dura Line

Lot # \_\_\_\_\_ Cover 36" Location \_\_\_\_\_

**New Service / Main**

Size 1" Lot # NAD164033GB17FDL

Poly Mfr Dura Line Nature of Soil \_\_\_\_\_

Tap Size 1/2 Cover 36" Completion Date 9/24/13

Foreman ID T. Schwaner Welder/Fuser ID T. Schwaner

**Pressure Test**

Test With: Air  Nitrogen  Duration 30 min Emp ID T. Schwaner

Date Tested 9/24/13 PSI 150 Soap Test Final Tie-in? Y  N

Filled out by Mapping Dept.

Mapped in System Maps \_\_\_\_\_ Date \_\_\_\_\_

Mapped in GIS \_\_\_\_\_ Date \_\_\_\_\_

Entry Person \_\_\_\_\_ Date \_\_\_\_\_

GSOC Polygon Available Yes  No

Description	Install Footage
Directional Bore	
Pneumatic Bore	40
Backhoe	20
Inserting	
Trench	
Plow	212
Hand Digging	
Joint Trench	
Gopher Pipe	
Cust. Perf. Loc.	

Permit Required Y  N  Township Rd Morrison Co.

updated 8/12/2013

DH 1/31/14  
**SCANNED**