


CR 210/ Elm Rd

C/L CR 209

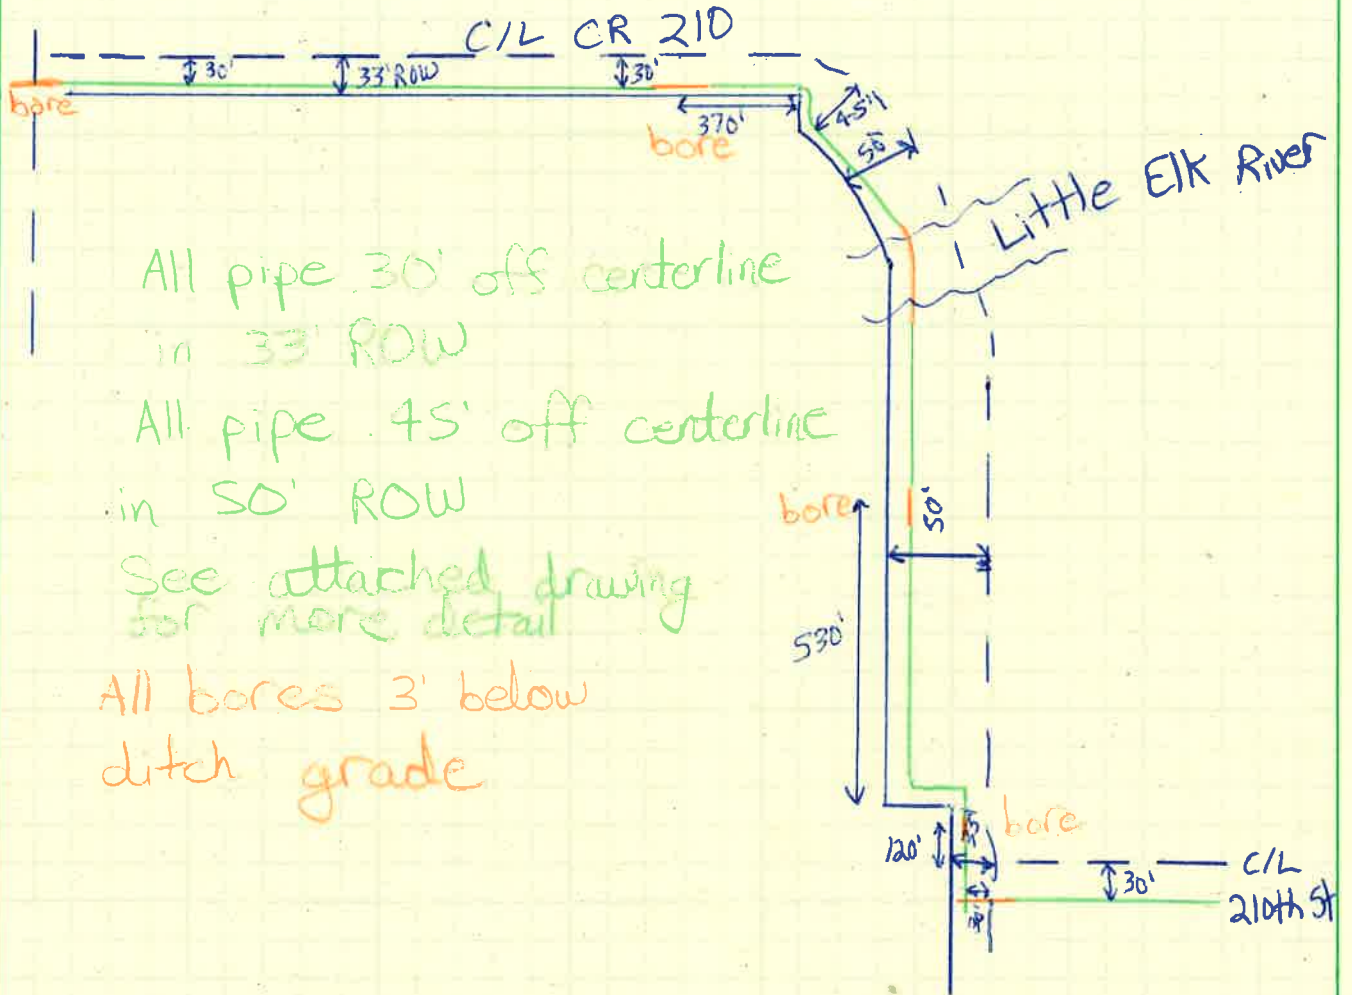

All pipe 30' off centerline
in 33' ROW

All pipe 45' off centerline
in 50' ROW

See attached drawing
for more detail

All bores 3' below
ditch grade

