

**GAS ASBUILT**

STREET ADDRESS

Mapping Address


1326 829 76 9-27-13  
W.O.# 3:00

13-SC-SW-77-SWS-5116

CITY/Twp

CITY/Twp

White Flag 9-25-13

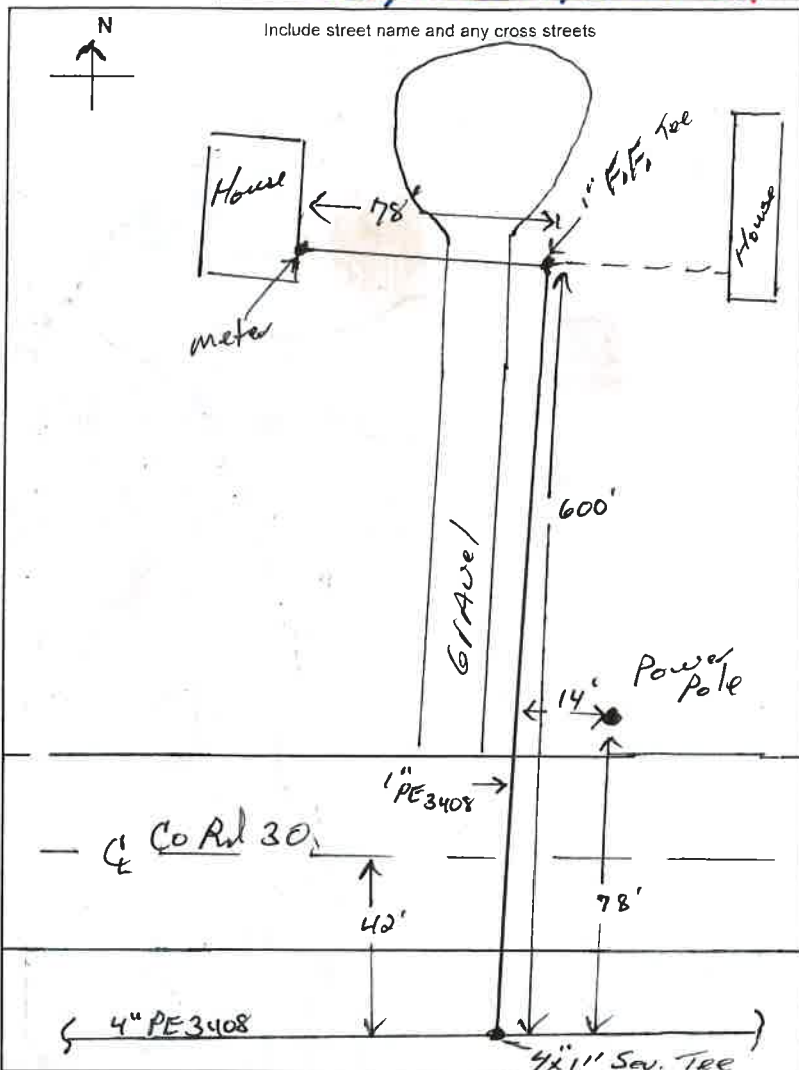

Remarks:

Pipe & Fitting Type  High D  Medium D

Material List	Lot #	Qty
Pipe 5/8" or 1"	NAD 16Y033GA Feb 18	678
Tee 2x5/8 or 2x1		
Tee 4x5/8 or 4x1	29 85 95	1
Tee 6x5/8 or 6x1		
EFV 5/8 or 1"	13171	1
5, 10 or 12 # Meter Bar		
Cplg 5/8 or 1 or 2"	Bracket - Post - Foundn.	1
Split Bolt 2	Riser 5/8 or 1"	1
5/8 or 1" ELL	Cap 5/8 or 1"	
PE Tee 5/8 or 1"	PE Reducer 5/8x1"	1
Scrap pipe		10'
Scrap wire		10'
wire		602'
Carsonite	Anode 3#	
# of Heaters	Restoration	Y <input type="checkbox"/> N <input type="checkbox"/>

**Meter**

Locked  Unlocked

Size 275 Location Front

MFG Sensus Reading 0000

New Meter # 18033020

Reg. Type/Press. 2# 5# 10# 12#

Old Meter# \_\_\_\_\_

Old Meter Reading: \_\_\_\_\_

Does Winter Construction Apply? Y  N

**Condition of Existing Pipe**

	Outside	Inside	Coating
Good	<input type="checkbox"/>	<input type="checkbox"/>	<input type="checkbox"/>
Fair	<input type="checkbox"/>	<input type="checkbox"/>	<input type="checkbox"/>
Bad	<input type="checkbox"/>	<input type="checkbox"/>	<input type="checkbox"/>

Anode # \_\_\_\_\_ MV Reading \_\_\_\_\_

Description	Install Footage
Directional Bore	
Pneumatic Bore	45
Backhoe	
Inserting	
Trench	25
Plow	600
Hand Digging	8
Joint Trench	
Gopher Pipe	
Cust. Perf. Loc.	

**Existing Main**

Size 4" Pressure \_\_\_\_\_ Type/Mfr Dura Line - 3408

Lot # \_\_\_\_\_ Cover 38 Location 42' EG

**New Service / Main**

Size 1" Lot # NAD 16Y033GA Feb 18

Poly Mfr Dura Line Nature of Soil Sandy clay

Tap Size 1/2 Cover 24" Completion Date 9/30/13

Foreman ID T. Schwanhauser Welder/Fuser ID T. Schwanhauser

**Pressure Test**

Test With: Air  Nitrogen  Duration 30 min Emp ID T. Schwanhauser

Date Tested 9/30/13 PSI 150 Soap Test Final Tie-in? Y  N

Filled out by Mapping Dept.

Mapped in System Maps \_\_\_\_\_ Date \_\_\_\_\_

Mapped in GIS \_\_\_\_\_ Date \_\_\_\_\_

Entry Person \_\_\_\_\_ Date \_\_\_\_\_

GSOC Polygon Available Yes  No

Permit Required  Y  N sent final copy  
updated 8/12/2016

as built to monitron co.