

GAS ASBUILT

132700545 10-1-13 CSA#11
 8:45
 15312 Bison Rd.
 T129N-R31W-SECT10

W.O. #

13-SL-SW-77-SWS-5115


STREET ADDRESS

CITY/Twp

Mailing Address

CITY/Twp

White Flag 9-26-11B2

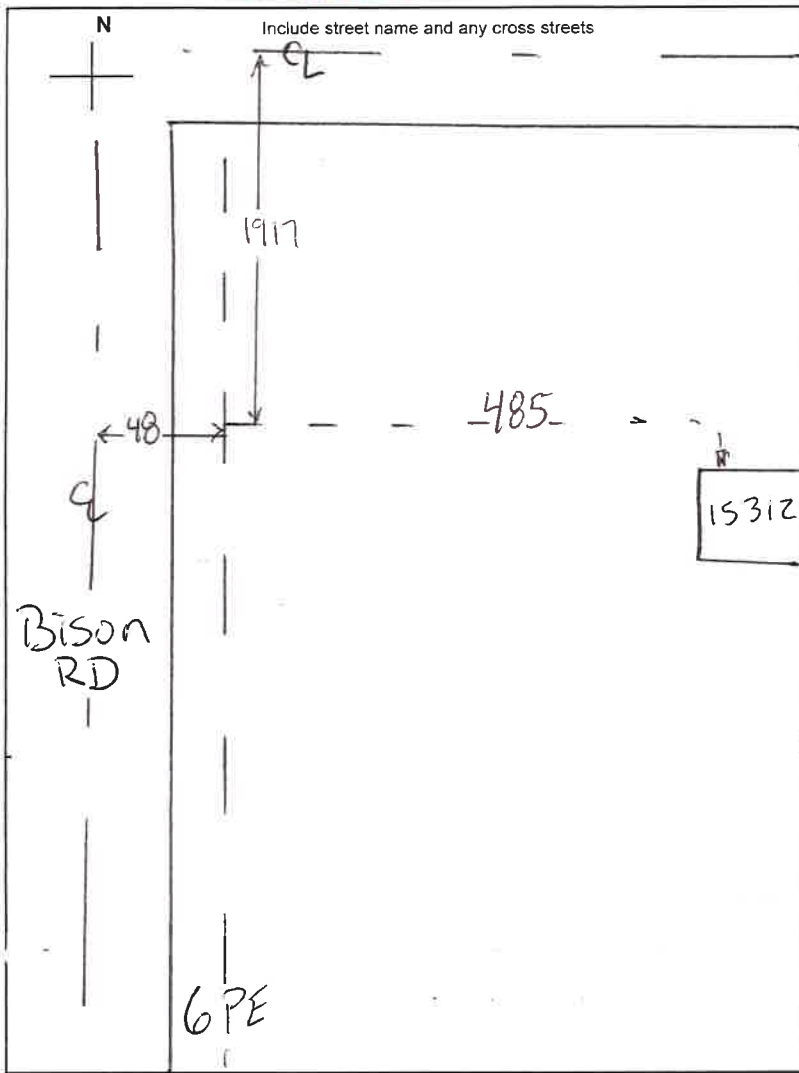

Pipe & Fitting Type High D Medium D

Material List	Lot #	Qty
Pipe 5/8" or 1"	See Remarks	485
Tee 2x5/8 or 2x1		
Tee 4x5/8 or 4x1		
Tee 6x5/8 or 6x1	298025	1
EFV 5/8 or 1"		
2, 5, 10 or 12 # Meter Bar		1
Cplg 5/8 or 1" or 2" (i)	Bracket - post Foundtn.	(1)
Split Bolt (1)	Rise 5/8 or 1"	1
5/8 or 1" ELL	Cap 5/8 or 1"	
PE Tee 5/8 or 1"	PE Reducer 5/8x1"	1
Carsonite	Anode 3#	
# of Heaters	Restoration	Y <input type="checkbox"/> N <input type="checkbox"/>

Meter

Locked Unlocked

Size 275 Location North

MFG Sensus Reading 0000

New Meter # 18032963

Reg. Type/Press. (2#) 5# 10# 12#

Old Meter# _____

Old Meter Reading: _____

Does Winter Construction Apply? Y N

Condition of Existing Pipe

	Outside	Inside	Coating
Good	<input type="checkbox"/>	<input type="checkbox"/>	<input type="checkbox"/>
Fair	<input type="checkbox"/>	<input type="checkbox"/>	<input type="checkbox"/>
Bad	<input type="checkbox"/>	<input type="checkbox"/>	<input type="checkbox"/>

Anode # _____ MV Reading _____

Description	Install Footage
Directional Bore	
Pneumatic Bore	
Backhoe	
Inserting	
Trench	
Plow	485
Hand Digging	
Joint Trench	
Gopher Pipe	
Cust. Perf. Loc.	

Remarks: _____

1" PE off Astm D2513 NAD 40336 C 19 Feb 13 coil 0000112

Existing Main	
Size 6	Pressure 100 Type/Mfr Dura-Line
Lot # ~	Cover 36 Location -
New Service / Main	
Size 1	Lot # See Remarks
Poly Mfr Dura-Line	Nature of Soil Gravel-Sand
Tap Size -	Cover 30 Completion Date 10-1-13
Foreman ID 5576	Welder/Fuser ID 7945
Pressure Test	
Test With: Air & Nitrogen	Duration 30 Emp ID 7945
Date Tested 10-1-13	PSI 152 Soap Test Final Tie-in? Y <input checked="" type="checkbox"/> N <input type="checkbox"/>
Filled out by Mapping Dept.	
Mapped in System Maps _____	Date _____
Mapped in GIS _____	Date _____
Entry Person _____	Date _____
GSOC Polygon Available	Yes <input type="checkbox"/> No <input type="checkbox"/>

Permit Required Y N

updated 8/12/2013 #11

CSAH Morrison
 W. Send asbuilt