

GAS ASBUILT


Address: 18714 Twin Lakes Rd. Little Falls
 Property: 130N 30W 33
 WO: 13 SC - LI - 78 - SWS - 0 - Meschke North

White Flag 8/2/13 MS

G

S

Include street name and any cross streets

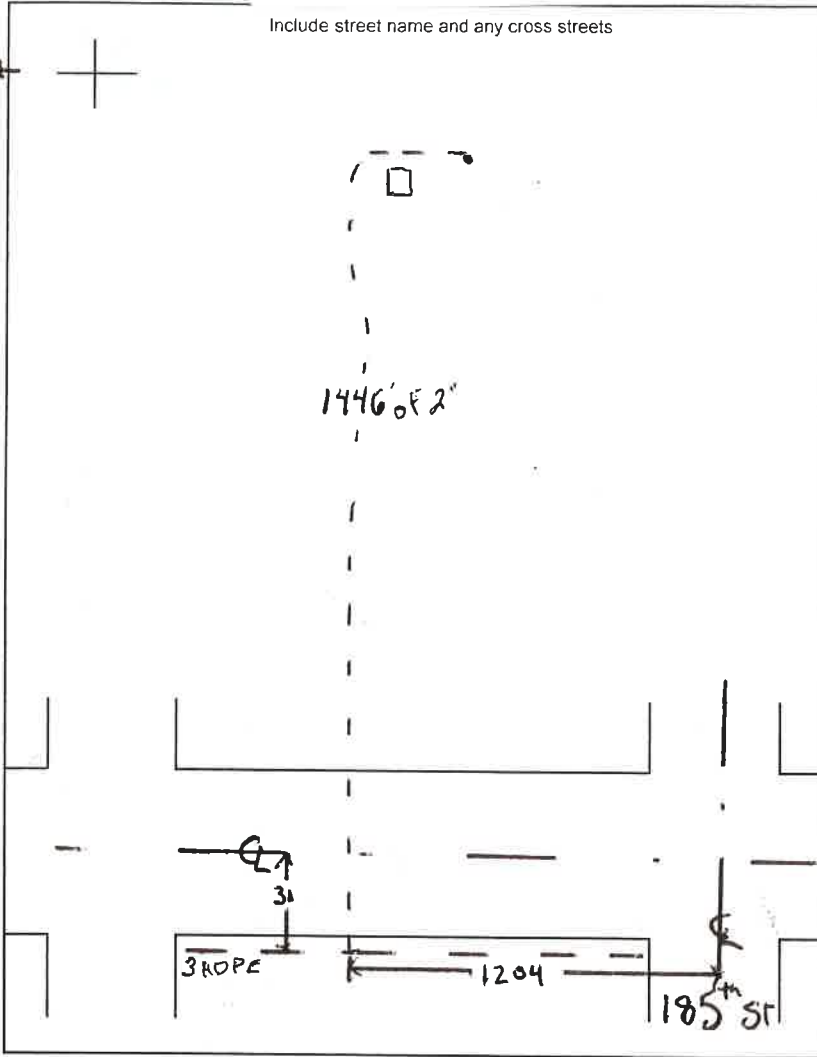

Remarks: Gm 6 set the meter

Material List	Lot #	Qty
Pipe 5/8" or 1"		
Tee 2x5/8 or 2x1		
Tee 4x5/8 or 4x1		
Tee 6x5/8 or 6x1		
EFV 5/8 or 1"		
2, 5, 10 or 12 # Meter Bar		
Cplg 5/8 or 1 or 2"	Bracket - post - Foundtn.	
Split Bolt	Riser 5/8 or 1"	
5/8 or 1" ELL	Cap 5/8 or 1"	
PE Tee 5/8 or 1"	PE Reducer 5/8x1"	
<u>3x2 HV tee</u>	<u>294306</u>	<u>1</u>
<u>2" Pipe</u>		<u>1446</u>
<u>2" Riser</u>		<u>1</u>
Carsonite	Anode 3#	
# of Heaters	Restoration Y N	

Meter

Locked Unlocked

Size NA Location _____

MFG _____ Reading _____

New Meter # _____

Reg. Type/Press. 2# 5# 10# 12#

Old Meter# NA

Old Meter Reading: _____

Does Winter Construction Apply? Y N

Condition of Existing Pipe

	Outside	Inside	Coating
Good	<input type="checkbox"/>	<input type="checkbox"/>	<input type="checkbox"/>
Fair	<input type="checkbox"/>	<input type="checkbox"/>	<input type="checkbox"/>
Bad	<input type="checkbox"/>	<input type="checkbox"/>	<input type="checkbox"/>

Anode # _____ MV Reading _____

Existing Main	
Size <u>3</u> Pressure <u>100</u> Type/Mfr _____	
Lot # _____ Cover <u>36</u> Location _____	
New Service / Main	
Size <u>2</u> Lot # _____	
Poly Mfr _____ Nature of Soil <u>Sandy/Rocky</u>	
Tap Size _____ Cover <u>30</u> Completion Date <u>8-2-13</u>	
Foreman ID <u>5578</u> Welder/Fuser ID _____	
Pressure Test	
Test With: Air / Nitrogen Duration <u>30</u> Emp ID <u>5578</u>	
Date Tested <u>8-2-13</u> PSI <u>152</u> Soap Test Final Tie-in? Y <input checked="" type="checkbox"/> N <input type="checkbox"/>	
Filled out by Mapping Dept.	
Mapped in System Maps _____ Date _____	
Mapped in GIS _____ Date _____	
Entry Person _____ Date _____	
GSOC Polygon Available Yes <input type="checkbox"/> No <input type="checkbox"/>	

Description	Install Footage
Directional Bore	
Pneumatic Bore	
Backhoe	
Inserting	
Trench	
Plow	<u>1446'</u>
Hand Digging	
Splitting	
Joint Trench	
Gopher Pipe	
Cust. Perf. Loc.	