

GAS ASBUILT


Address: 19067 Twin Lakes Rd. Little Falls

Property: 130N 30W 29

WO: 13- SC - LF - 78 - SWS - 5043 -

132690580
9-30-13
8:15

White Flag

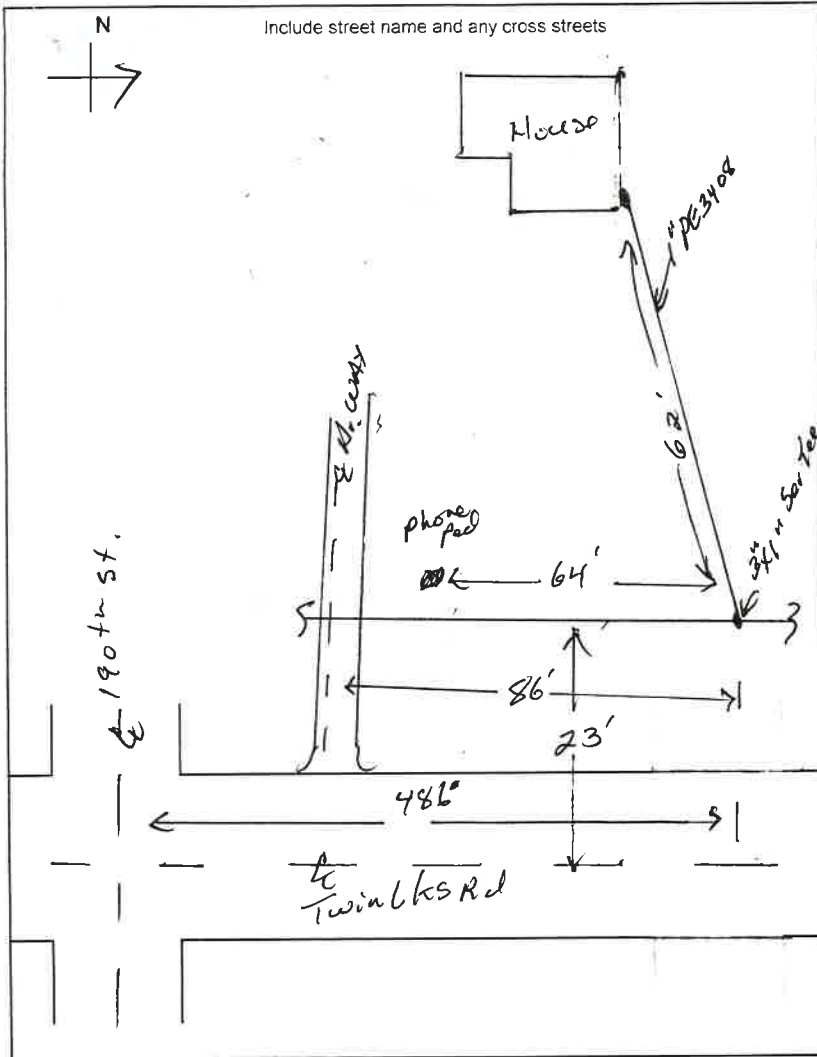

Remarks: _____

Material List	Lot #	Qty
Pipe 5/8" or 1"	NRD1640336A Feb 18	62
Tee 2x5/8 or 2x4 3x1	298594	1
Tee 4x5/8 or 4x1		
Tee 6x5/8 or 6x1		
EFV 5/8 or 1"	13171	1
5, 10 or 12 # Meter Bar		1
Cplg 5/8 or 1 or 2"	Bracket - post - Foundn.	
Split Bolt	Riser 5/8 or 1"	1
5/8 or 1" ELL	Cap 5/8 or 1"	
PE Tee 5/8 or 1"	PE Reducer 5/8x1"	1
Carsonite	Anode 3#	
# of Heaters	Restoration Y N	

Meter

Locked Unlocked

Size 275 Location right E

MFG Sen SCS Reading 0000

New Meter # 18032986

Reg. Type/Press. 27 5# 10# 12#

Old Meter# _____

Old Meter Reading: _____

Does Winter Construction Apply? Y N

Condition of Existing Pipe

	Outside	Inside	Coating
Good	<input type="checkbox"/>	<input type="checkbox"/>	<input type="checkbox"/>
Fair	<input type="checkbox"/>	<input type="checkbox"/>	<input type="checkbox"/>
Bad	<input type="checkbox"/>	<input type="checkbox"/>	<input type="checkbox"/>

Anode # _____ MV Reading _____

Existing Main

Size 3 Pressure _____ Type/Mfr 3408 Duwa Line

Lot # _____ Cover 36 Location 23' w e

New Service / Main

Size 1 Lot # NRD1640336A Feb 18

Poly Mfr Duwa Line Nature of Soil sand.

Tap Size 1/2 Cover 36" Completion Date 10/7/13

Foreman ID T. Schwaner Welder/Fuser ID T. Schwaner

Pressure Test

Test With: Air + Nitrogen Duration 15 min Emp ID T. Schwaner

Date Tested 10/7/13 PSI 150 Soap Test Final Tie-in? Y N

Filled out by Mapping Dept.

Mapped in System Maps _____ Date _____

Mapped in GIS _____ Date _____

Entry Person _____ Date _____

GSOC Polygon Available Yes No

Description	Install Footage
Directional Bore	
Pneumatic Bore	
Backhoe	<u>10</u>
Inserting	
Trench	
Plow	<u>48</u>
Hand Digging	<u>6</u>
Splitting	
Joint Trench	
Gopher Pipe	
Cust. Perf. Loc.	