

GAS ASBUILT

13275 1410-4-13 (CSMH 22) 19523 Twin Lakes Rd. T130N / R30W / Sect (29)

W.O. #


13-SC-LF-78-SWS-5106

STREET ADDRESS

CITY/Twp

CITY/Twp

White Flag

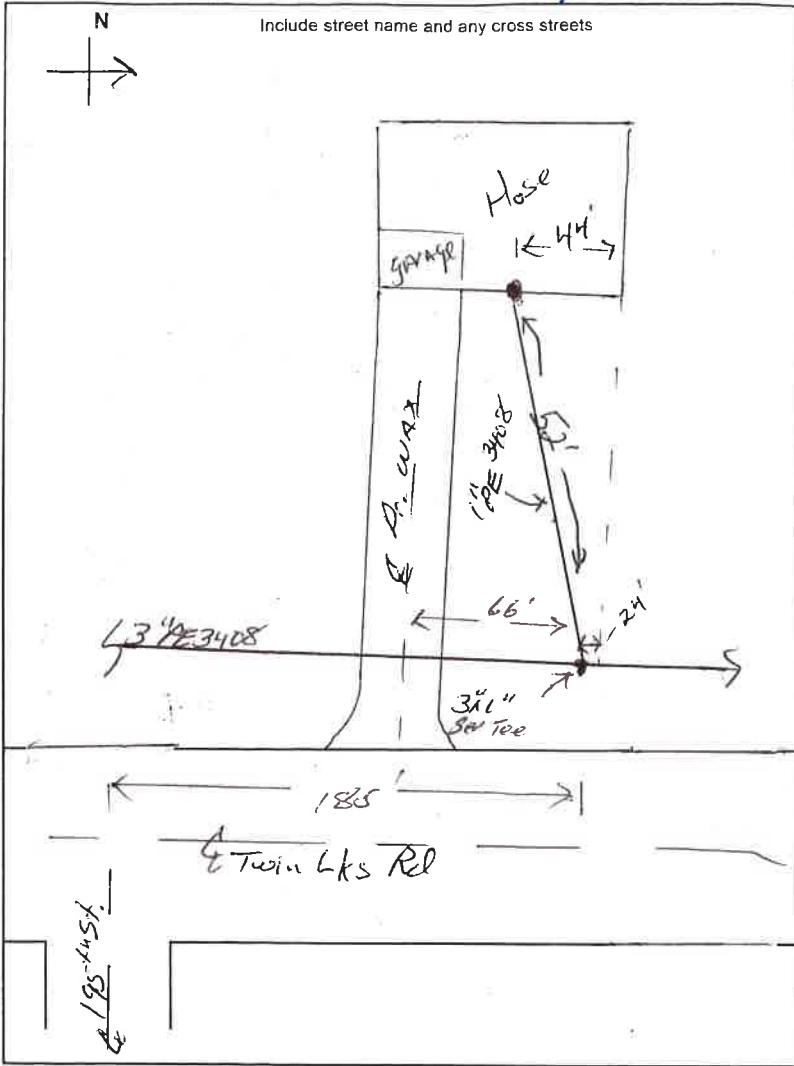

Pipe & Fitting Type High D Medium D

Material List	Lot #	Qty
Pipe 5/8" or 1"	NAD 16103360 Feb 19	52'
Tee 2x5/8 or 2x1.3x1	29 8544	1
Tee 4x5/8 or 4x1		
Tee 6x5/8 or 6x1		
EFV 5/8 or 1"	13171	1
2, 5, 10 or 12 # Meter Bar		
Cplg 5/8 or 1" / 2"	Bracket - post - Foundn.	
Split Bolt	Riser 5/8 or 1"	1
5/8 or 1" ELL	Cap 5/8 or 1"	
PE Tee 5/8 or 1"	PE Reducer 5/8x1"	1

Carsonite Anode 3#
 # of Heaters Restoration Y N

Meter

Locked Unlocked
 Size 275 Location Front
 MFG Spasus Reading 0000
 New Meter # 180.32905
 Reg. Type/Press. 2# 5# 10# 12#

Old Meter#
 Old Meter Reading:

Does Winter Construction Apply? Y N

Condition of Existing Pipe

	Outside	Inside	Coating
Good	<input type="checkbox"/>	<input type="checkbox"/>	<input type="checkbox"/>
Fair	<input type="checkbox"/>	<input type="checkbox"/>	<input type="checkbox"/>
Bad	<input type="checkbox"/>	<input type="checkbox"/>	<input type="checkbox"/>

Anode # _____ MV Reading _____

Description Install Footage

Directional Bore	
Pneumatic Bore	
Backhoe	8
Inserting	
Trench	
Plow	38
Hand Digging	6
Joint Trench	
Gopher Pipe	
Cust. Perf. Loc.	

Remarks:

Existing Main

Size 3 Pressure _____ Type/Mfr DuraLine 3408
 Lot # _____ Cover 36 Location 32' wd

New Service / Main

Size 1" Lot # NAD 16103360 Feb 19
 Poly Mfr Dura Line Nature of Soil sandy clay
 Tap Size 1/2 Cover 36" Completion Date 10/8/13
 Foreman ID T. Schwabauer Welder/Fuser ID T. Schwabauer

Pressure Test

Test With: Air / Nitrogen Duration 15min Emp ID T. Schwabauer
 Date Tested 10/8/13 PSI 150 Soap Test Final Tie-in? Y N

Filled out by Mapping Dept.

Mapped in System Maps _____ Date _____
 Mapped in GIS _____ Date _____
 Entry Person _____ Date _____
 GSOC Polygon Available Yes No

Permit Required Y N Morrison Co.
 updated 8/12/2013

send final as built to CO.

SCANNED 12/13/13