

**GAS ASBUILT**

STREET ADDRESS

Mailing Address

*BLHS*  
9098 200th St.

T130N-R30-W-SECT 21

W.O. #


CITY/Twp

CITY/Twp

13-SC-78-SWS-5101

**White Flag**

Pipe & Fitting Type  High D  Medium D

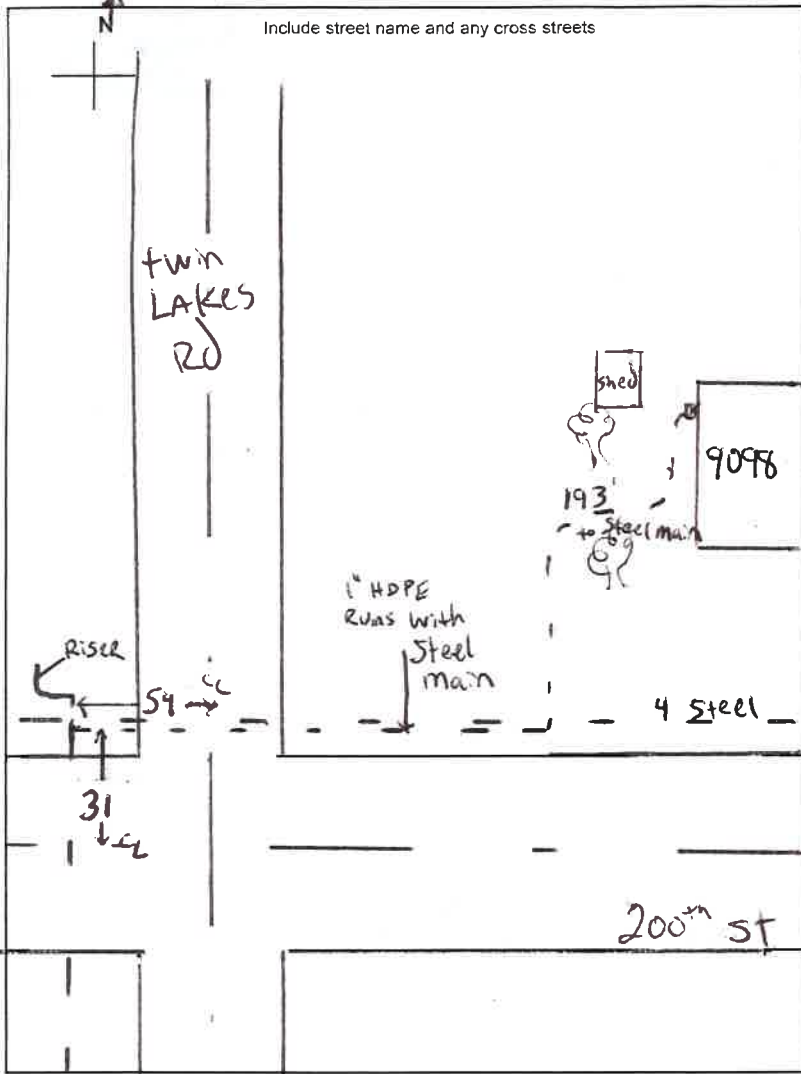

Material List	Lot #	Qty
Pipe 5/8" or 1"	See Remarks	193
Tee 2x5/8 or 3x1	298594	1
Tee 4x5/8 or 4x1		
Tee 6x5/8 or 6x1		
EFV 5/8 or 1"	13171	1
2, 5, 10 or 12 # Meter Bar		
Cplg 5/8 or 1 or 2"	Bracket - post - Foundtn.	1
Split Bolt	Riser 5/8 or 1"	1
5/8 or 1" ELL	Cap 5/8 or 1"	
PE Tee 5/8 or 1"	PE Reducer 5/8x1"	
Carsonite	Anode 3#	
# of Heaters	Restoration	Y <input type="checkbox"/> N <input type="checkbox"/>

**Meter**

Locked  Unlocked

Size 200 gpd Location West

MFG Sensus Reading 0000

New Meter # 18032929

Reg. Type/Press. 2# 5# 10# 12#

Old Meter# \_\_\_\_\_

Old Meter Reading: \_\_\_\_\_

Does Winter Construction Apply? Y  N

Remarks: 1" PE CEF ASTM D2513 NAD 1640336A18  
FC613 coil 000028

**Condition of Existing Pipe**

	Outside	Inside	Coating
Good	<input type="checkbox"/>	<input type="checkbox"/>	<input type="checkbox"/>
Fair	<input type="checkbox"/>	<input type="checkbox"/>	<input type="checkbox"/>
Bad	<input type="checkbox"/>	<input type="checkbox"/>	<input type="checkbox"/>

Anode # \_\_\_\_\_ MV Reading \_\_\_\_\_

**Existing Main**

Size 3 Pressure 100 Type/Mfr \_\_\_\_\_

Lot # \_\_\_\_\_ Cover 36 Location \_\_\_\_\_

**New Service / Main**

Size 1 Lot # See Remarks

Poly Mfr \_\_\_\_\_ Nature of Soil Sandy

Tap Size \_\_\_\_\_ Cover 30 Completion Date 8-26-13

Foreman ID 5578 Welder/Fuser ID 7945

**Pressure Test**

Test With:  Air  Nitrogen Duration 30 Emp ID 7945

Date Tested 8-26-13 PSI 154 Soap Test Final Tie-in? Y  N

Filled out by Mapping Dept.

Mapped in System Maps \_\_\_\_\_ Date \_\_\_\_\_

Mapped in GIS \_\_\_\_\_ Date \_\_\_\_\_

Entry Person \_\_\_\_\_ Date \_\_\_\_\_

GSOC Polygon Available Yes  No

Description	Install Footage
Directional Bore	
Pneumatic Bore	
Backhoe	
Inserting	
Trench	
Plow	<u>193</u>
Hand Digging	
Joint Trench	
Gopher Pipe	
Cust. Perf. Loc.	

Permit Required Y  N  Township rd.

updated 8/12/2013