


GAS ASBUILT

Address: 11984 10th Ave. Swanville
 Property: 129N 31W 31
 WO: 13 SC - SW - 77 - SWS - 5063 -

132602283
 9/19 SP

White Flag

Flagged 9/5 LG

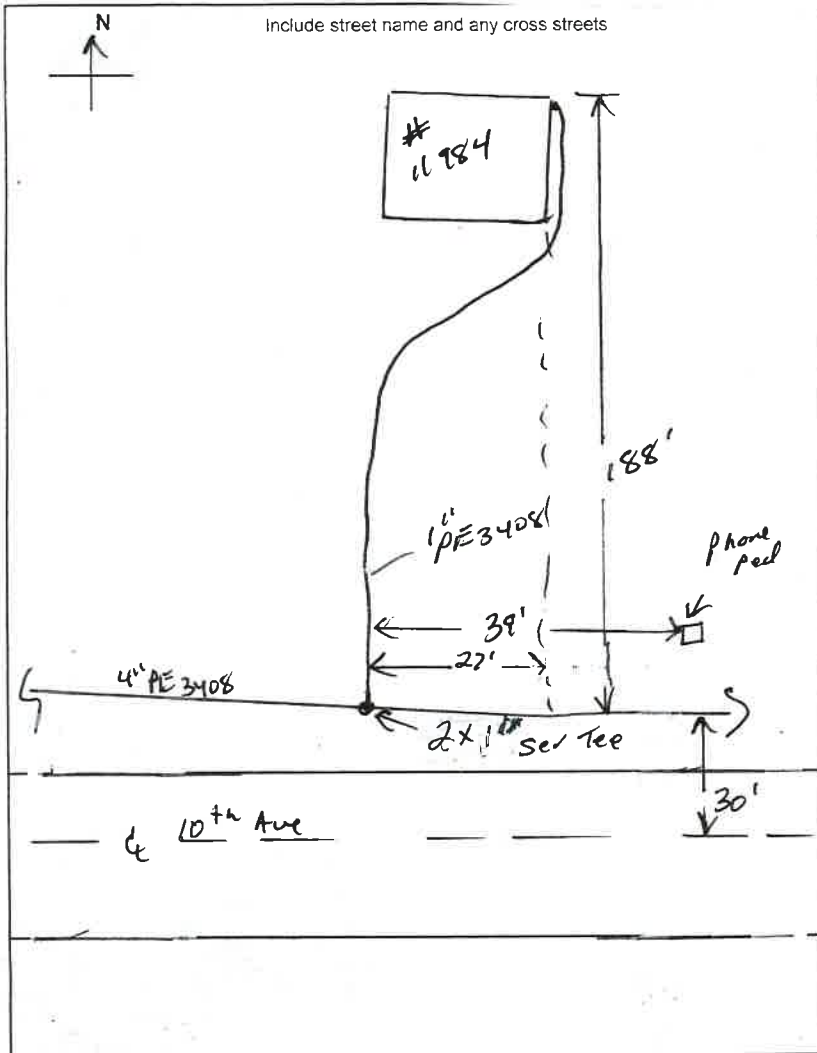

Remarks: _____

Material List	Lot #	Qty
Pipe 5/8" or 1"	NAD1640336B	188
Tee 2x5/8 or 2x1		1
Tee 4x5/8 or 4x1		
Tee 6x5/8 or 6x1		
EFV 5/8 or 1"	13171	1
5, 10 or 12 # Meter Bar		1
Cplg 5/8 or 1 or 2"	Bracket - 005 - Foundn.	
Split Bolt	Riser 10 Por	1
5/8 or 1" ELL	Cap 10 or 1"	0
PE Tee 5/8 or 1"	PE Reducer 5/8x1"	1
Scrap Pipe		5
Scrap wire		5
wire		190
Carsonite	Anode 3#	
# of Heaters	Restoration Y N	

Meter

Locked Unlocked

Size 275 Location Right

MFG Sensus Reading 0000

New Meter # 18171147

Reg. Type/Press. 5# 5# 10# 12#

Old Meter# _____

Old Meter Reading: _____

Does Winter Construction Apply? Y N

Condition of Existing Pipe

	Outside	Inside	Coating
Good	<input type="checkbox"/>	<input type="checkbox"/>	<input type="checkbox"/>
Fair	<input type="checkbox"/>	<input type="checkbox"/>	<input type="checkbox"/>
Bad	<input type="checkbox"/>	<input type="checkbox"/>	<input type="checkbox"/>

Anode # _____ MV Reading _____

Existing Main

Size 2" Pressure _____ Type/Mfr 3408 - Dura Line

Lot # _____ Cover 36 Location _____

New Service / Main

Size 1" Lot # NAD1640336B17 Feb

Poly Mfr Dura Line Nature of Soil _____

Tap Size 1/2 Cover 36 Completion Date 9/25/13

Foreman ID T. Schwanhauer Welder/Fuser ID T. Schwanhauer

Pressure Test

Test With: Air / Nitrogen Duration 15min Emp ID T. Schwanhauer

Date Tested 9/25/13 PSI 150 Soap Test Final Tie-in? Y N

Filled out by Mapping Dept.

Mapped in System Maps _____ Date _____

Mapped in GIS _____ Date _____

Entry Person _____ Date _____

GSOC Polygon Available Yes No

Description	Install Footage
Directional Bore	
Pneumatic Bore	
Backhoe	
Inserting	
Trenching	
Plow	
Hand-Digging	
Splitting	
Joint Trench	
Gopher Pipe	
Cust. Perf. Loc.	