


GENERAL LOCATION ONLY. DO NOT USE TO LOCATE FOR EXCAVATION. CALL 1-800-252-1166 FOR ONSITE LOCATIONS AND STAKING.

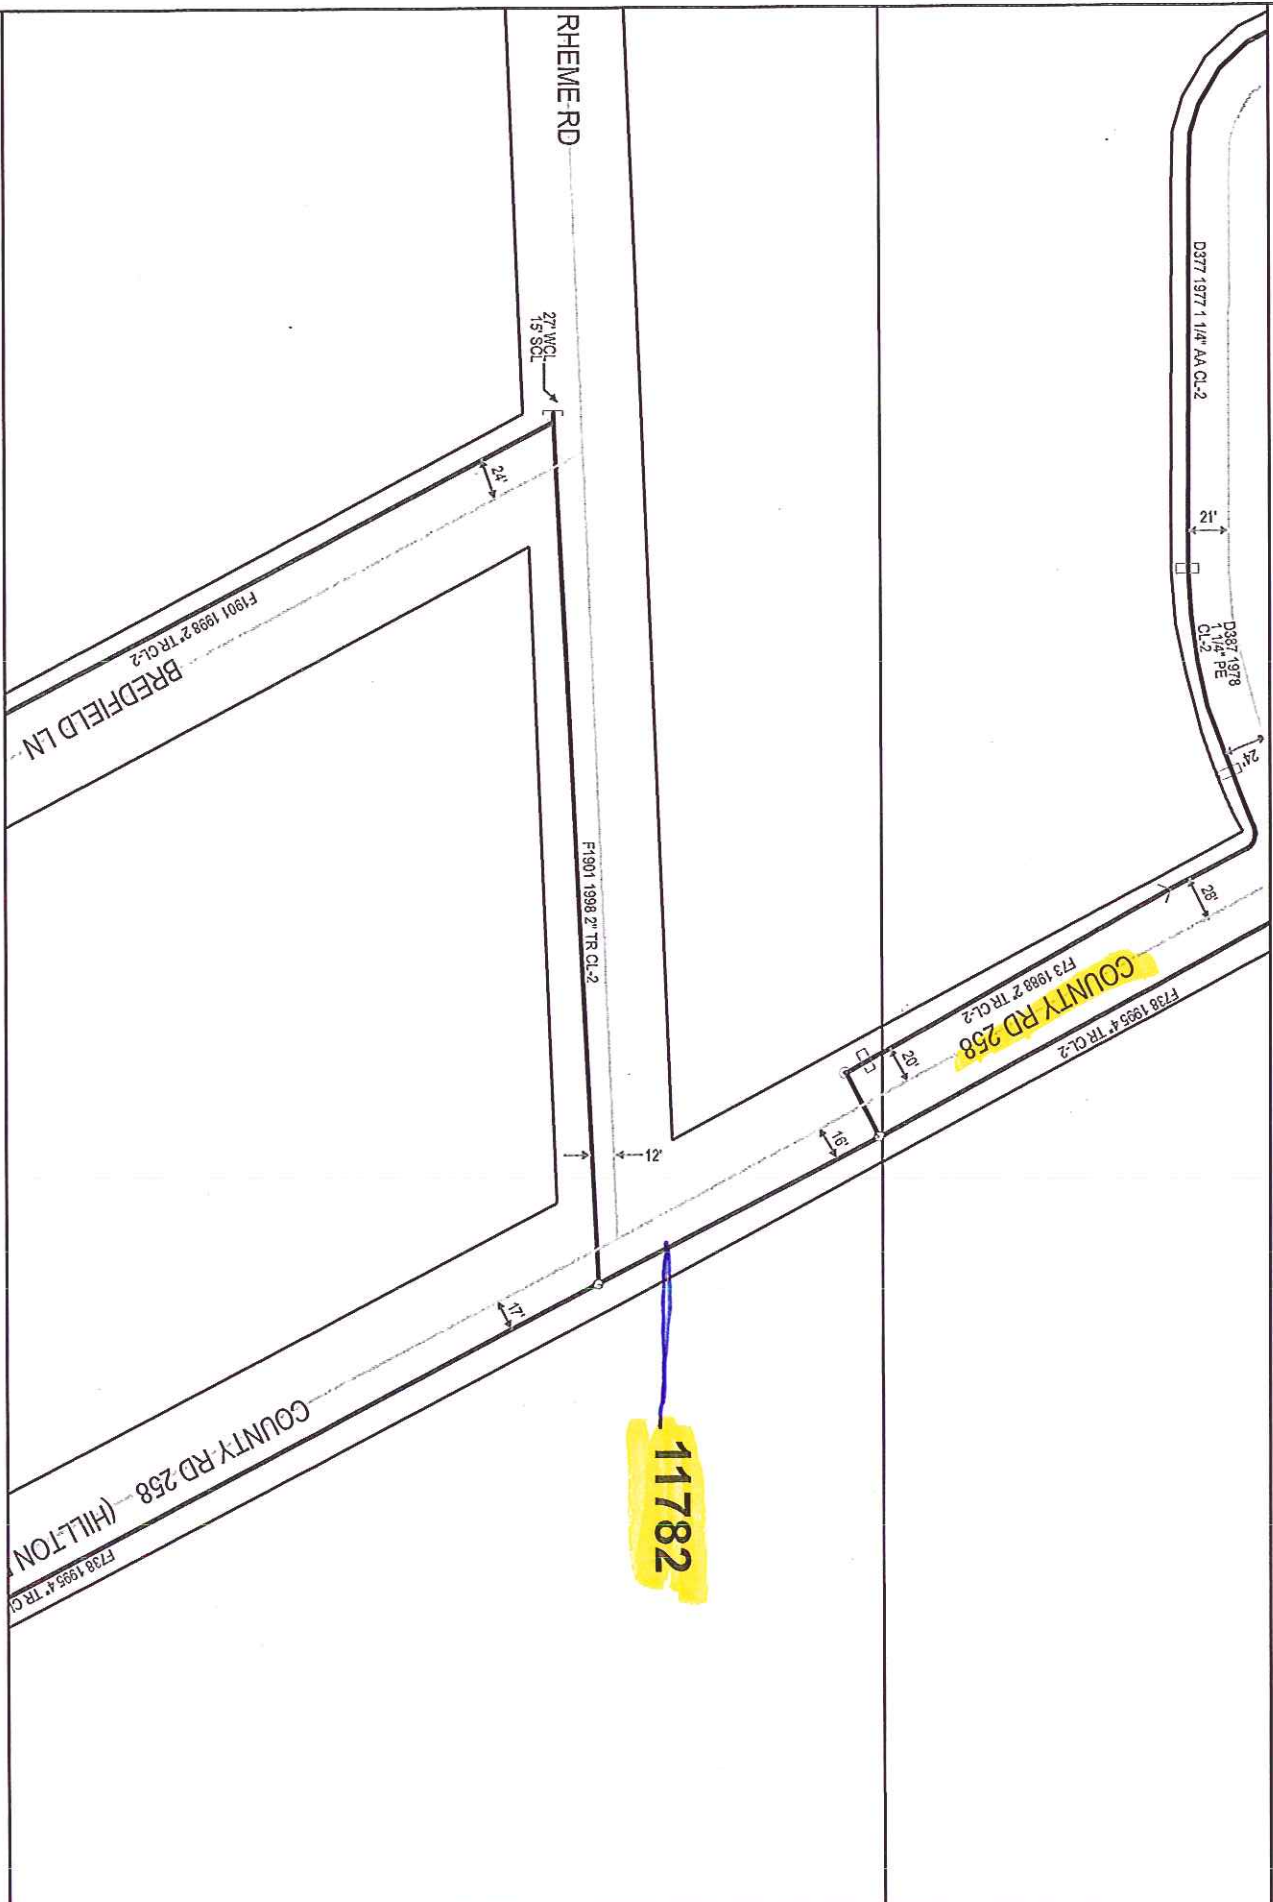

Plotted by: i213215
Plot Date: 4/17/2013

11782 HILTON ROAD (CO RD 258)
LITTLE FALLS MN

Scale: 1" = 100'
North