


STEARNS ELECTRIC ASSOCIATION
 900 KRAFT DRIVE SE
 NEIROSE MN 56352
 320-256-4241 OFFICE

Joel JANOSCHKE (DESIGN ENGINEER)
 Cell 320-292-0575



NEW 3 PHASE
 UNDER GROUND CABLE
 IS 44' G' ALONG
 DOVE RD

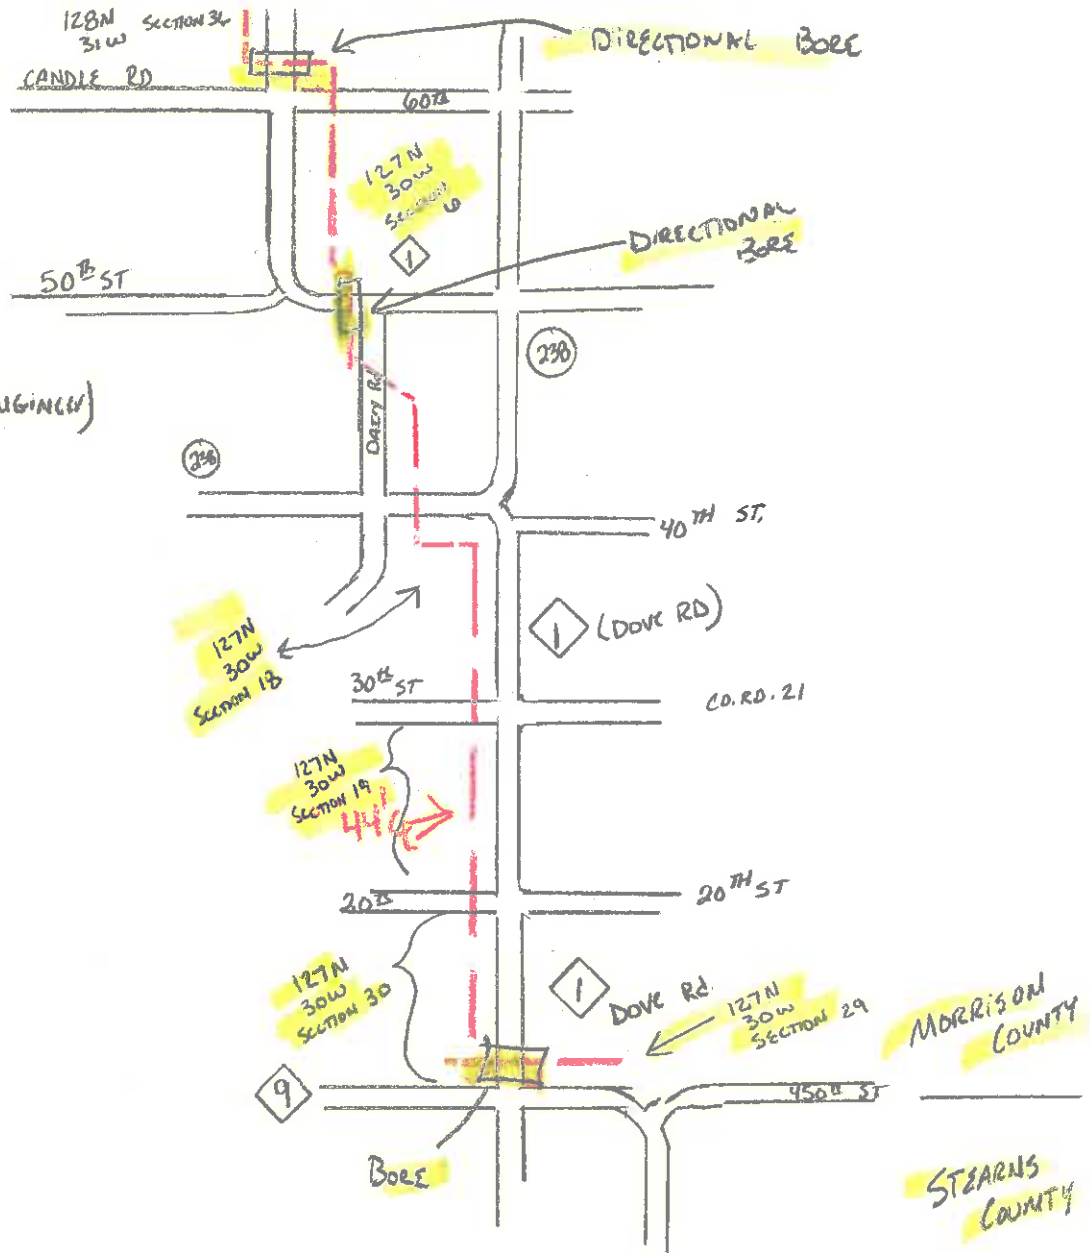