


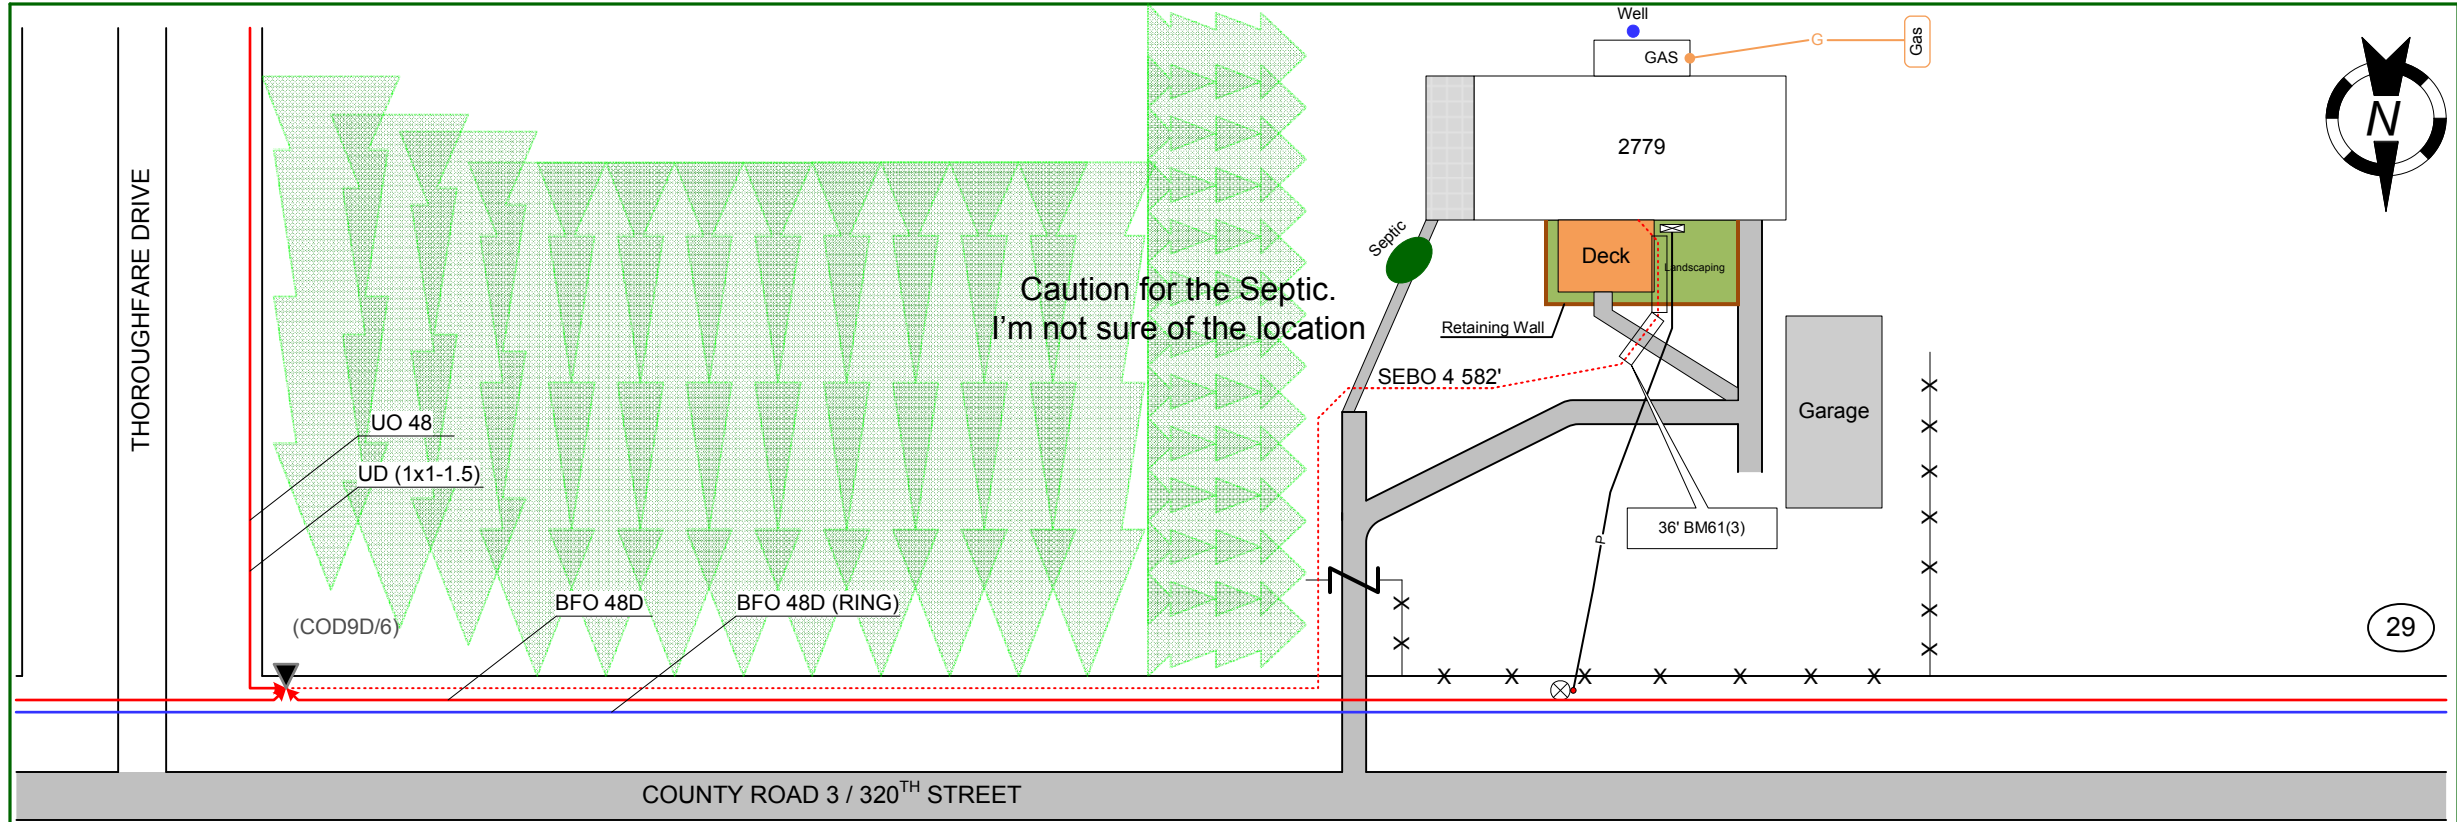

29



From	To	PType	Units	Feet	BM	HO	NID	W	Remarks
(COD9D/6)	2779 C-11A/B		SEBO 4	582	61(3)	36	1	1	(3) BDO 5 (SGC)
	2779 C-11A/B								F(I) Inside Fiber NID

As Staked

Consolidated Telephone Company

Name: 2013 2779 320th Street
 WO: 2013 - Lincoln
 Exch: Lincoln
 Route: COD9D
 ROW: House Drop

State: Minnesota
 County: Morrison
 Range: 31W
 Twsp: 132N Section: 29

Township: Scandia Valley

Staked By: EMD Date: 5-29-13
 Revised By: _____ Date: _____
 Revised By: _____ Date: _____
 Revised By: _____ Date: _____
 As-Built By: _____ Date: _____