


GENERAL LOCATION ONLY. DO NOT USE TO LOCATE FOR EXCAVATION. CALL 1-800-252-1166 FOR ONSITE LOCATIONS AND STAKING.

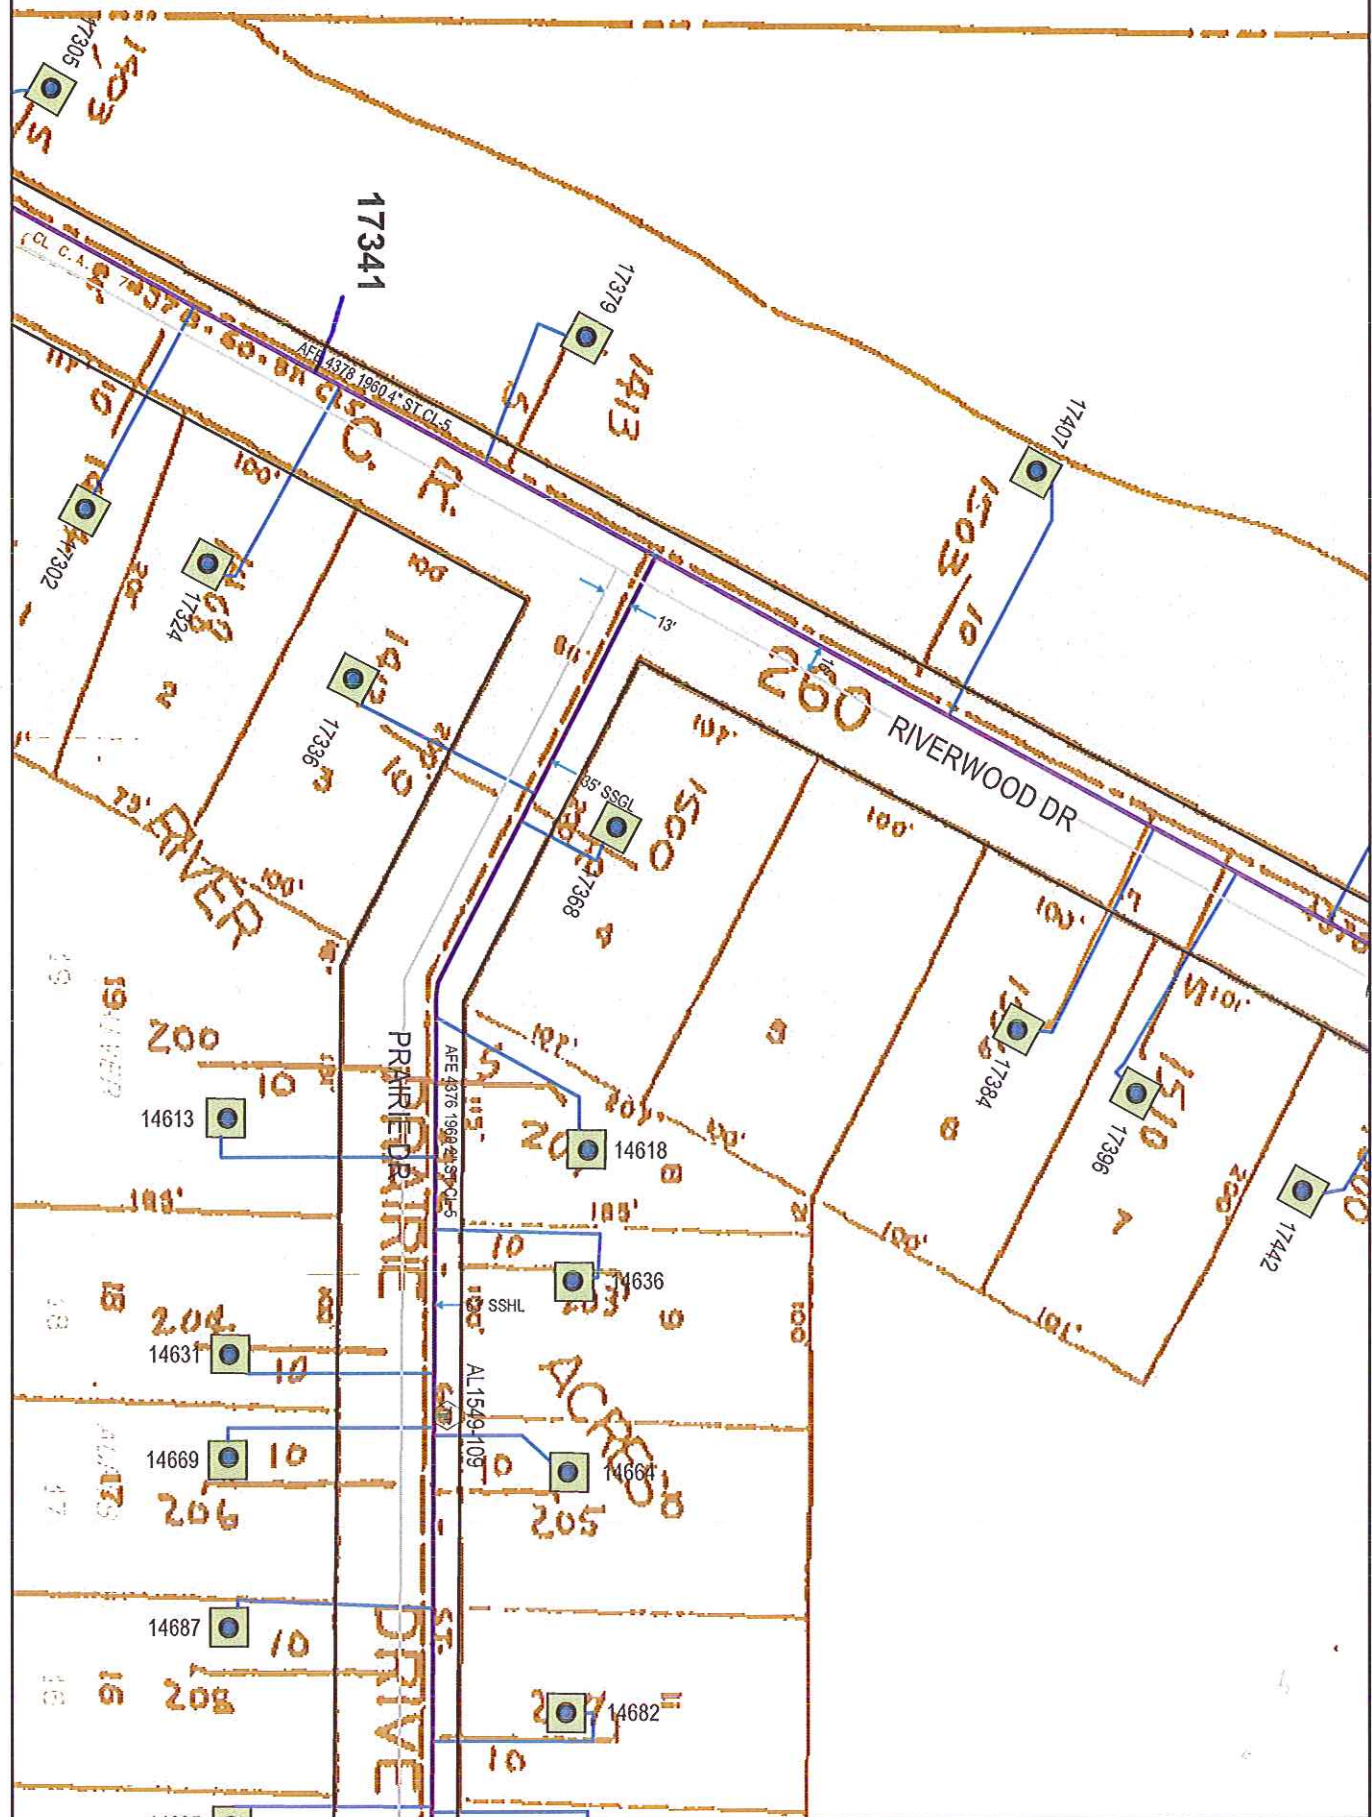

Plotted by: I217335
Plot Date: 6/5/2013

17341 RIVERWOOD DR
LITTLE FALLS

Scale: 1" = 100'
CenterPoint Energy
North