

CenturyLink Constant Job Order/Maintenance Work Authorization


Company T600 Exchange Swanville Service Order# TWMN445138  
 Work Activity Buired Drop-Copper Capital \_\_\_\_\_ Maintenance x  
 Customer Name mike chuba Phone# 3205479900  
 Address 11661 30th ave swanville One Call Ticket# \_\_\_\_\_  
 Location/Directions \_\_\_\_\_  
 Description of Work or Special Instructions pus150' under 30th ave from ped 173 to bpost at end of driveway single pair is open under road

DOR/TOG Yes \_\_\_ No \_\_\_ Permit: Yes \_\_\_ No \_\_\_ Bore: Yes x No \_\_\_ CBR# 320 5479900  
 Employee Name Craig Cox Employee Contact# 3206306221

Sketch (Include Line & Pedestal)	Material/Labor Units		Est Qty.	Actual Qty.	Placed by (Foreman/Crew Name)
	Description	Notes			
Line _____ Ped# <u>173</u>	SEB3-22	Place 3 pair BSW	150		
County <u>morrison</u>	BM2C	Place BSW Bond			
	HC1E	Splice Pair at Ped			
Township _____	XXSEB-GL	Remove Temp Drop	150		
Section _____					
Range _____	BM61(1.5)D	Underground Bore 1.5"	40		
GPS Reading _____					

Nearest cross st. cable road Plat Page \_\_\_\_\_ Map# \_\_\_\_\_

Damaged facility # \_\_\_\_\_  
 TOWNSHIP NAME swanville

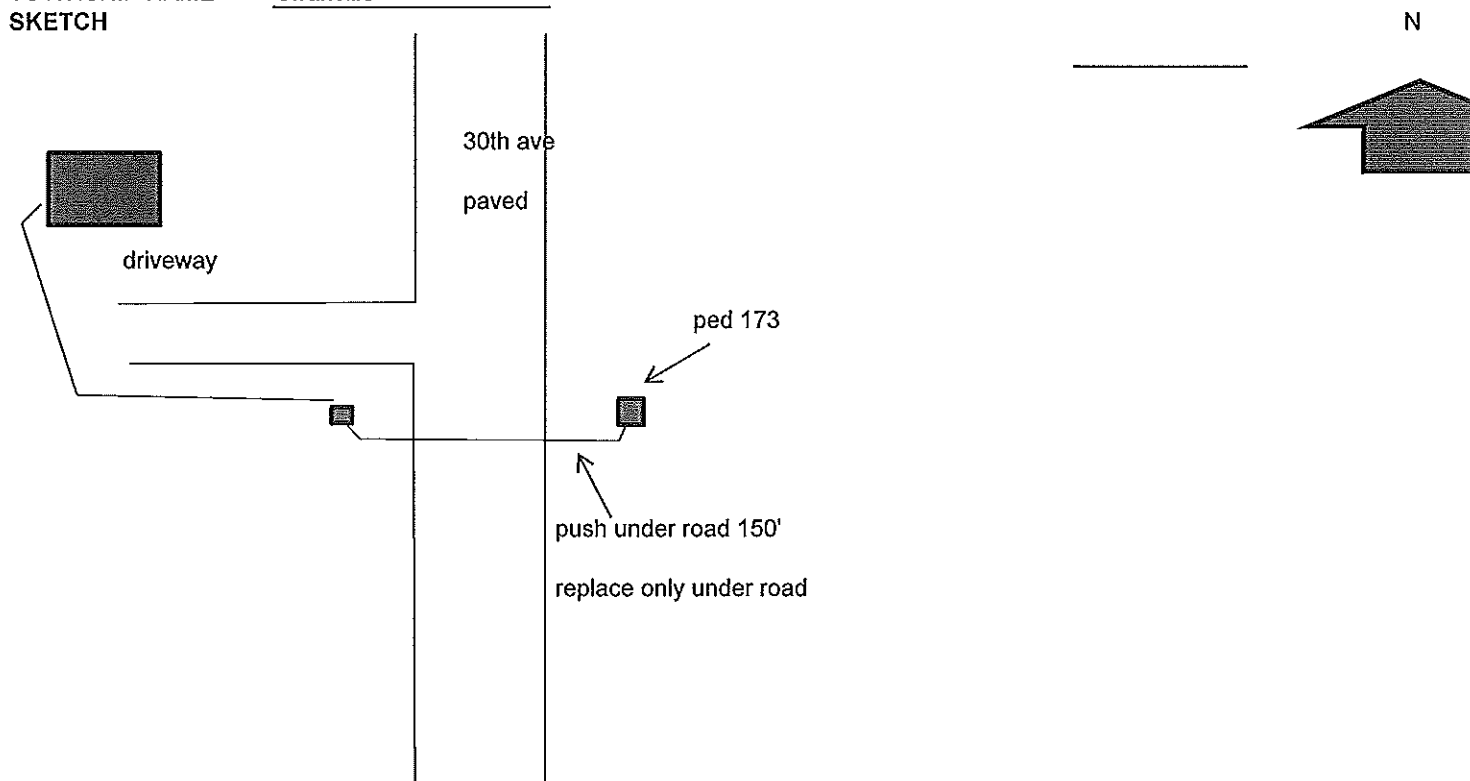

Originated By: craig cox Date: 6/25/13 Completed By: Mark Howard Date: 7/5/13  
 Authorized By: \_\_\_\_\_ Date: \_\_\_\_\_ Inspected By: \_\_\_\_\_ Date: \_\_\_\_\_

Inspection notes: \_\_\_\_\_