




26

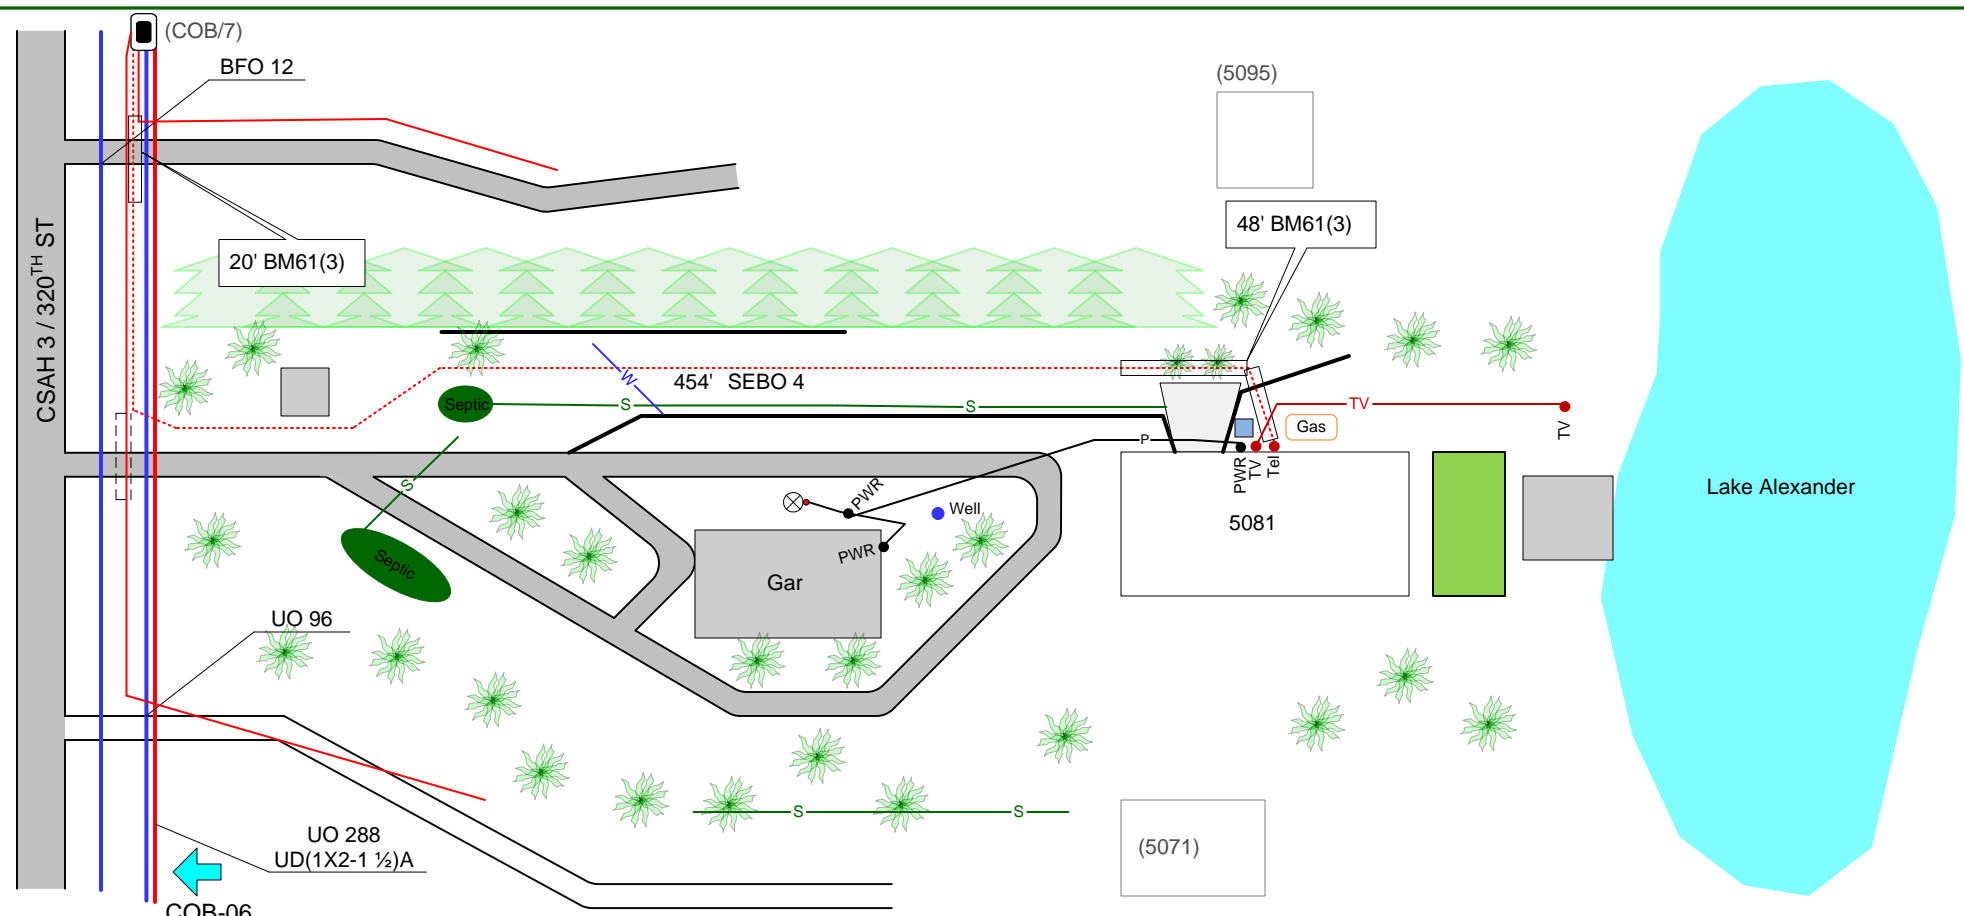

Caution Power, Septic, Gas, TV Line. Tight corridor-Small Machine needed.

From	To	PType	Units	Feet	BM	HO	NID	W	Remarks
(COB/7)	5081		SEBO 4	454	61(3)	20	(3)	BHF(36x60x36)	
	5081				61(3)	48	F(O)	HBFO(288)(L)	

As Staked
Consolidated Telephone Company
 Name: 2013-5081 320th St
 WO: 2013 - Lincoln
 Exch: Lincoln
 Route: COB
 ROW: House Drop
 State: Minnesota
 County: Morrison
 Range: 31W
 Twsp: 132N Section: 26
 Township: SCANDIA VALLEY
 Staked By: JMM Date: 5-12-11
 Revised By: RE Date: 3-21-12
 Revised By: CLP Date: 9/26/13
 Revised By: _____ Date: _____
 As-Built By: _____ Date: _____