


GENERAL LOCATION ONLY. DO NOT USE TO LOCATE FOR EXCAVATION. CALL 1-800-252-1166 FOR ONSITE LOCATIONS AND STAKING.

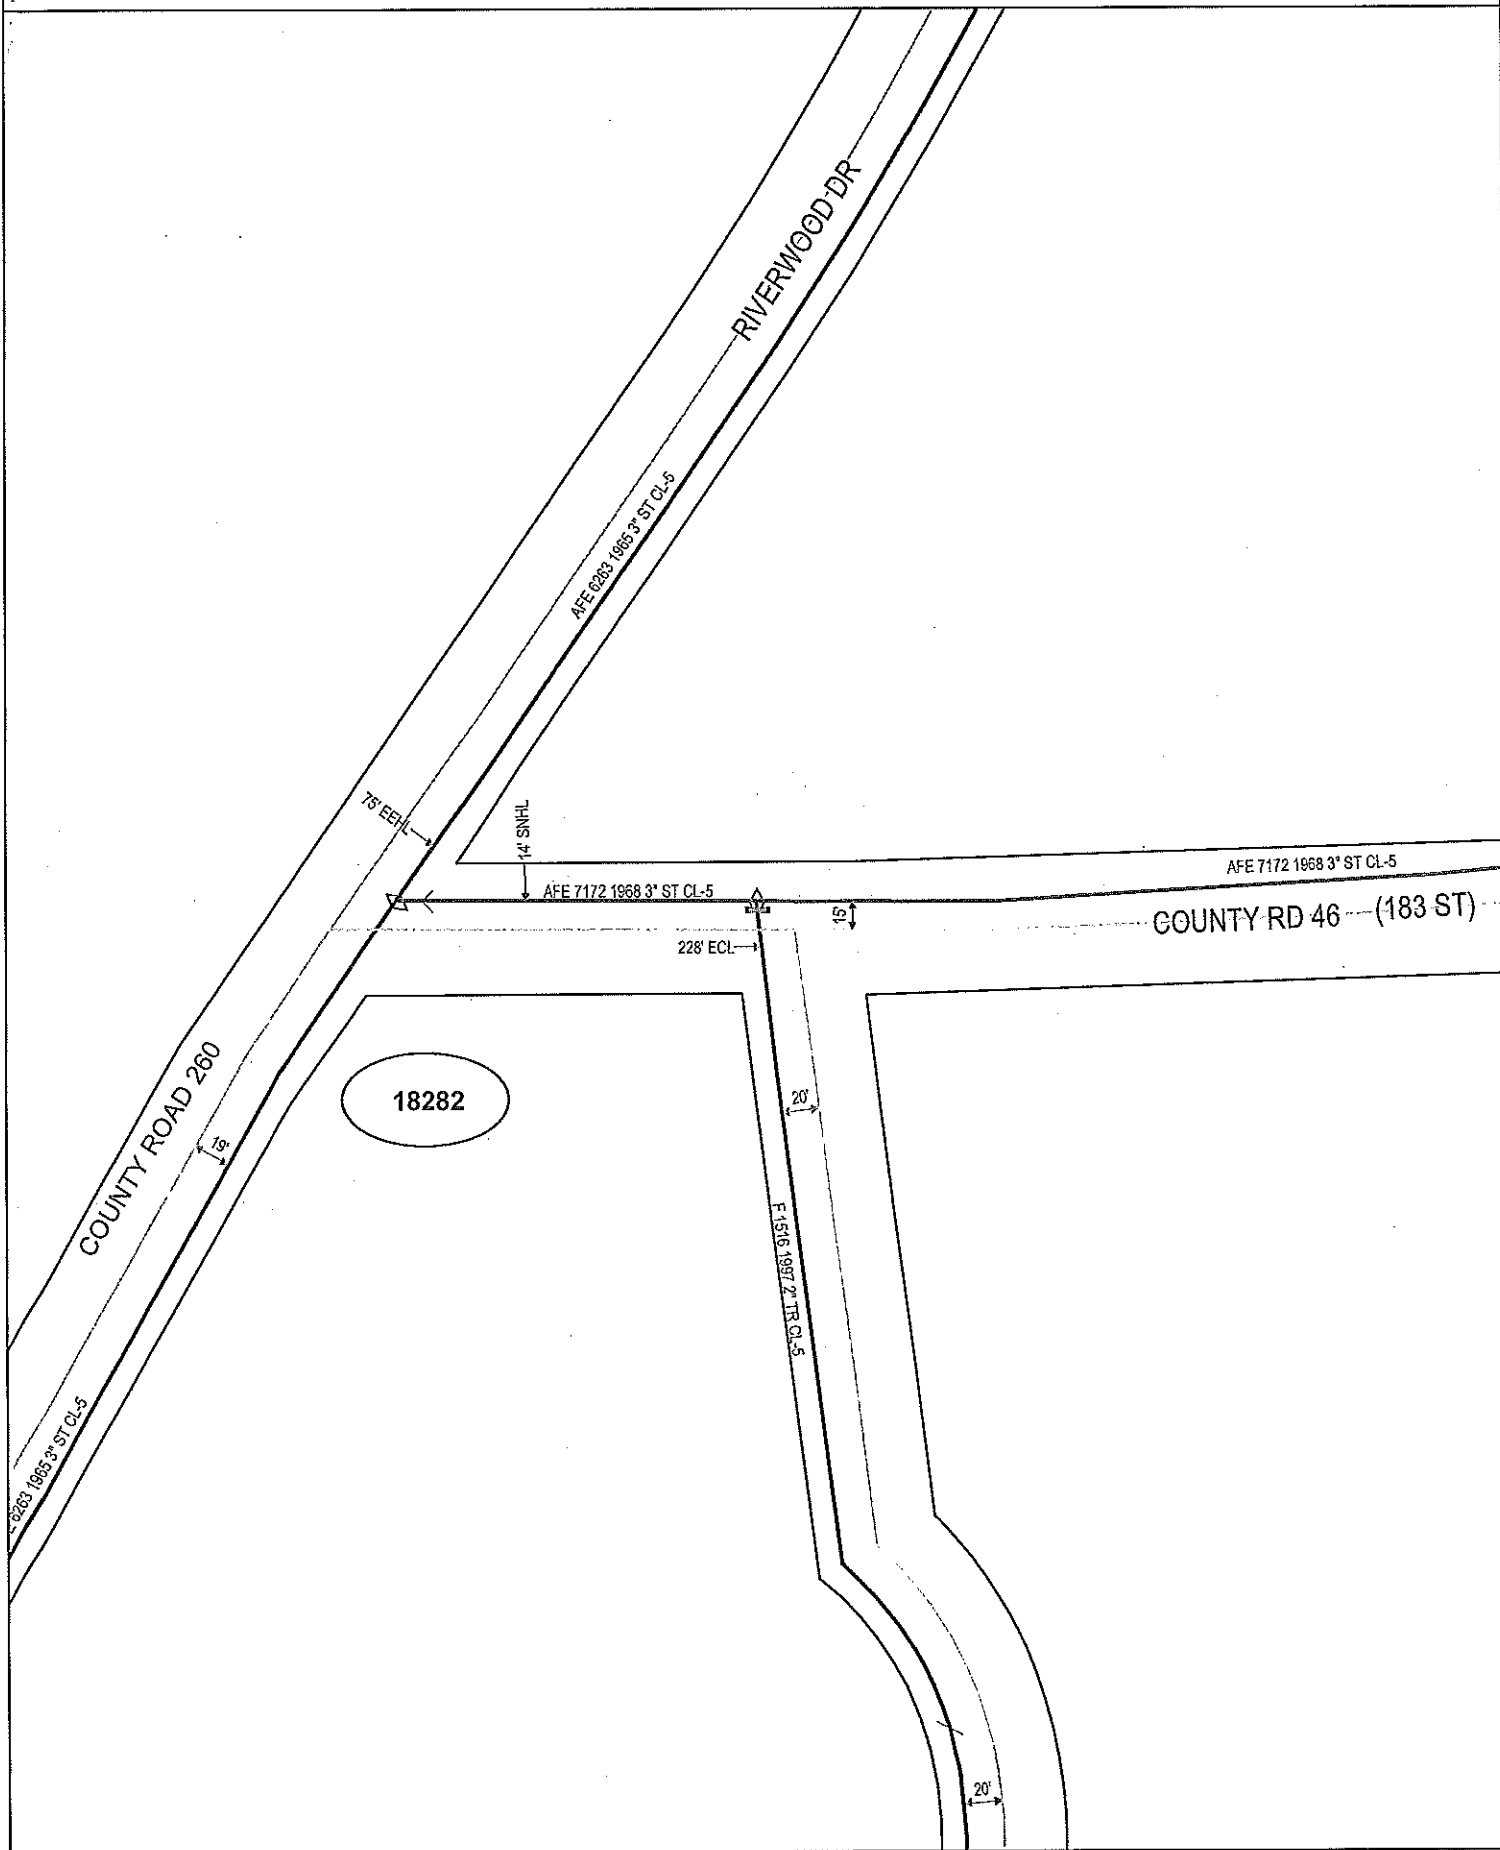

Plotted by: i068919

Plot Date: 10/21/2013

18282 RIVERWOOD DR (CTY RD 260)

BELLE PRAIRIE TWP - MORRISON COUNTY

Scale: 1" : 100'

