


GENERAL LOCATION ONLY. DO NOT USE TO LOCATE FOR EXCAVATION. CALL 1-800-252-1166 FOR ONSITE LOCATIONS AND STAKING.

000 47 11 E 105.99

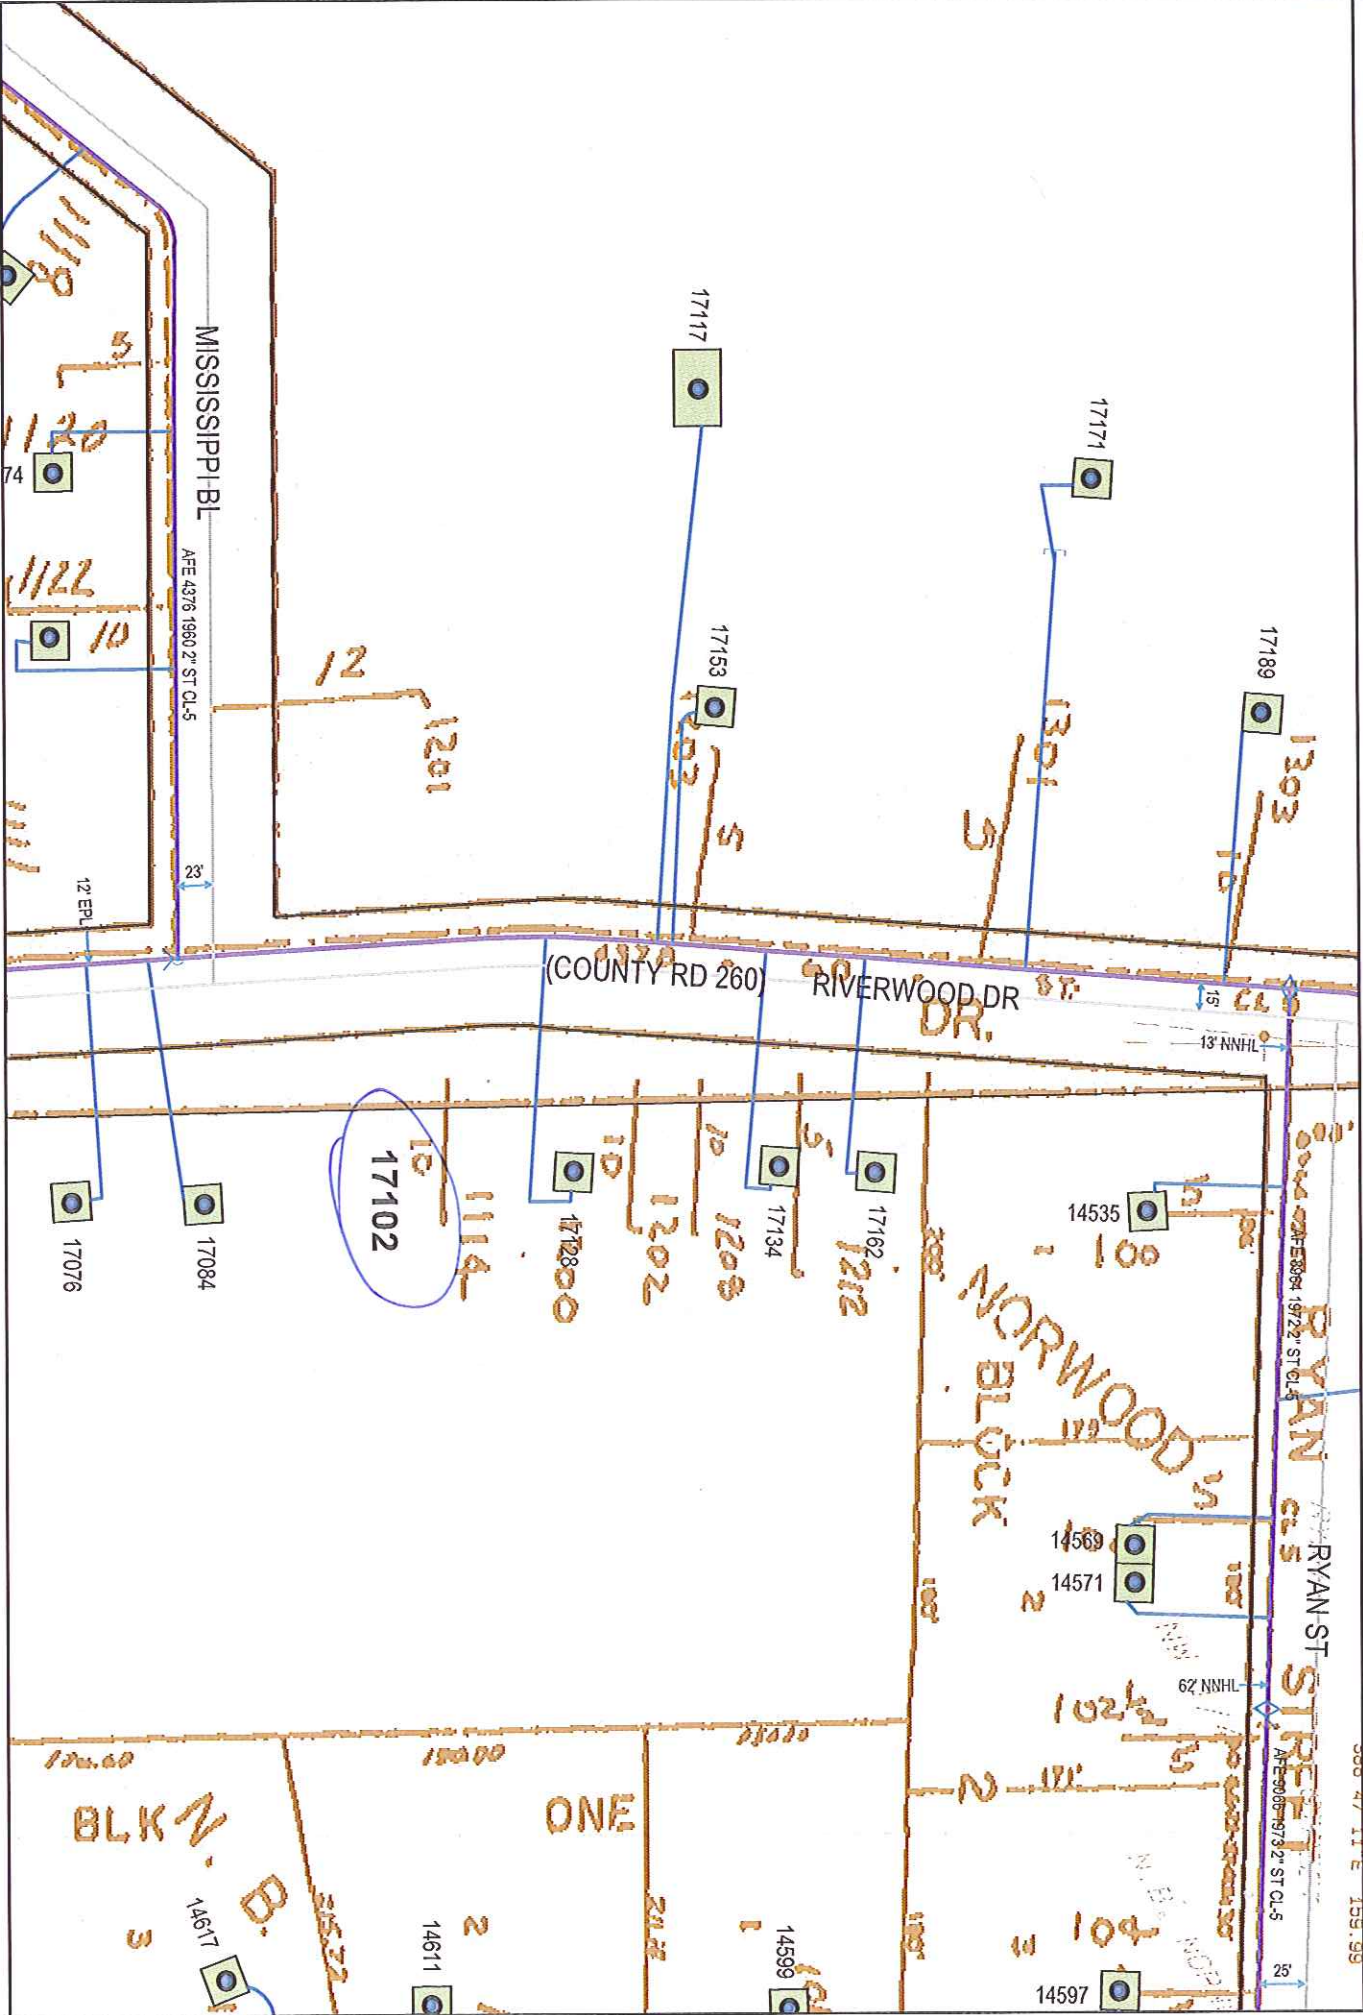

Plotted by: i217335

Plot Date: 10/21/2013

17102 RIVERWOOD DRIVE

LITTLE FALLS

Scale: 1" = 100'

