



CSAH 15

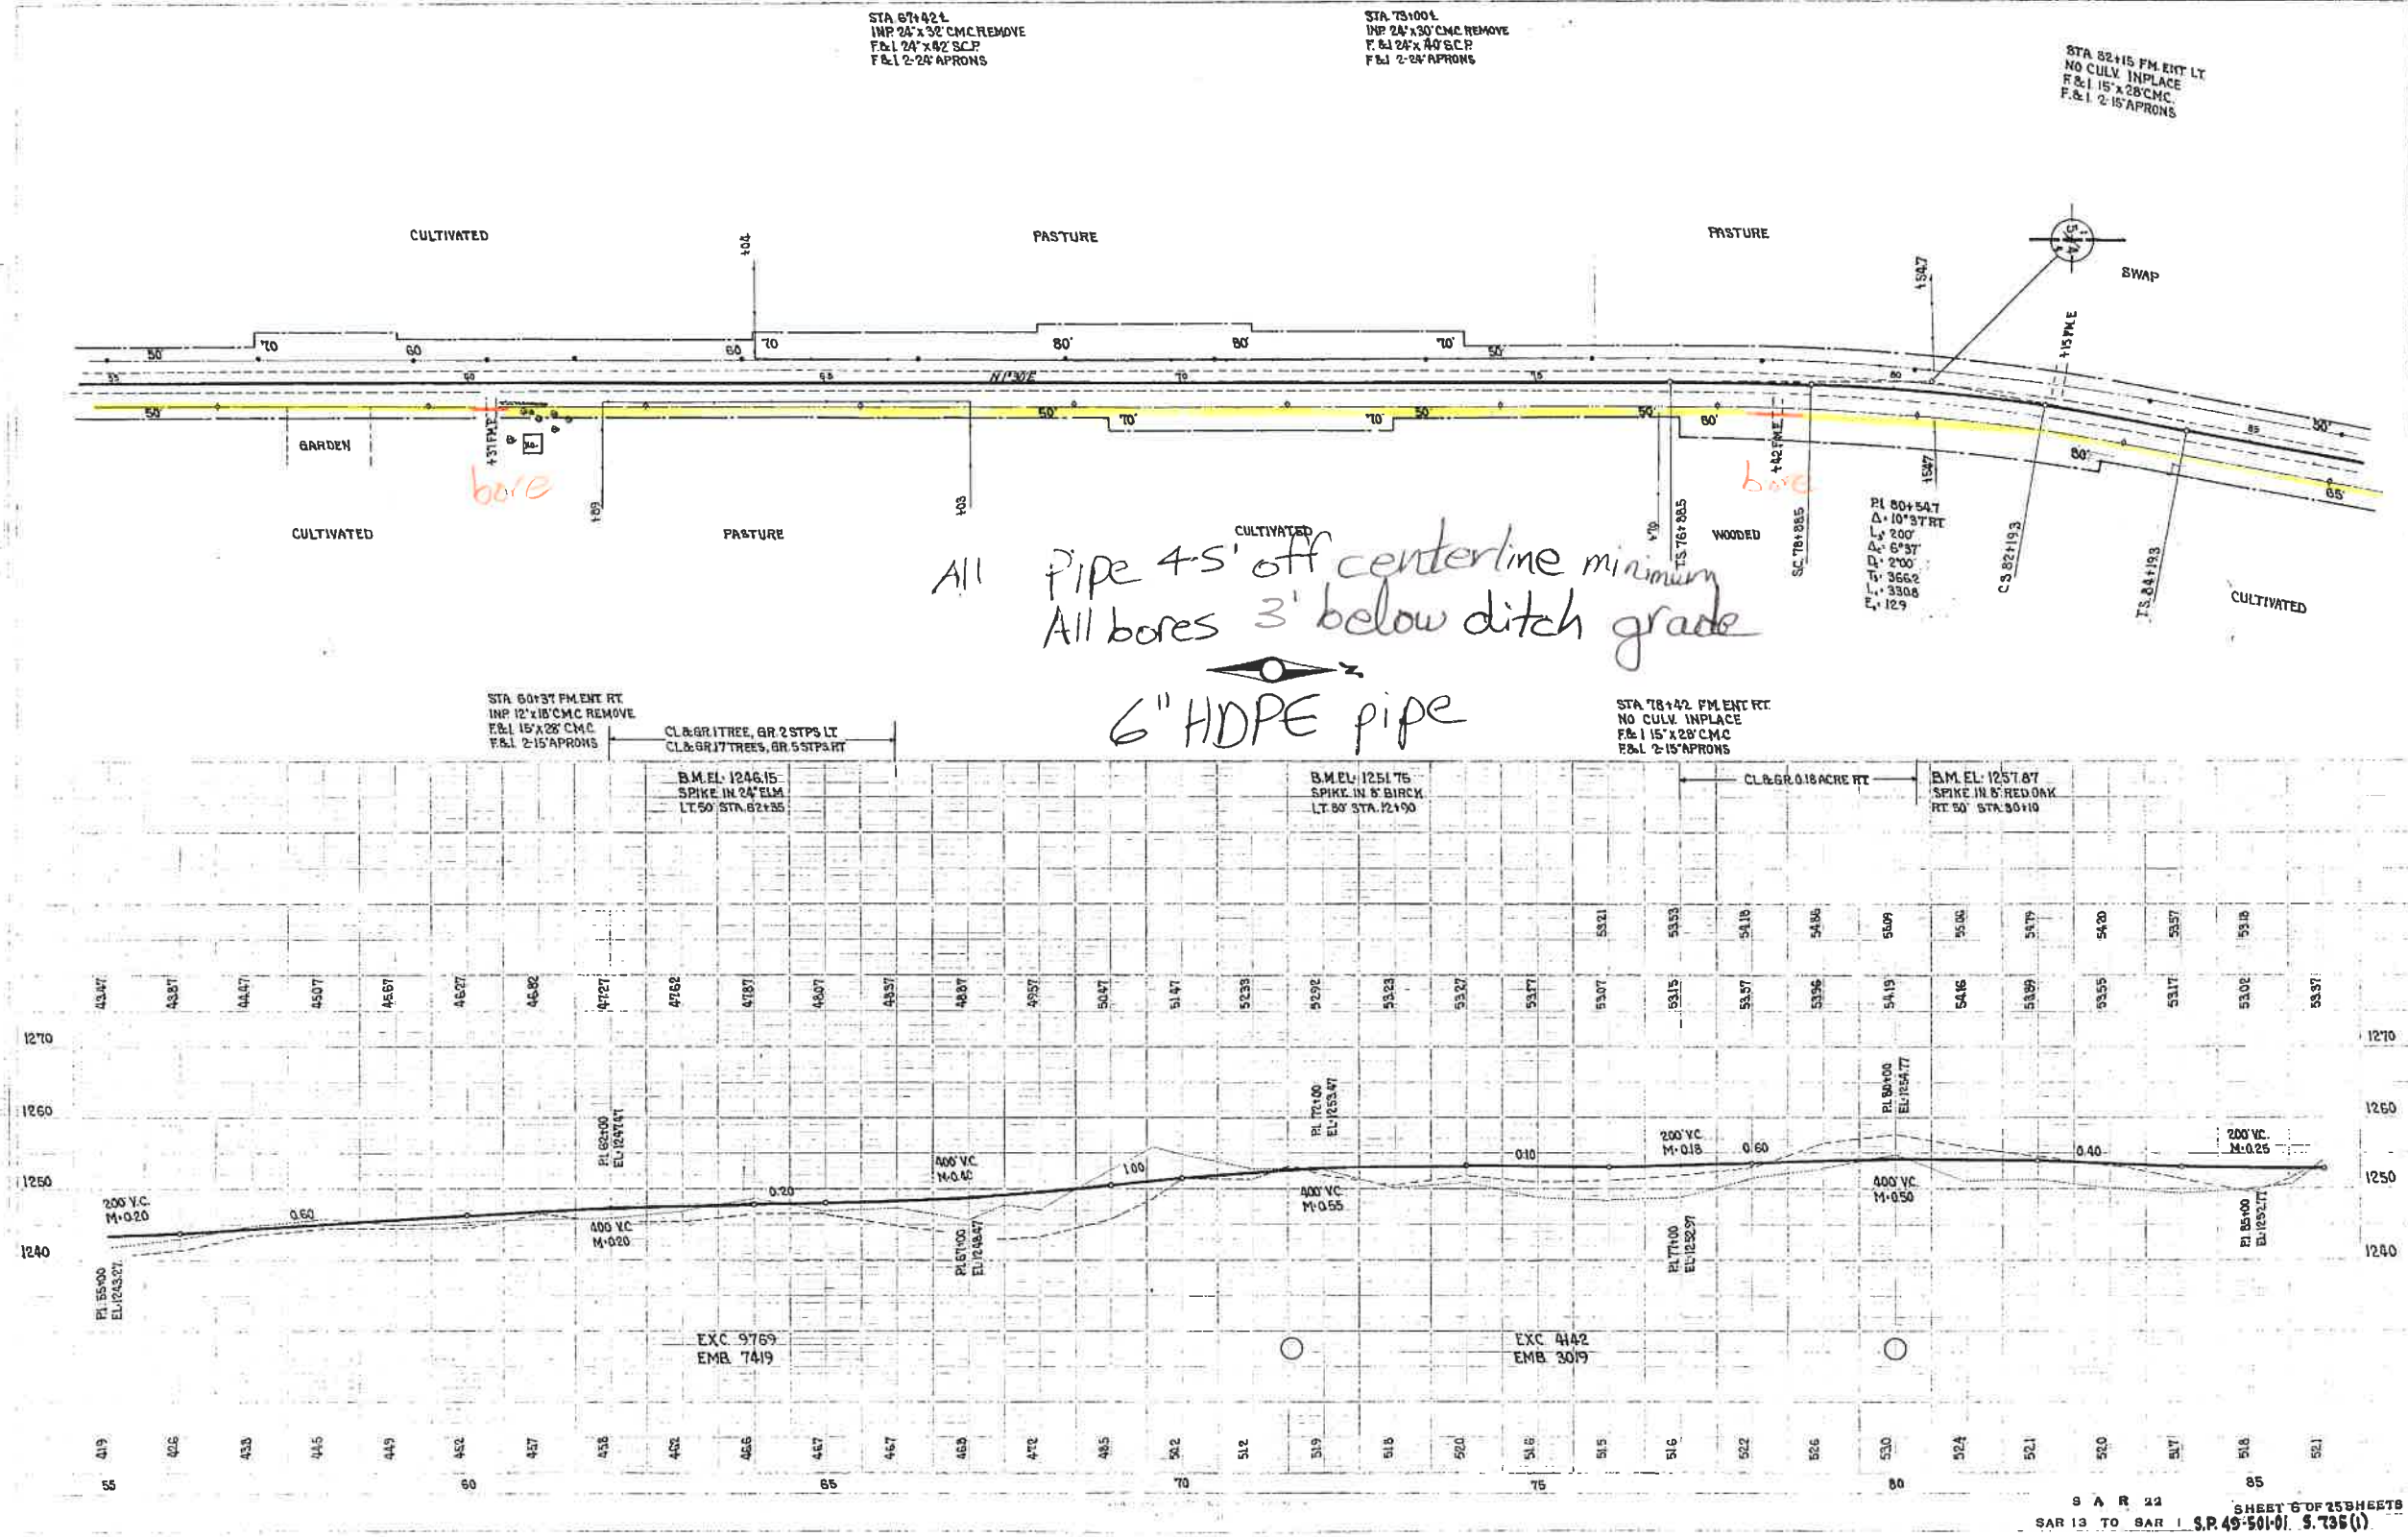


CSAH 15

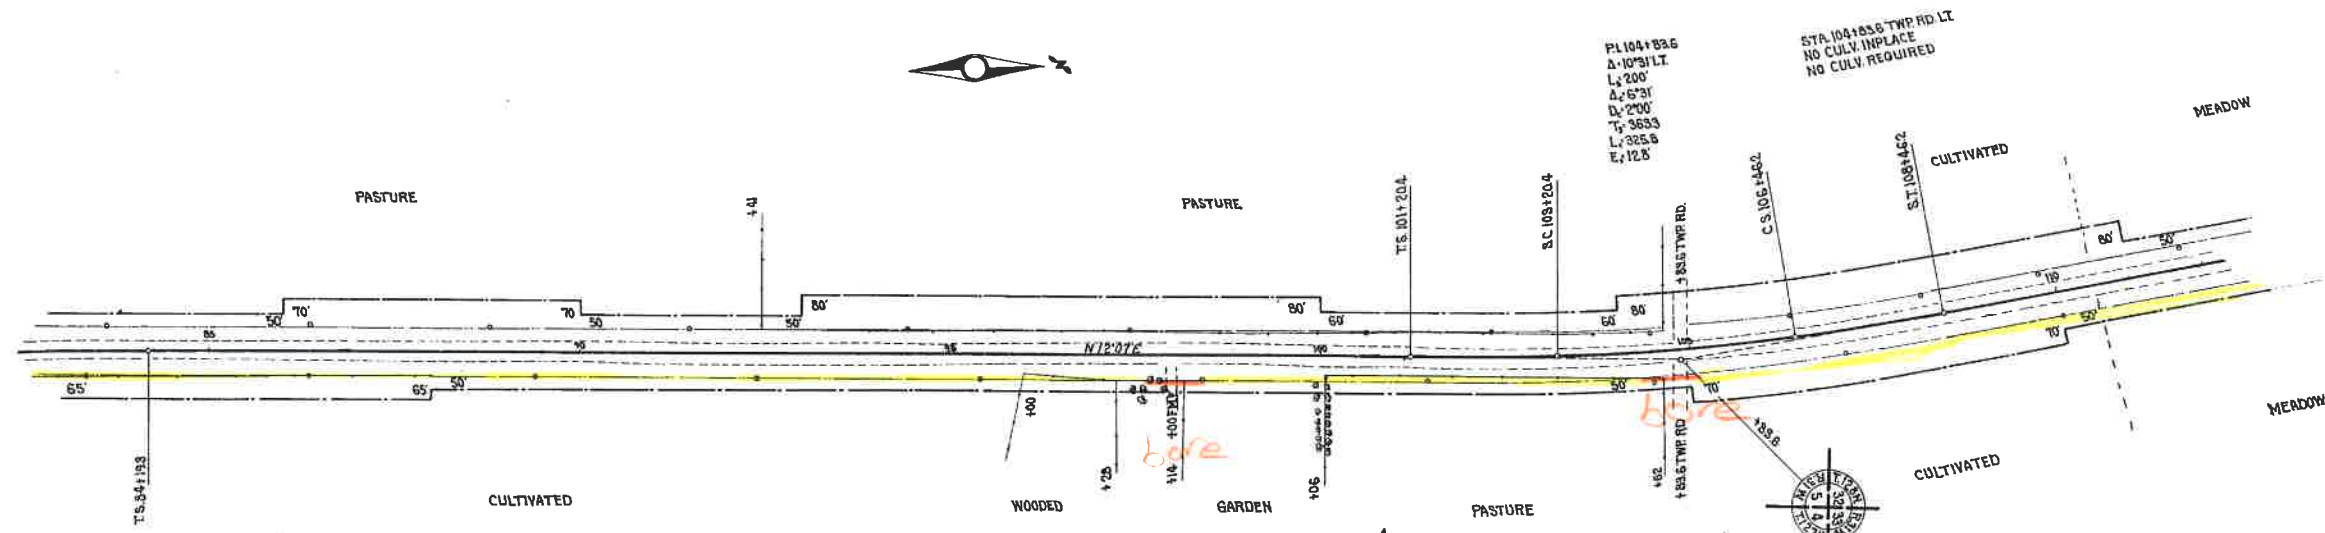


All pipe minimum 45'
off centerline


All bores 3' below ditch grade
6" HDPE PIPE

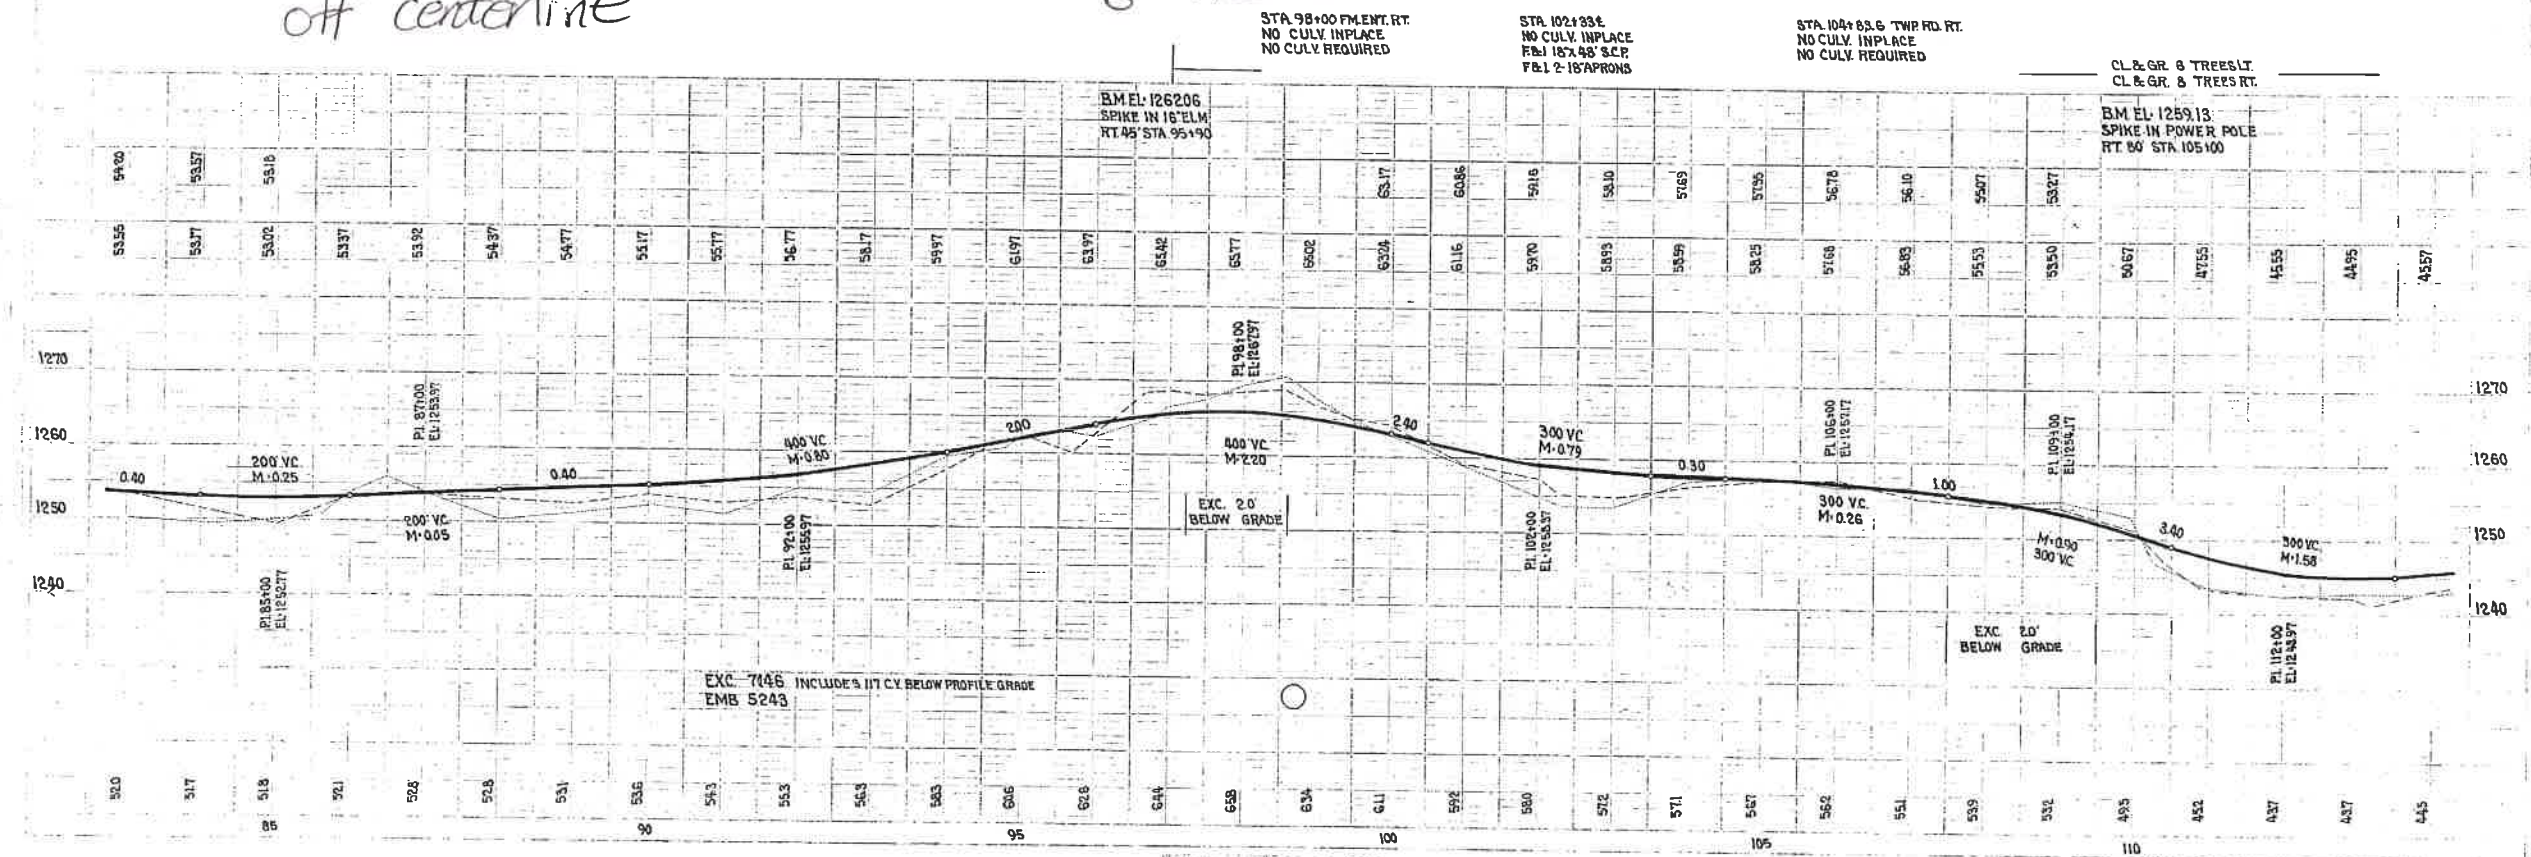

CSAH 15

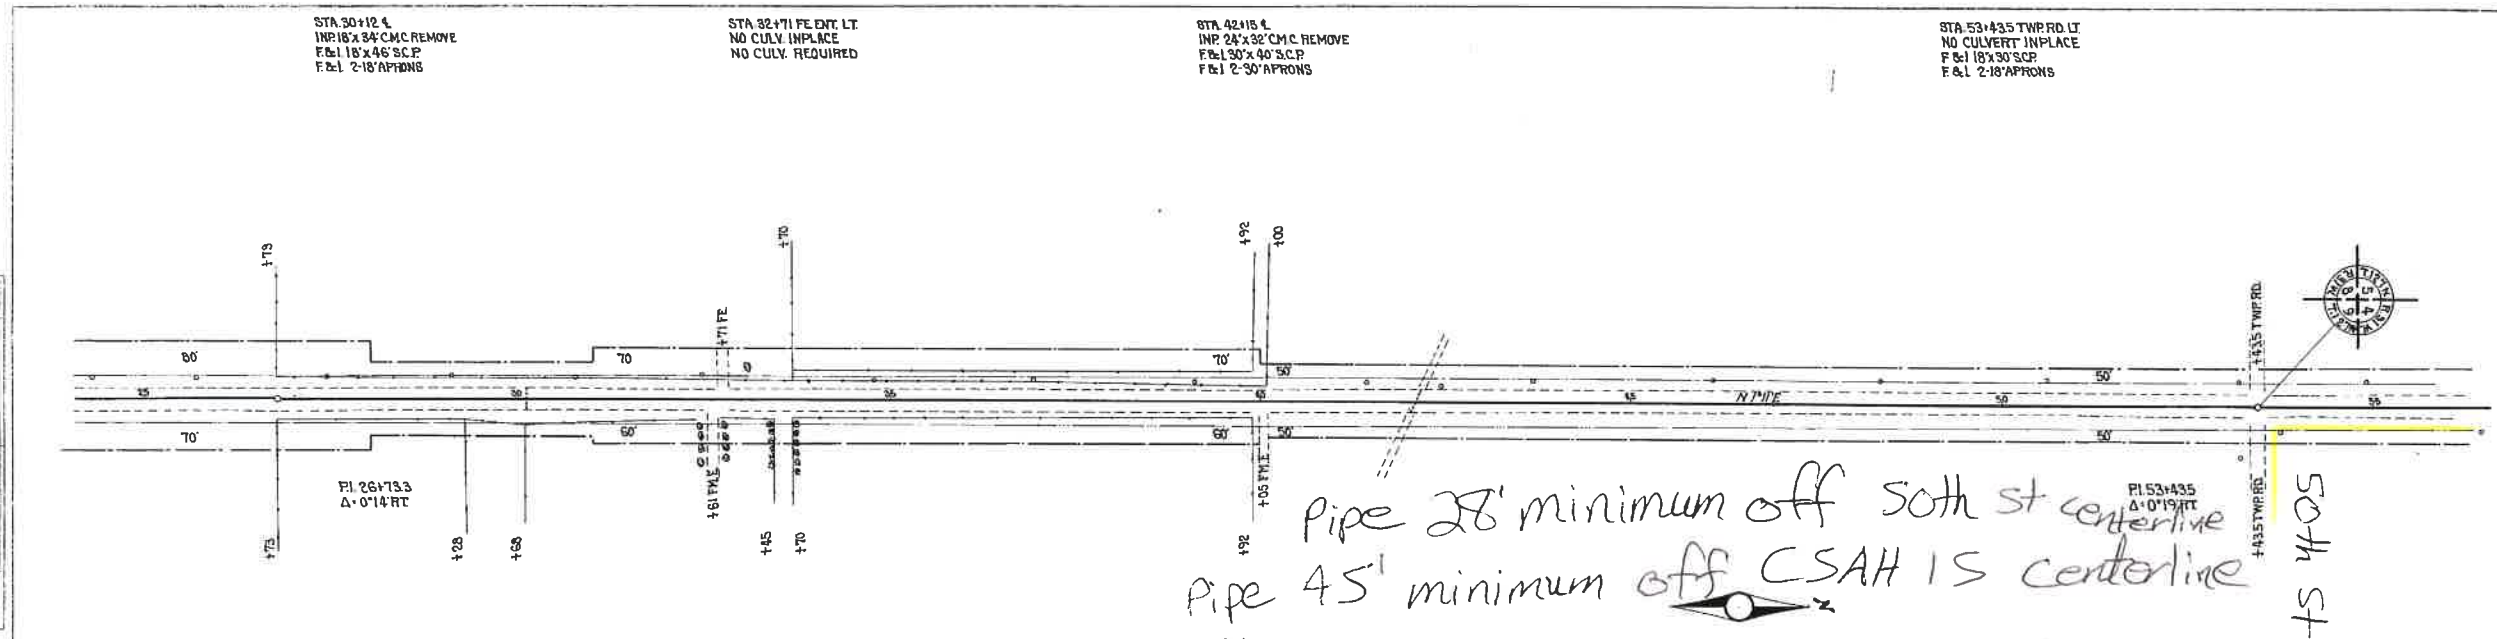

Pipe 28' minimum off south st centerline
 Pipe 45' minimum off CSAH 15 centerline
 6" HDPE pipe

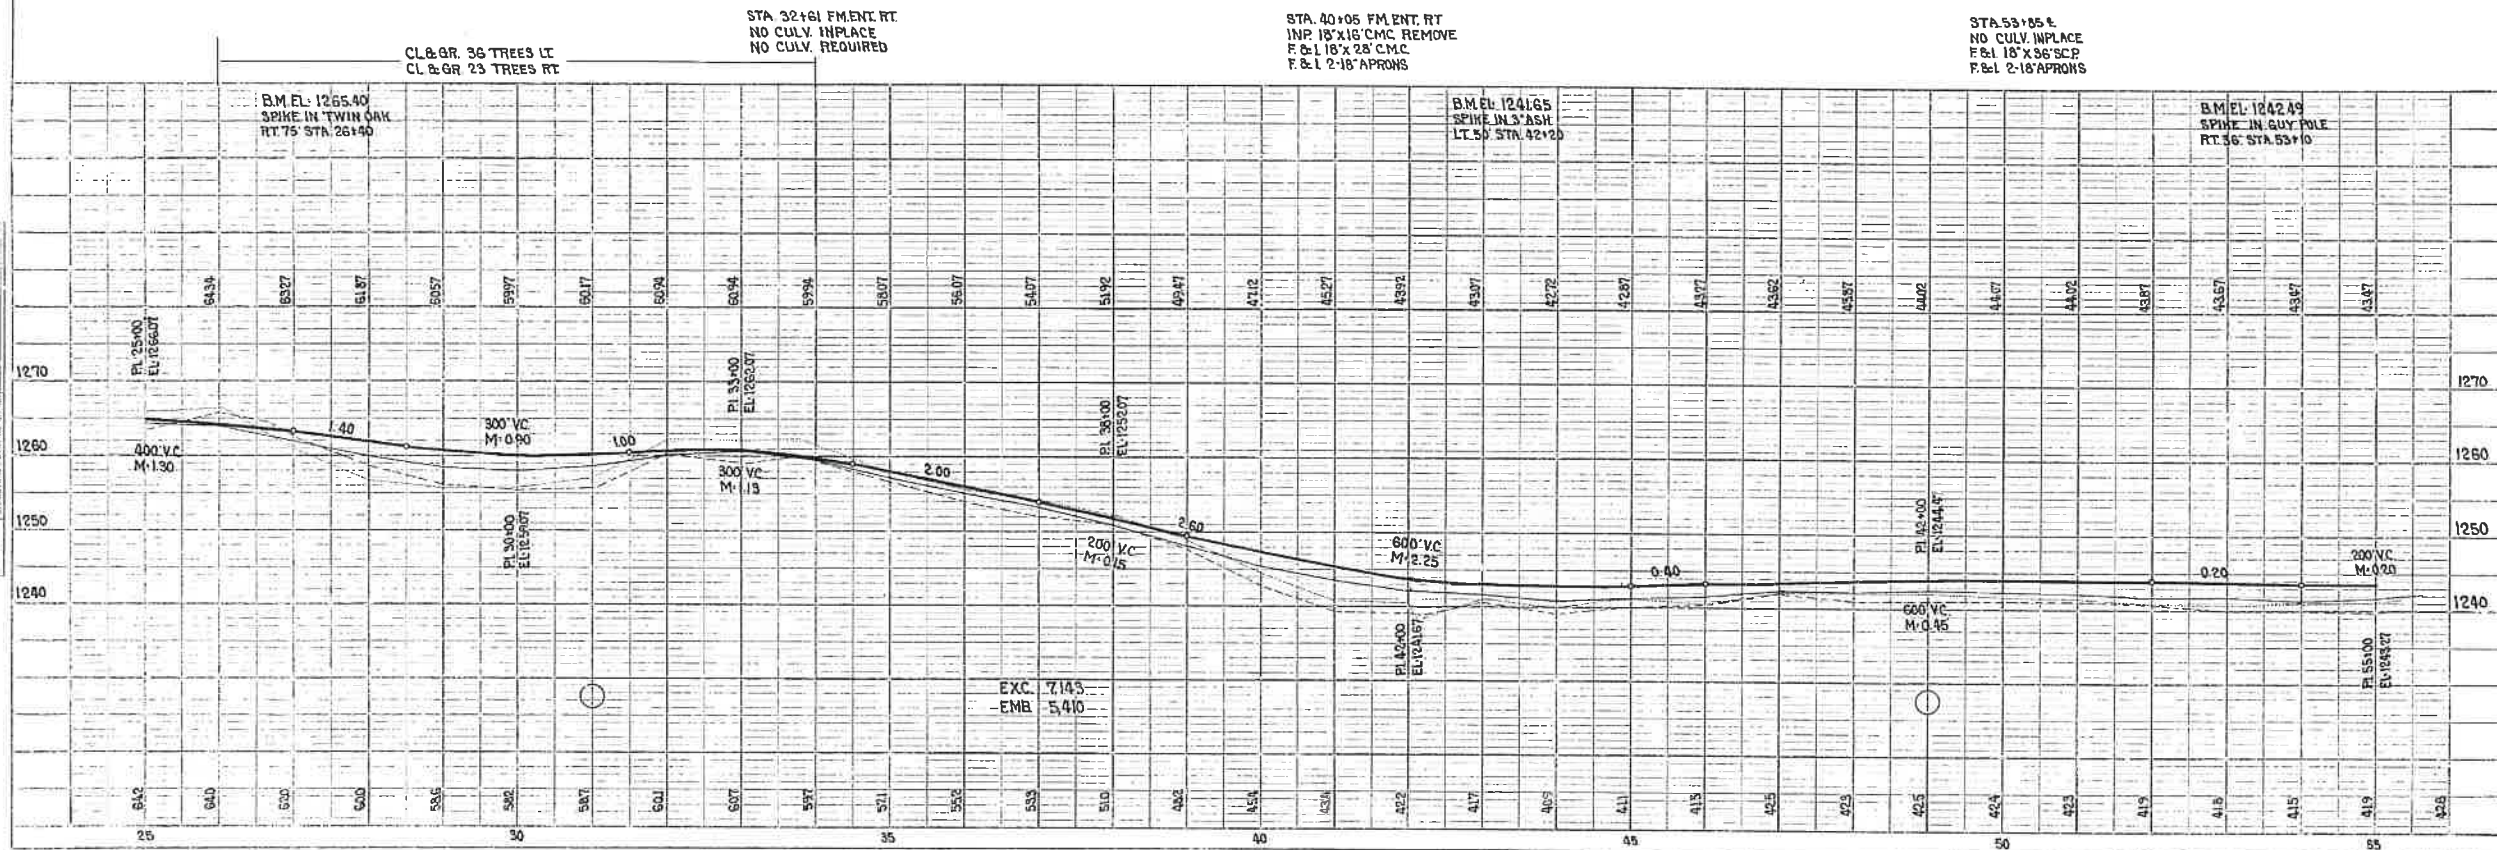

DATE	DESCRIPTION

DATE	DESCRIPTION

PLATE 1 - PLAN PROFILE - 1/4" = 1' HORIZONTAL
 1/8" = 1' VERTICAL