


CenturyLink Constant Job Order/Maintenance Work Authorization

Company T600 Exchange Little Falls Service Order# N57482396
 Work Activity Buired Drop-Copper Capital x Maintenance _____
 Customer Name Delroy Thommes Phone# 3206328739
 Address 10465 Iris Rd One Call Ticket# _____
 Location/Directions _____
 Description of Work or Special Instructions new service

DOR/TOG Yes ___ No ___ Permit: Yes ___ No ___ Bore: Yes ___ No ___ CBR# 3206328739
 Employee Name Robert Meyer Employee Contact# 3202919640

Sketch (Include Line & Pedestal)	Material/Labor Units		Est Qty.	Actual Qty.	Placed by (Foreman/Crew Name)
	Description	Notes			
Line	SEBP3-22	Place 3 pair BSW	350		
Ped# <u>2093</u>	BM83	BSW Guard	1		
County <u>morrison</u>	BM2C	Place BSW Bond	1		
	HC1E	Splice Pair at Ped	1		
Township <u>40n</u>	XXSEB-GL	Remove Temp Drop	350		
Section <u>25</u>					
Range <u>32w</u>	BM61(1.5)D	Underground Bore 1.5"			
GPS Reading					

Nearest cross st. _____ Plat Page _____ Map# _____
 Damaged facility # _____
 TOWNSHIP NAME Little Falls
 SKETCH

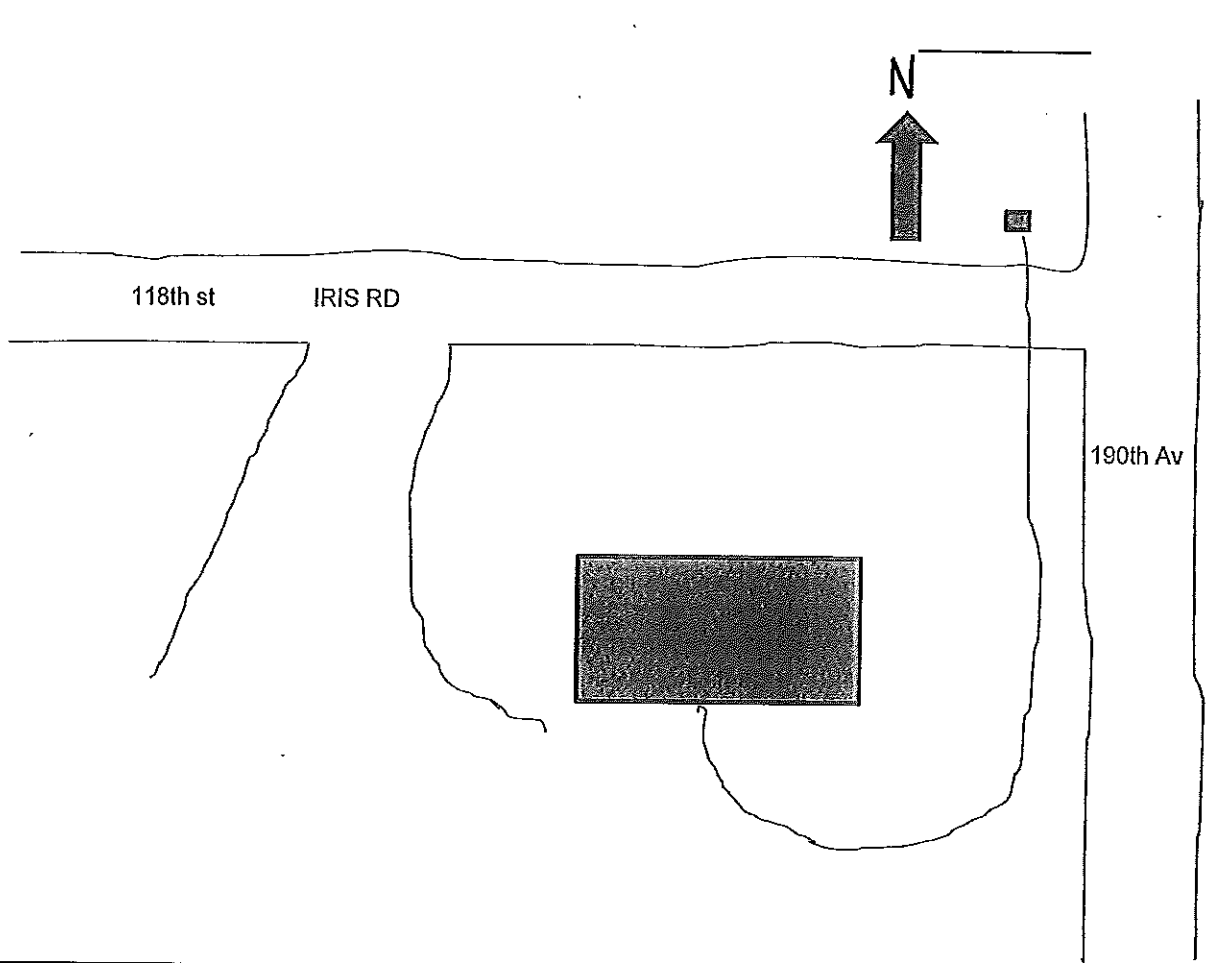

Originated By: Meyer Date: 11/21/13 Completed By: Mark Howard Date: 11/24/13
 Authorized By: _____ Date: _____ Inspected By: _____ Date: _____
 Inspection notes: _____