


7435  
7419  
B  
T-21238  
239

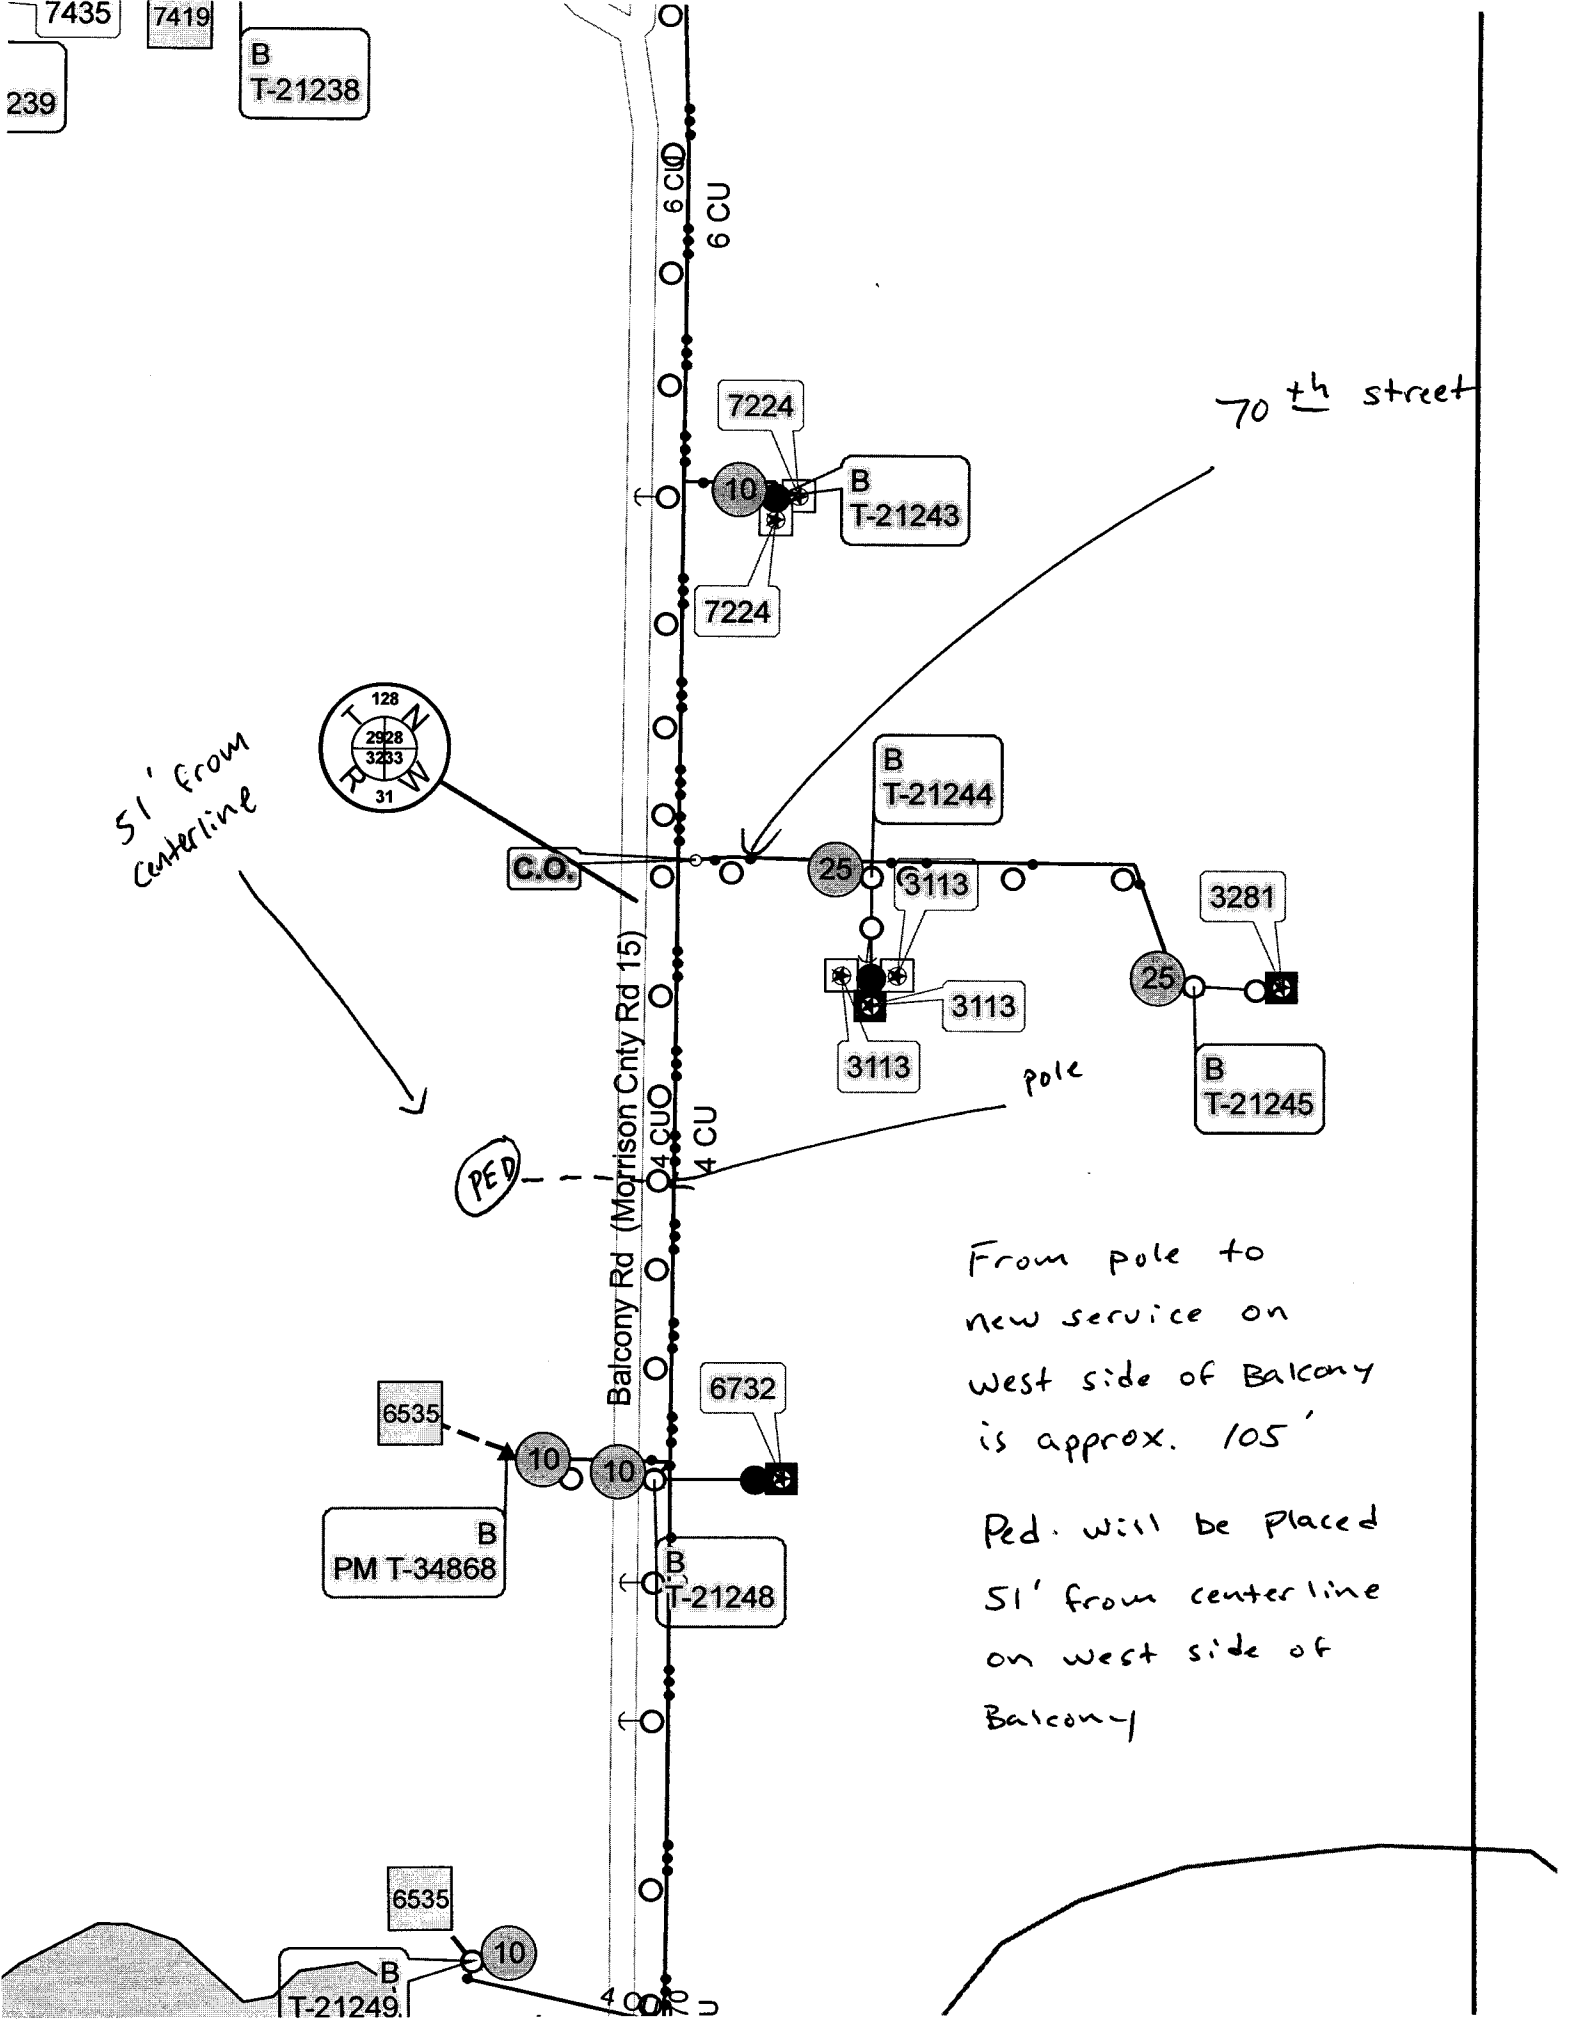

From pole to new service on west side of Balcony is approx. 105'

Ped. will be placed 51' from centerline on west side of Balcony