


GENERAL LOCATION ONLY. DO NOT USE TO LOCATE FOR EXCAVATION. CALL 1-800-252-1166 FOR ONSITE LOCATIONS AND STAKING.

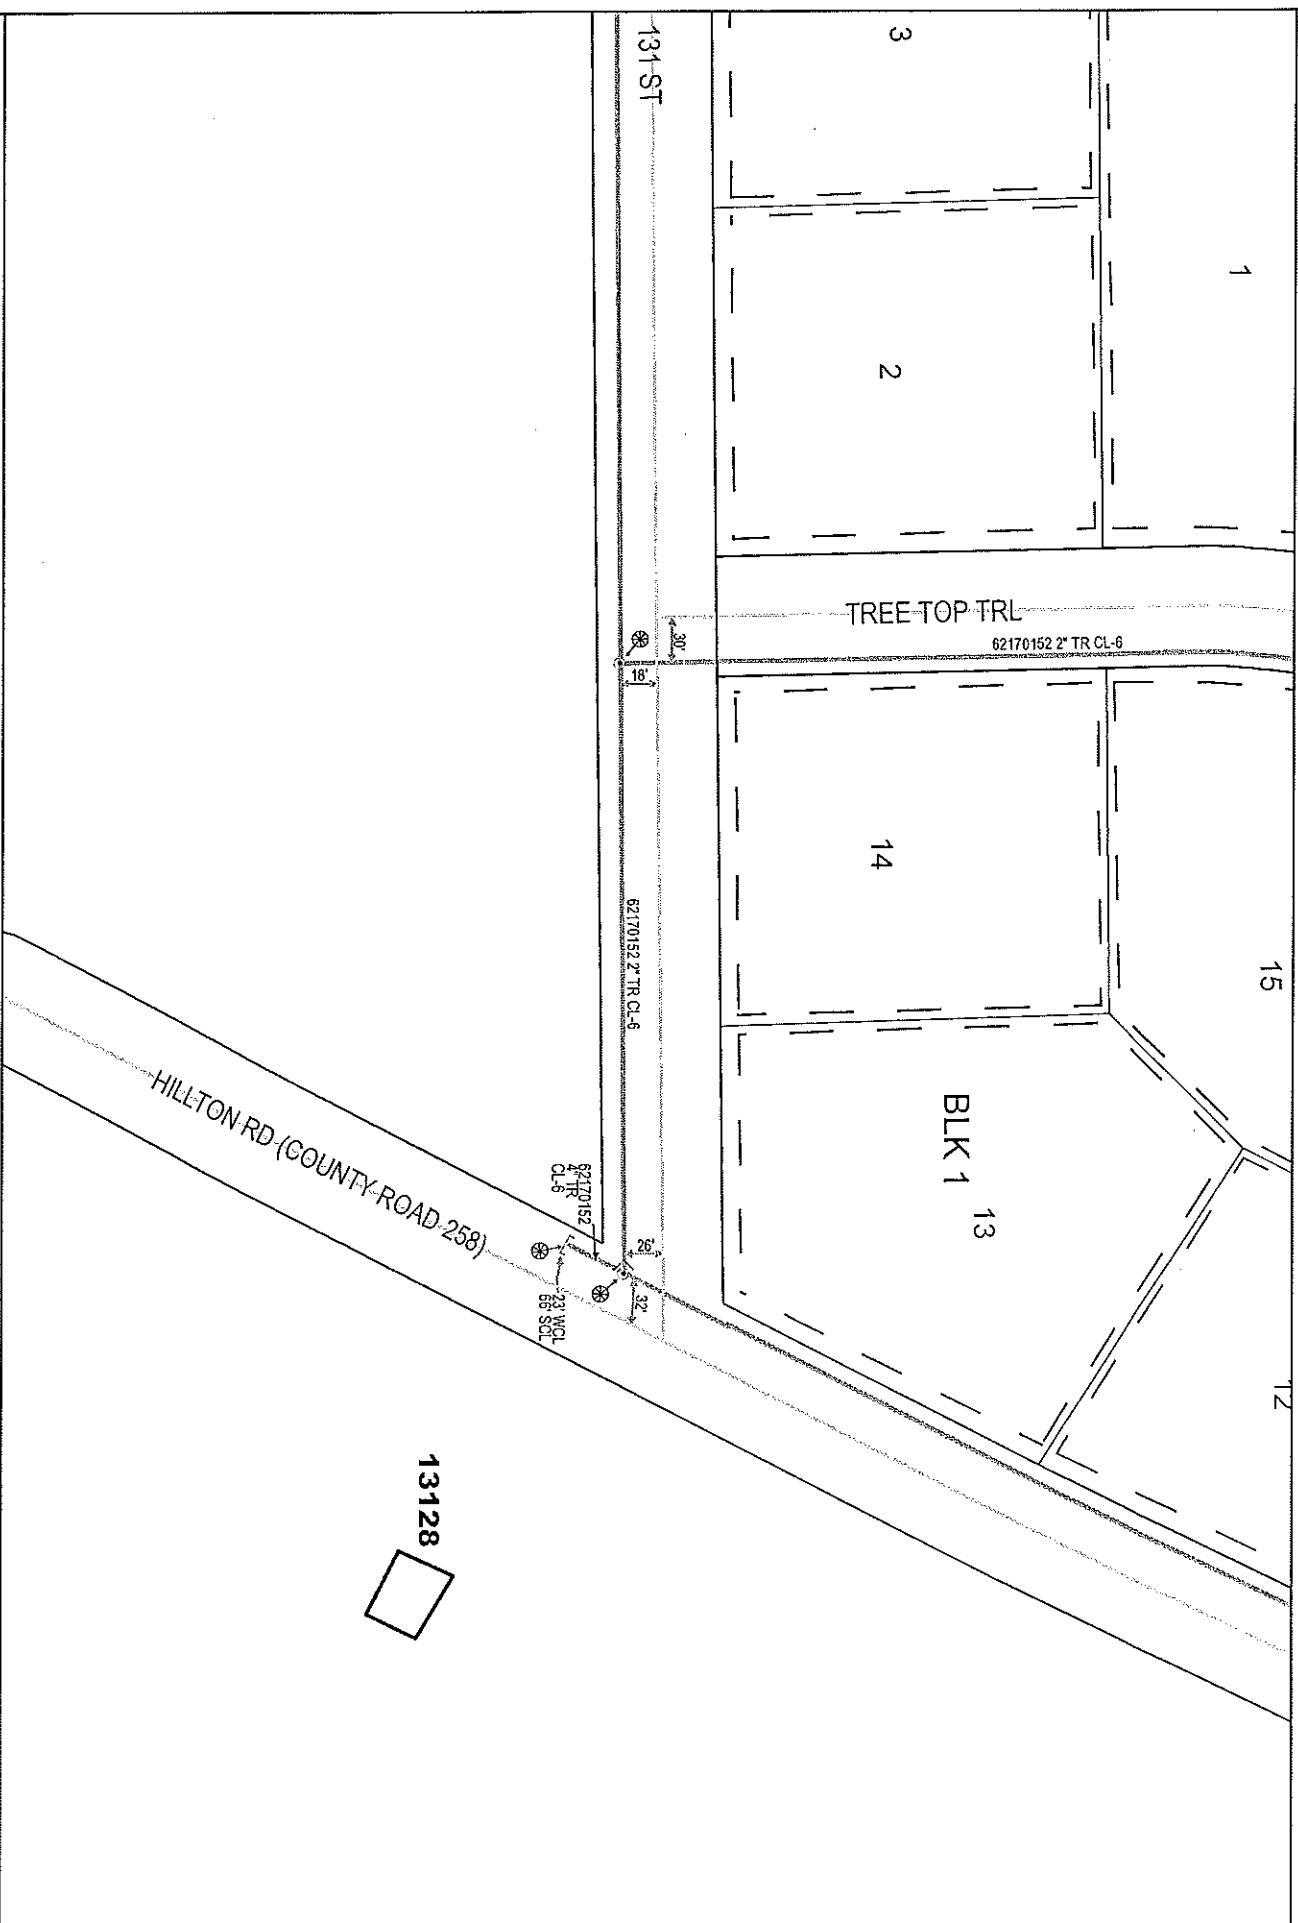

Plotted by: 1217736  
Plot Date: 11/21/2013

13128 Hillton Rd (Morrison County Road 258)  
LITTLE FALLS TWP MN 56345

Scale: 1" = 100'  
GentlePoint Energy  
North