


GENERAL LOCATION ONLY. DO NOT USE TO LOCATE FOR EXCAVATION. CALL 1-800-252-1166 FOR ONSITE LOCATIONS AND STAKING.

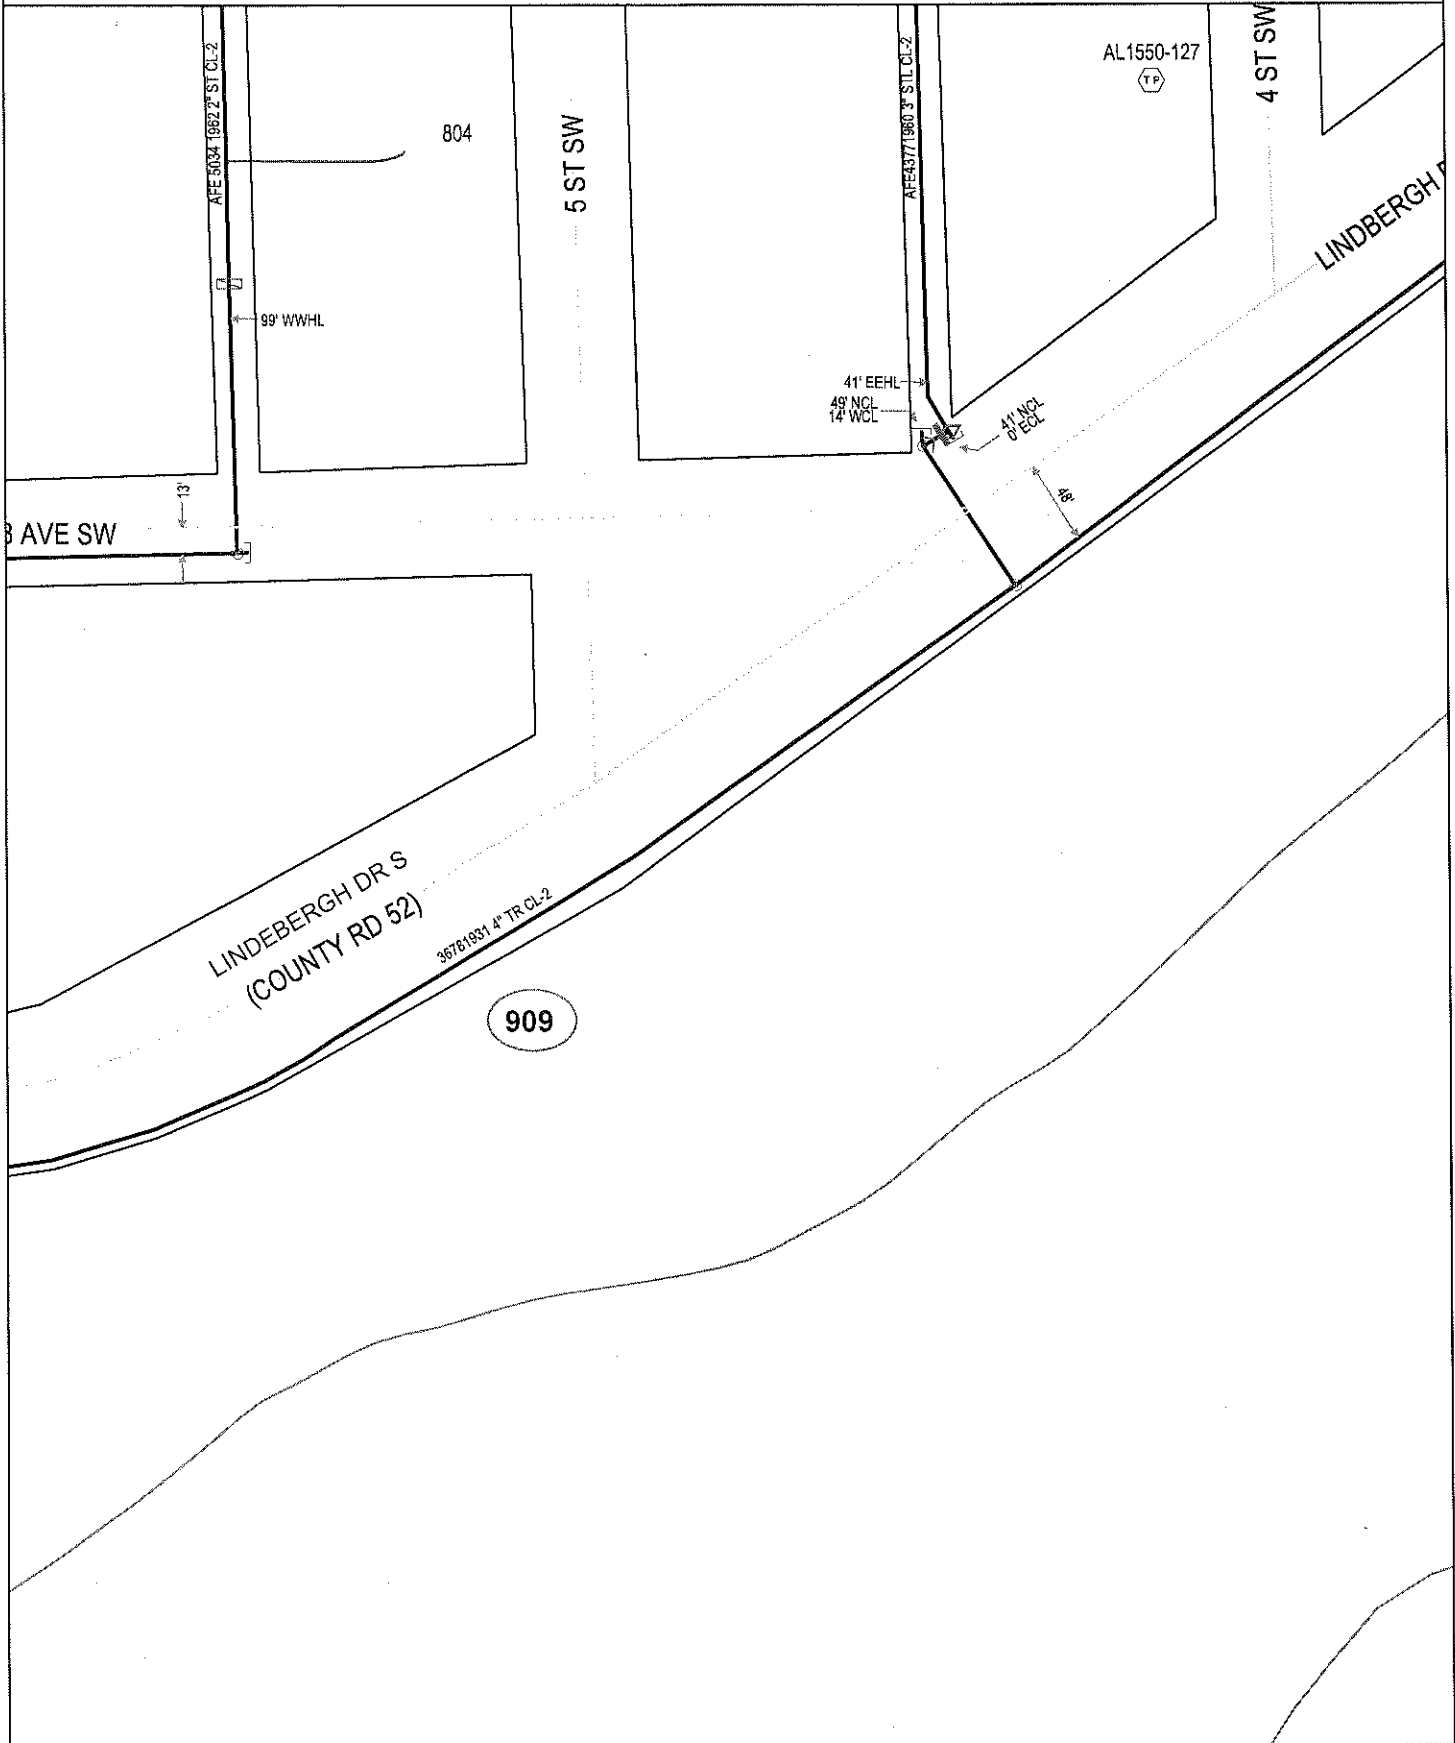

Plotted by: i220531
Plot Date: 4/17/2015

909 LINDBERGH DR S
LITTLE FALLS (COUNTY RD 52)

Scale: 1" : 100'
CenterPoint Energy
North