


HOUSING NO.	BA	BDO			BFO				BH	BM						HBF		HO		NID		SUB NO.		SE		UD		UO		
																									</					

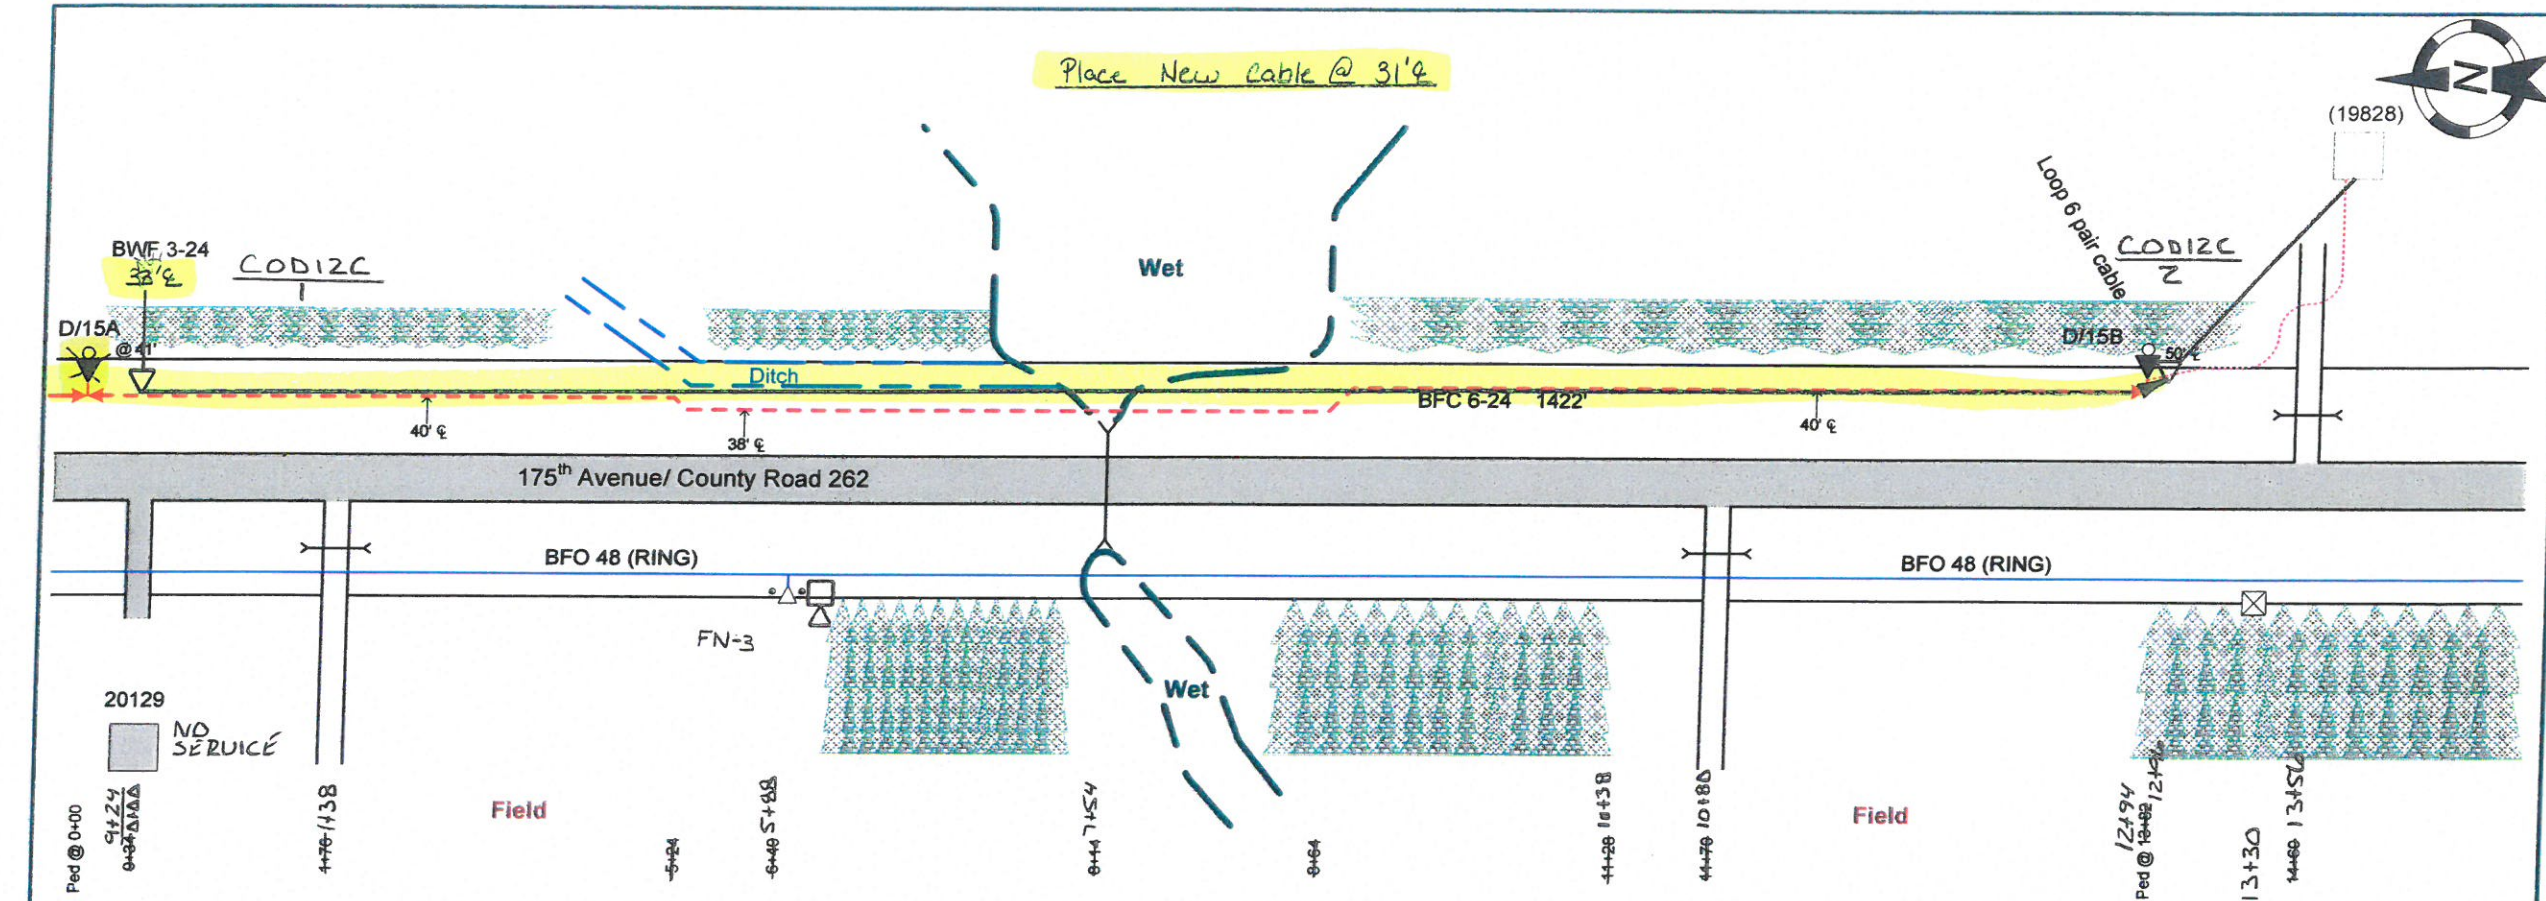

From	To	PType	Units	Feet	BA	BM	HC	W	Remarks
D/15A	D/15B	BD3A	BFC 6-24	1422	3	2(5/8)(8)	1	BD 3A 1	

**As Staked**

**Consolidated Telephone Company**

Name: 2012 RST6 D Sheet 1 of 1

WO: 2012 - Freedhem

Exch: Freedhem

Route: CDD12C

ROW: Public

State: Minnesota

County: Morrison

Range: 31W

Twsp: 41N Section: 8

Township: Belle Prairie

Staked By: EMD Date: 5-9-12

Revised By: LRR Date: 3-9-15

Revised By: Date:

Revised By: Date:

As-Built By: Date:

Sheet No. 04 of 04