

From	To	PType	Units	Feet	BM	Remarks
(C.O.: COB/1)	C.O.: COB/2	BDO5(SGC)	BFO 72D &	4032	2(5/8)(8) 1	
	C.O.: COB/2		BFO 48D D	3984	53 2	
	C.O.: COB/2				60(2)(1.5) 500	

**As Built Consolidated Telephone Company**

Name: COB-04

WO: Freedhem-2013 Ring

Exch: Freedhem

Route: COB

ROW: 33'

State: Minnesota

County: Morrison

Range: 31W

Twsp: 41N Section: 12

Township: Belle Prairie

Staked By: ZBG Date: 4/19/13

Revised By: JS Date: 10/15/13

Revised By: \_\_\_\_\_ Date: \_\_\_\_\_

Revised By: \_\_\_\_\_ Date: \_\_\_\_\_

As-Built By: CLP Date: 10/25/13





DISTANCE FROM ♀ ROAD

SEE NOTATION


STAKED BY: EDB      DATE: 1-13-15  
 REV.                      REV.  
 AS BUILT BY:              DATE:



TWP 41 N  
 RNG 31 W  
 SEC 12  
 CO. Morrison

ROUTE: B  
 SHEET: 4.1 OF 18  
 SERVICE AREA: Freedom

CR 265 / 203rd St.

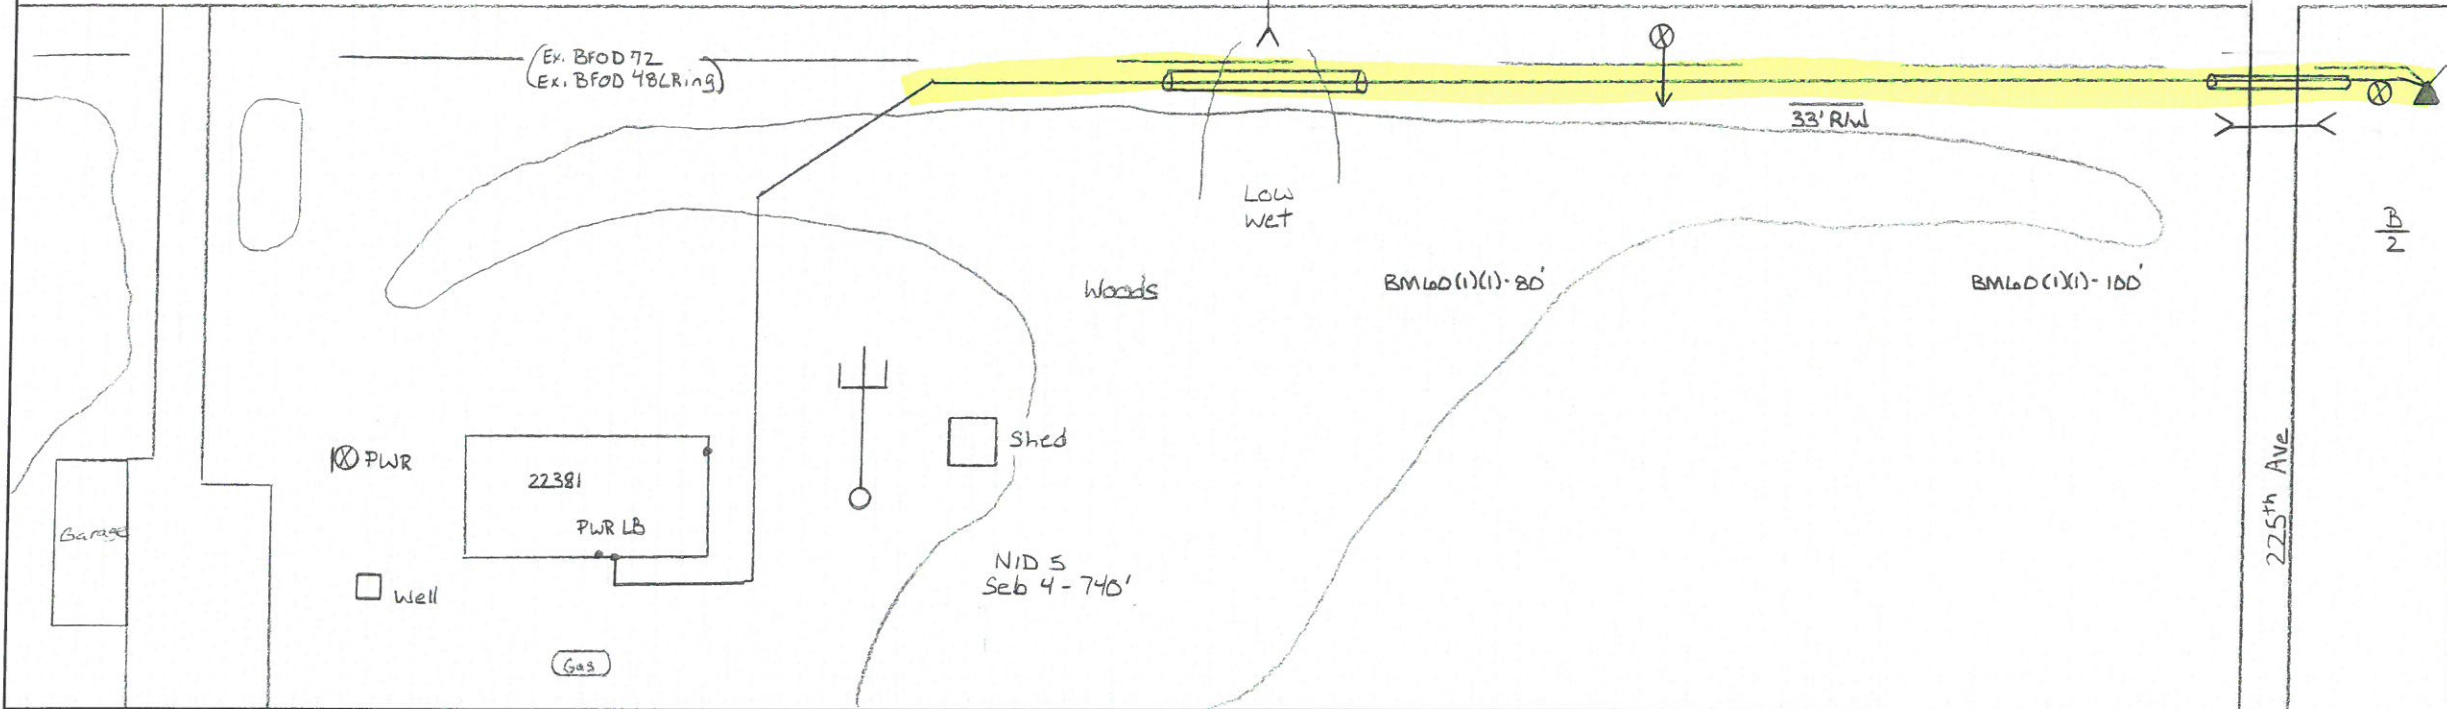

HOUSING NO.	BA	BDO	BFO	BH	BM	HB	HO	NID	SUB NO.	SE	UD	UO

