



DISTANCE FROM ♀ ROAD

SEE NOTATION

STAKED BY: ERR DATE: 1-13-15

REV. REV.

AS BUILT BY: DATE:




PROJECT: MN 537

EXCHANGE: Freedhem

TOWNSHIP: RIPLEY

TWP 42 N
RNG 31 W
SEC. 9

ROUTE: IA
SHEET: 3 OF 19
SERVICE AREA: Freedhem

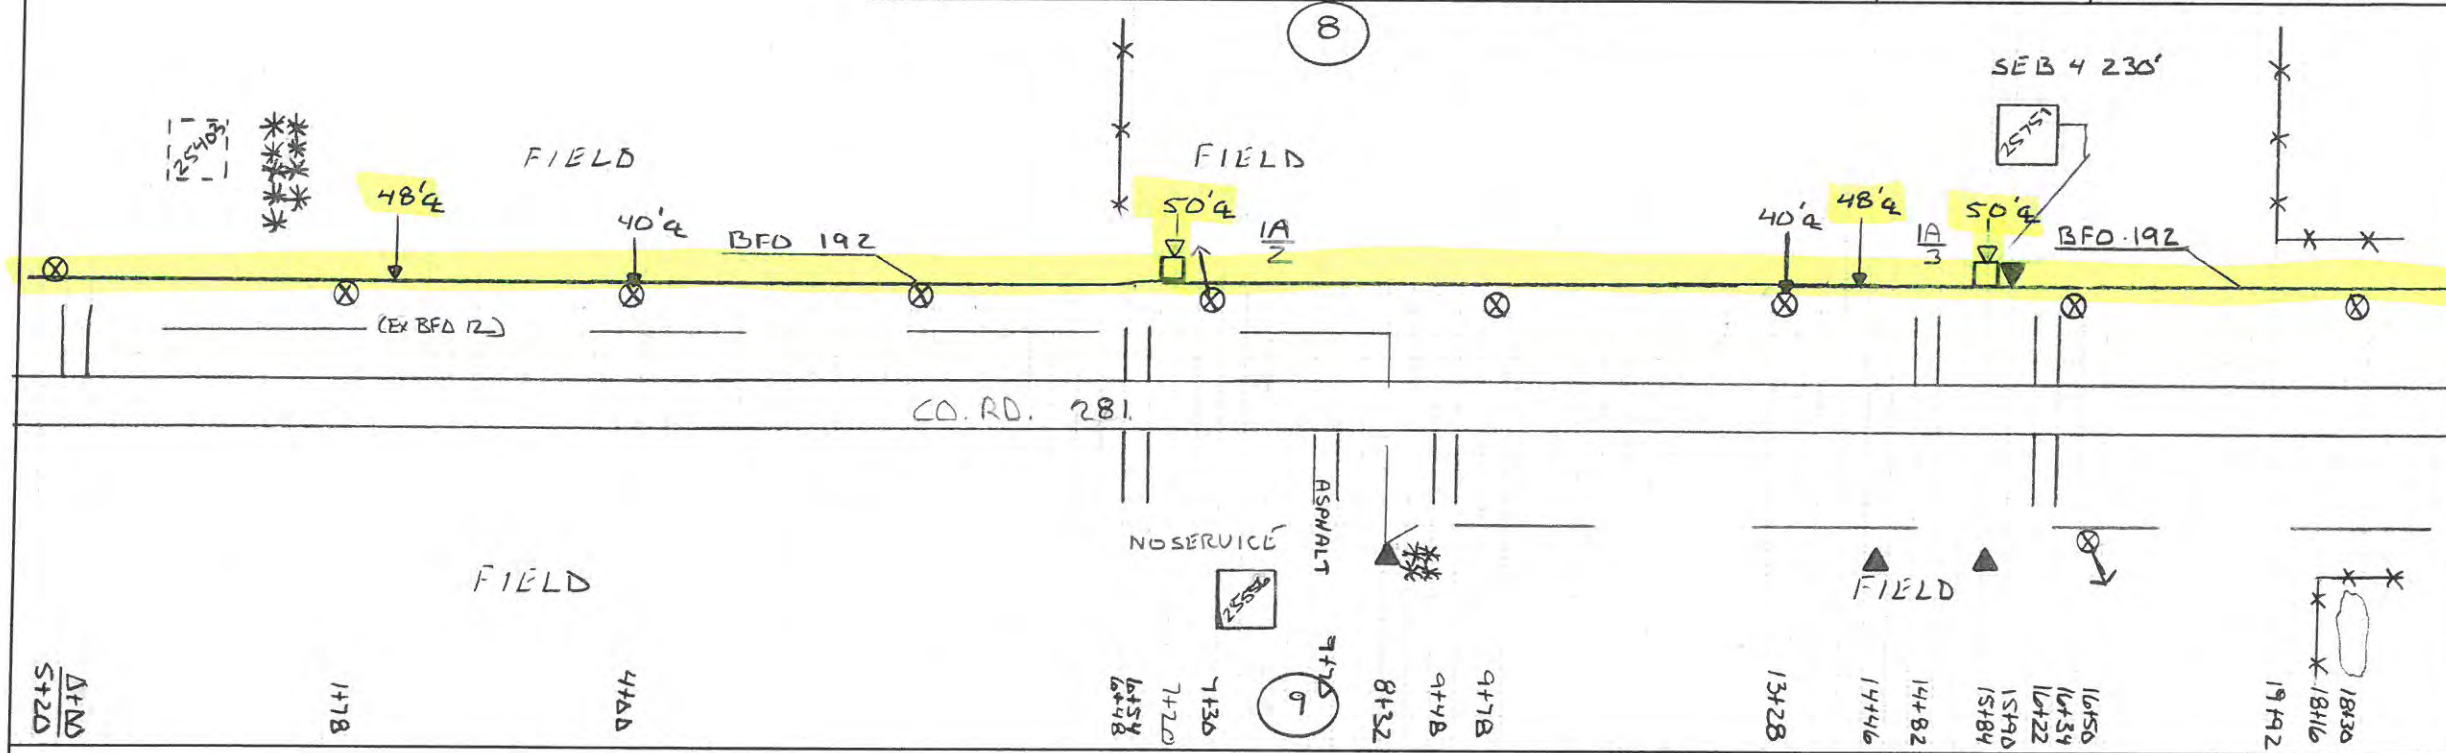

HOUSING NO.	BA	BDO	BFO	BHF	BM	HBF	HO	NID	SUB NO.	SEB	UD	UO
	3	3 (AG)	192	36x66 x 36x7	Z (E/B) (B)	53 A		3			(1X1-1.25) S	
2	1	1	986								10	
3	1	1	1134					1	25751	230	10	
	2	2	2120					1		230	20	



DISTANCE FROM C ROAD

SEE NOTATION

STAKED BY: RJB DATE: 01-12-15

REV. _____ REV. _____

AS BUILT BY: _____ DATE: _____



TWP: 42 N

RNG: 31 W

SEC: 17 8
16 9


CO: Morrison

ROUTE: 1A

SHEET: 2 OF 19

SERVICE AREA: Freedhem

SEE 1B 10F12

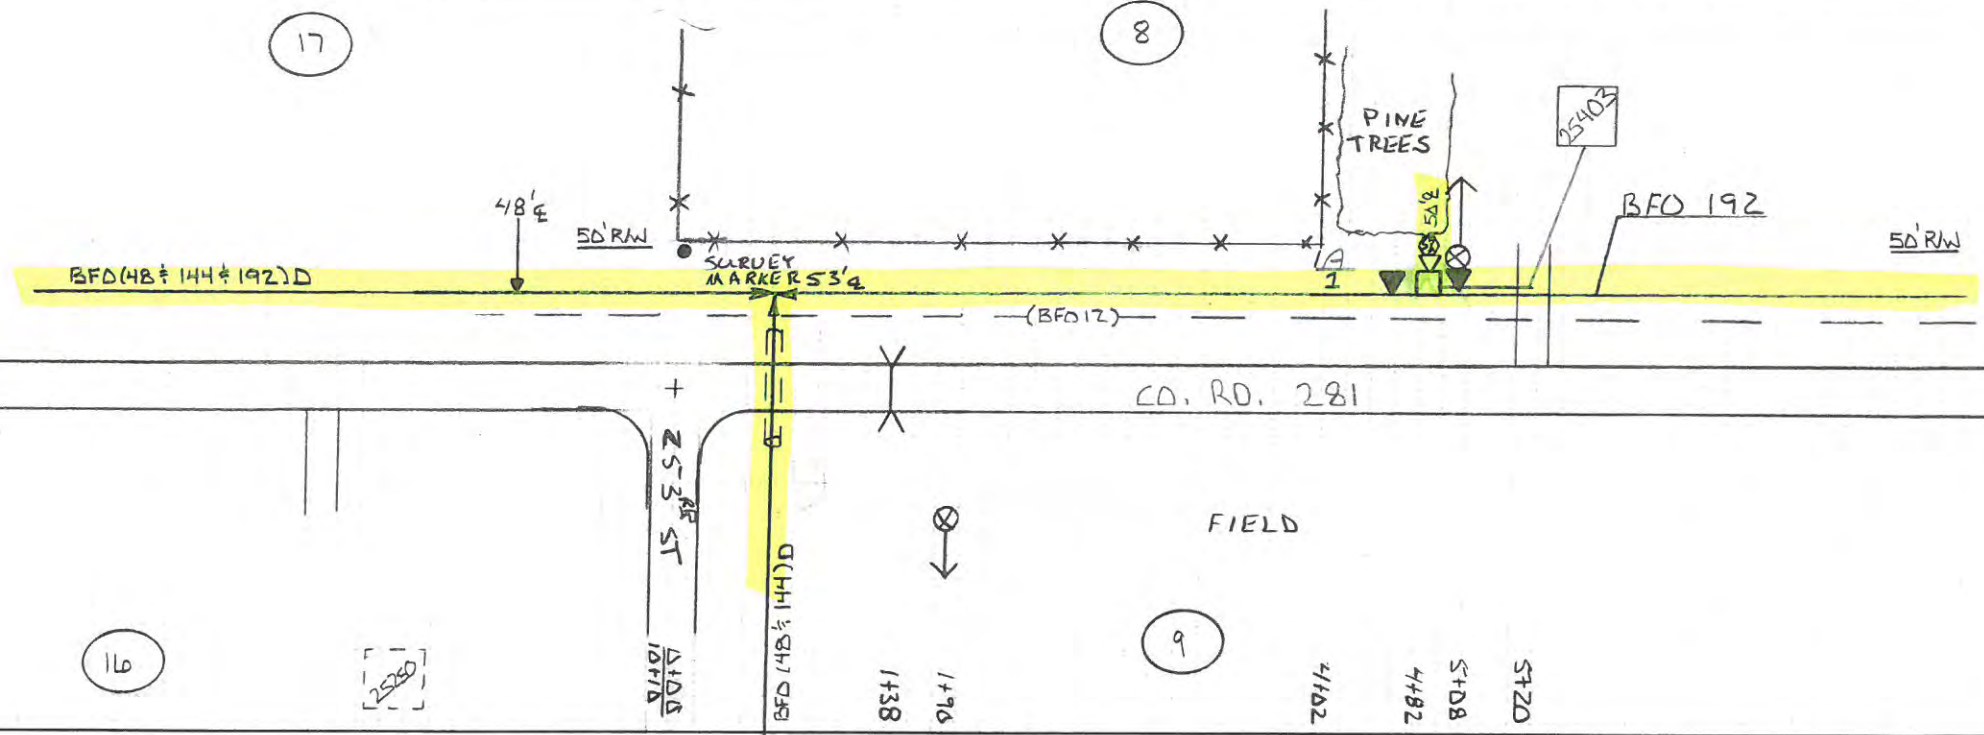

SEE 1B SHT 20F12

HOUSING NO.	BA	BDO	BFO	BHF	BM	HBFA	HO	NID	SUB NO.	SEB	UD	UO
3	3	3 (AG)	(48 + 144 + 192)D 192	36x60 x36)T	2 (5bXb) 53A	192 (L)	-1	3		4	(1x1.25) 5	
1	1	1	- - 1140 534	1	1	1	1	1	25043 206	206	1A	
	1	1	1140 534	1	1	1	1	1		206	10	

DISTANCE FROM ♀ ROAD

SEE NOTATION

STAKED BY: *ERR* DATE: *1-15-15*

REV. _____ REV. _____

AS BUILT BY: _____ DATE: _____



PROJECT: MN 537

EXCHANGE: Freedom

TOWNSHIP: RIPLEY

TWP 42 N

RNG 31 W


SEC. $\frac{17}{16} \frac{8}{9}$

CO. Morrison

ROUTE: 13

SHEET: 1 OF 12

SERVICE AREA: Freedom

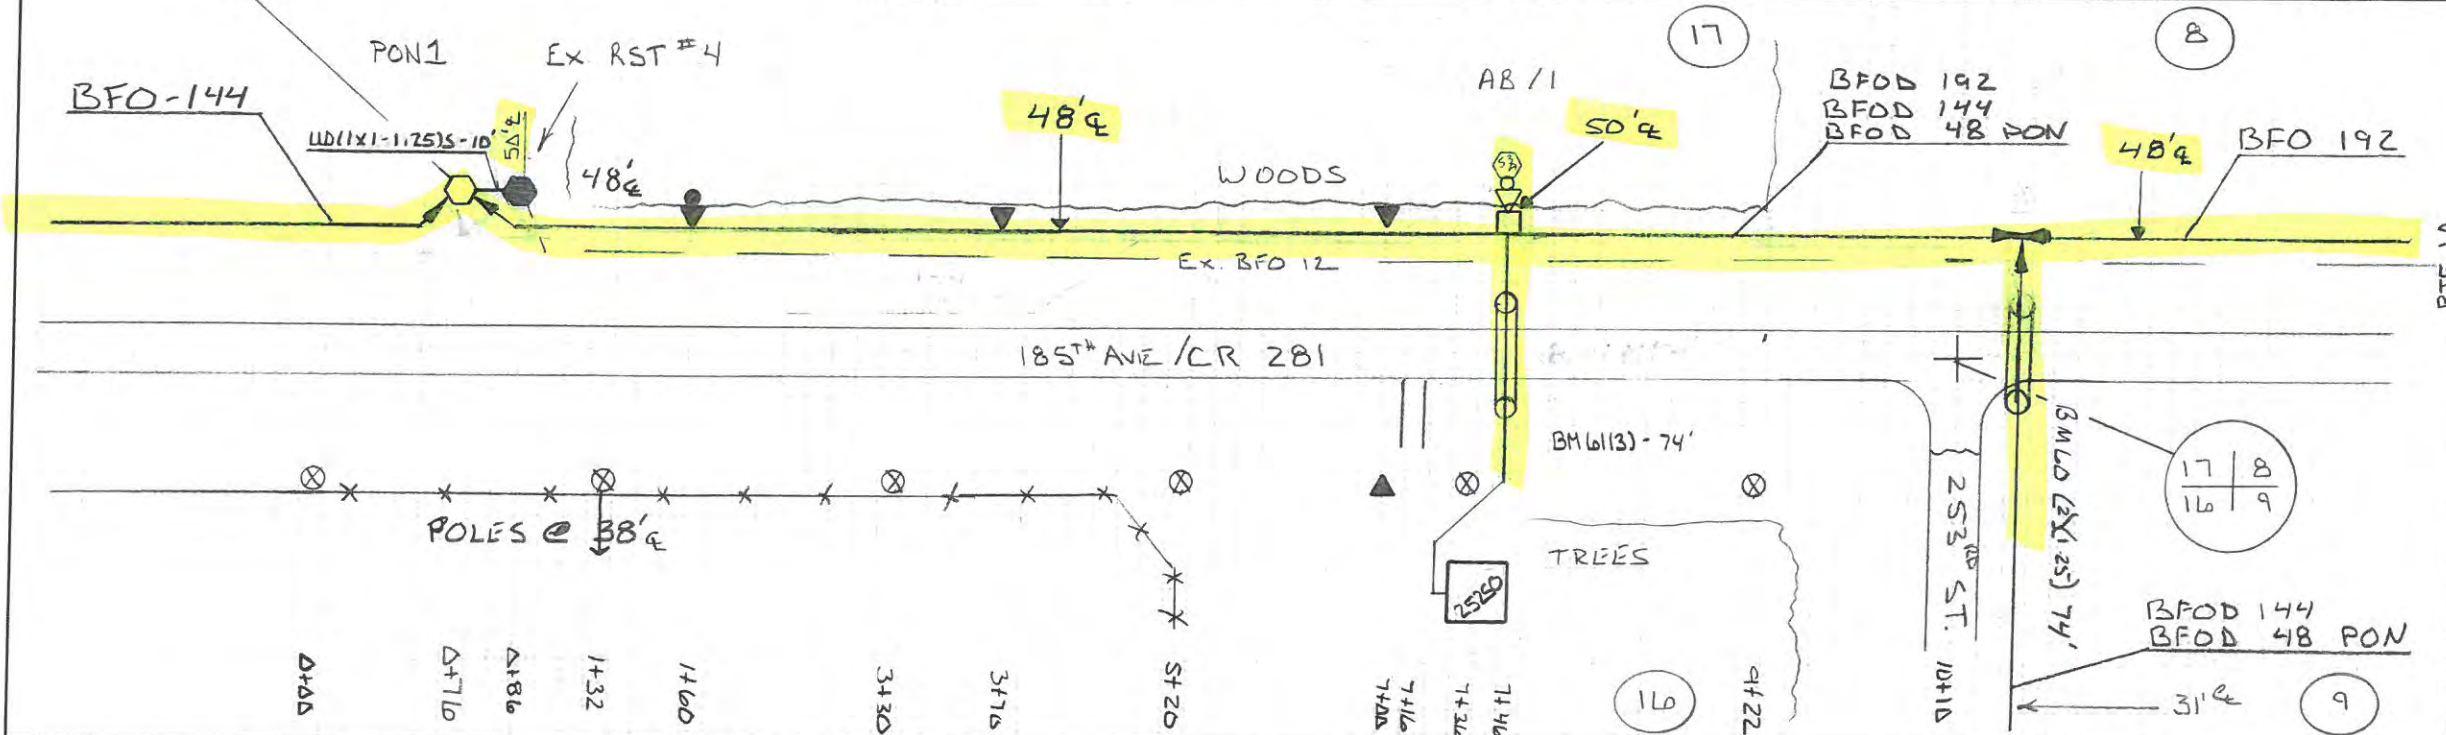

SEE 13 SHT 20F12

HOUSING NO.	BA	BDO	BFO			BHF	BM			HBFD	HO	NID	SUB NO.	SEB	UD	UO
			(48)	(144)	(192)	(30x48x36) T	2 (58)(B)	53 A	61 (3)	144 (M)	1	3		4		
AB	1	1	804	872		1	1	1		1	1					
									74			25250	6668			
	1	1	804	872		1	1	1	74	1	1		6668			



DISTANCE FROM ♀ ROAD

SEE NOTATION



TWP 42 N

RNG 31 W

SEC 16/17

CO. Morrison

ROUTE: 1C

SHEET: 3 OF 14

SERVICE AREA: Freedom

STAKED BY: ERR DATE: 1-16-15


PROJECT: MN 537

REV.

EXCHANGE: Freedom

AS BUILT BY: DATE:

TOWNSHIP: RIDLEY

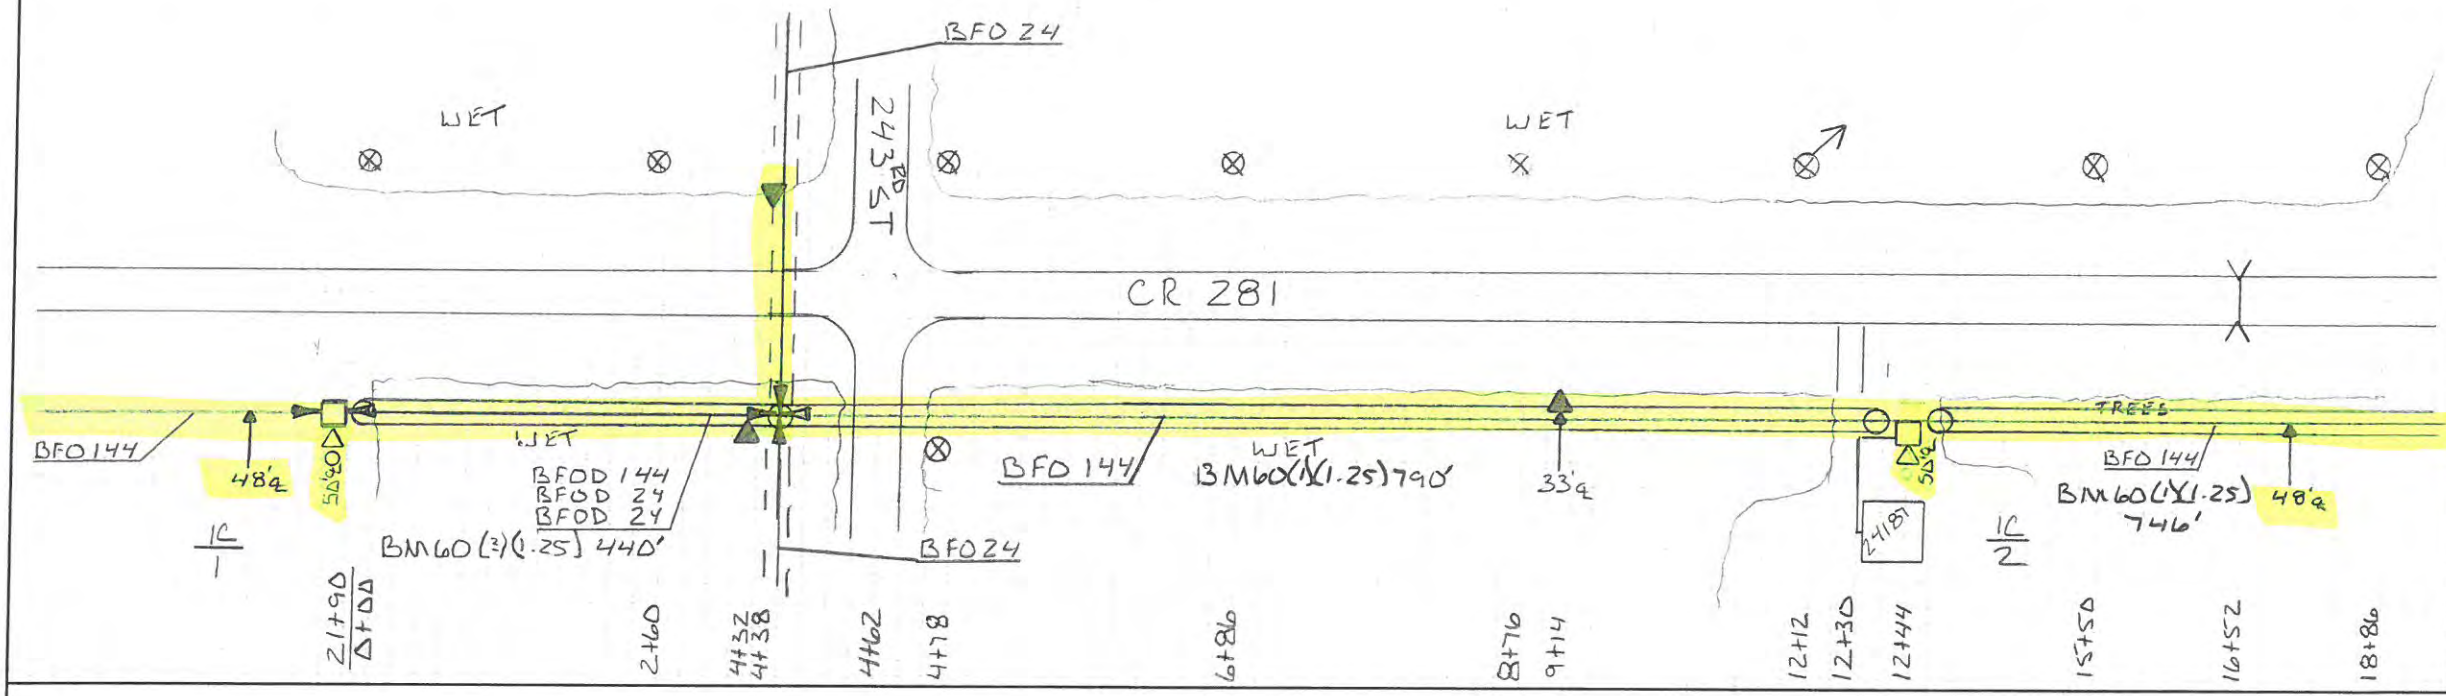

HOUSING NO.	BA	BDO	BFO		BHF	BM		HBF		HO	NID	SUB NO.	SEB	UD	UO
	3	3(BG)	(24 & 24 & 144)	144	130x180	2 (51.25) 53	53A (1.25) (1.25)	440	1	5		4	(1.25)		
1	1	1		3882	1	1	1	720	1	30				10	
2	1	1		564 884	1	1		1 790 440	1	1	1	24187 418		10	
	2	2		564 4766	2	2	1	2 1510 440	2	31	1	418		20	



DISTANCE FROM C ROAD

SEE NOTATION

STAKED BY: ERR

DATE: 1-16-15

REV.

REV.

AS BUILT BY:

DATE:



PROJECT: MN 537

EXCHANGE: Freedom

TOWNSHIP: RIPLEY

TWP 42 N

RNG 31 W


SEC. 16/21

CO. Morrison

ROUTE: 1C

SHEET: 4 OF 14

SERVICE AREA: Freedom

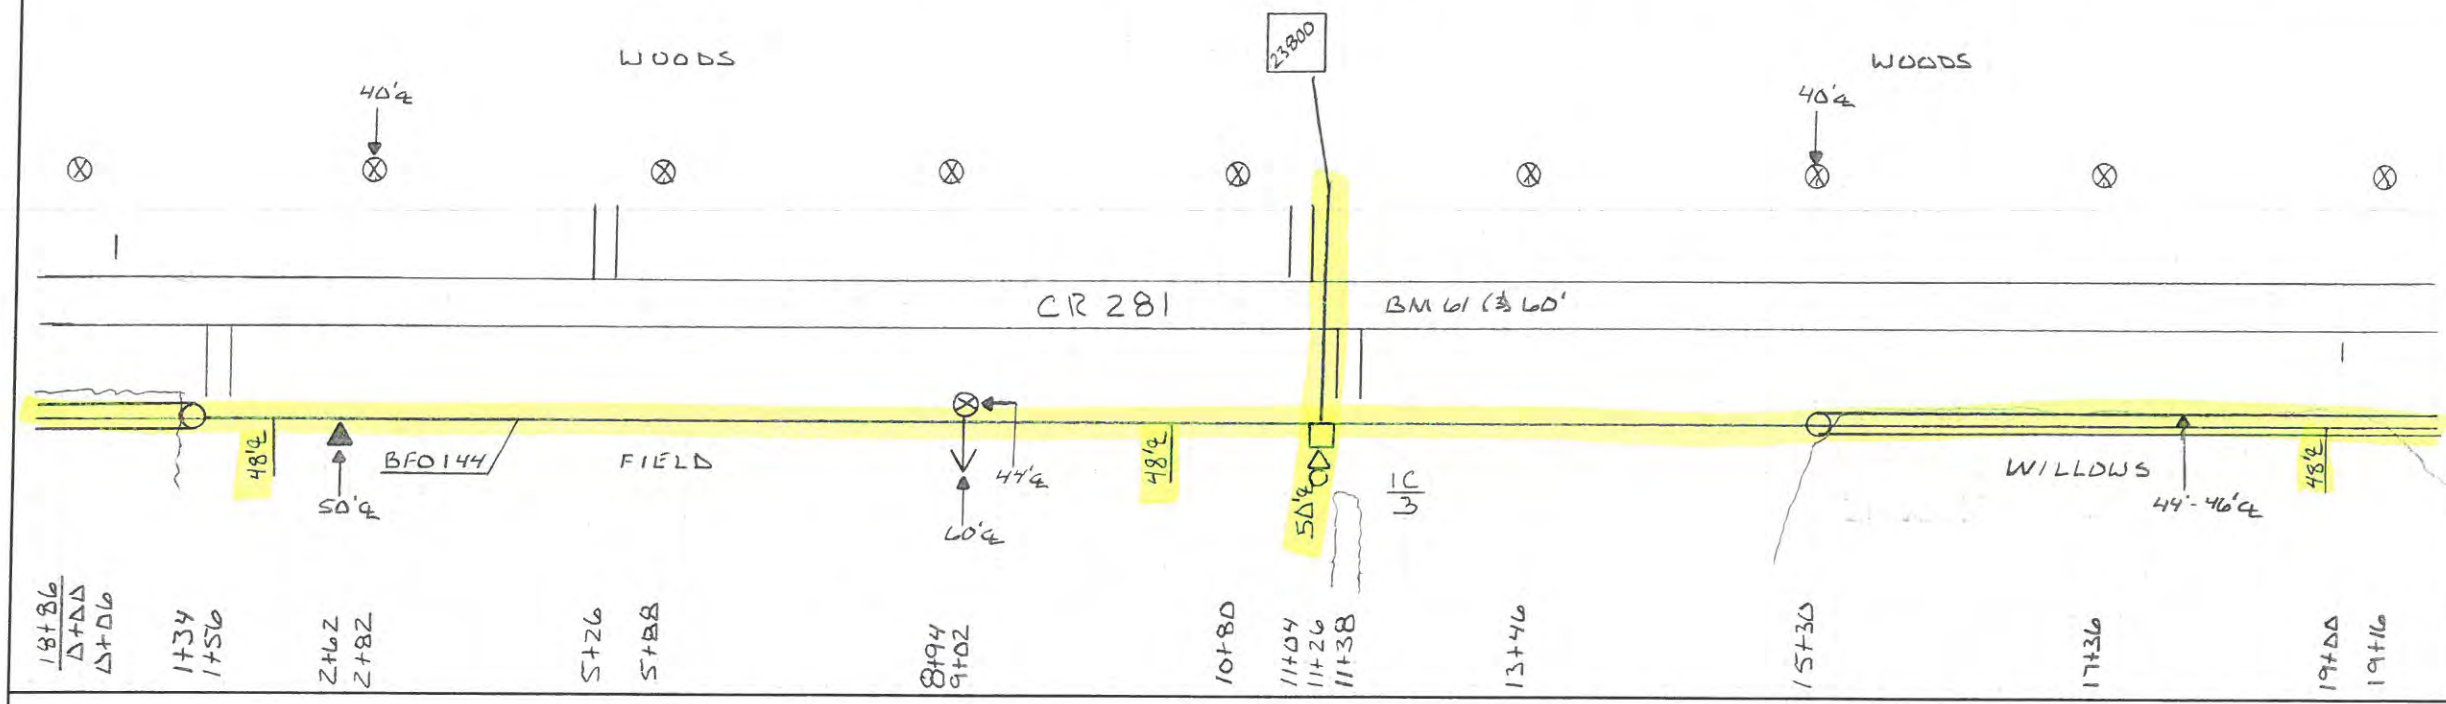


HOUSING NO.	BA	BDO	BFO	BH	BM	HBFO	HO	NID	SUB NO.	SEB	UD	UO
3	3(A6)		144	F	Z 30x48x36 (58'±)	53A 144(A)	1	8		4	(1X1-1.25)S	
3	1	1	1998	1	1	1	1	1	23800	916	10.	
	1	1	1998	1	1	1	1	1		916	10.	



DISTANCE FROM φ ROAD
 SEE NOTATION
 STAKED BY: ERR DATE: 1-16-15
 AS BUILT BY: DATE:



PROJECT: MN 537
 EXCHANGE: Freedhem
 TOWNSHIP: RIPLEY
 TWP: 42 N
 RNG: 31 W
 SEC: 16/21
 CO: Morrison
 ROUTE: 1C
 SHEET: 5 OF 14
 SERVICE AREA: Freedhem

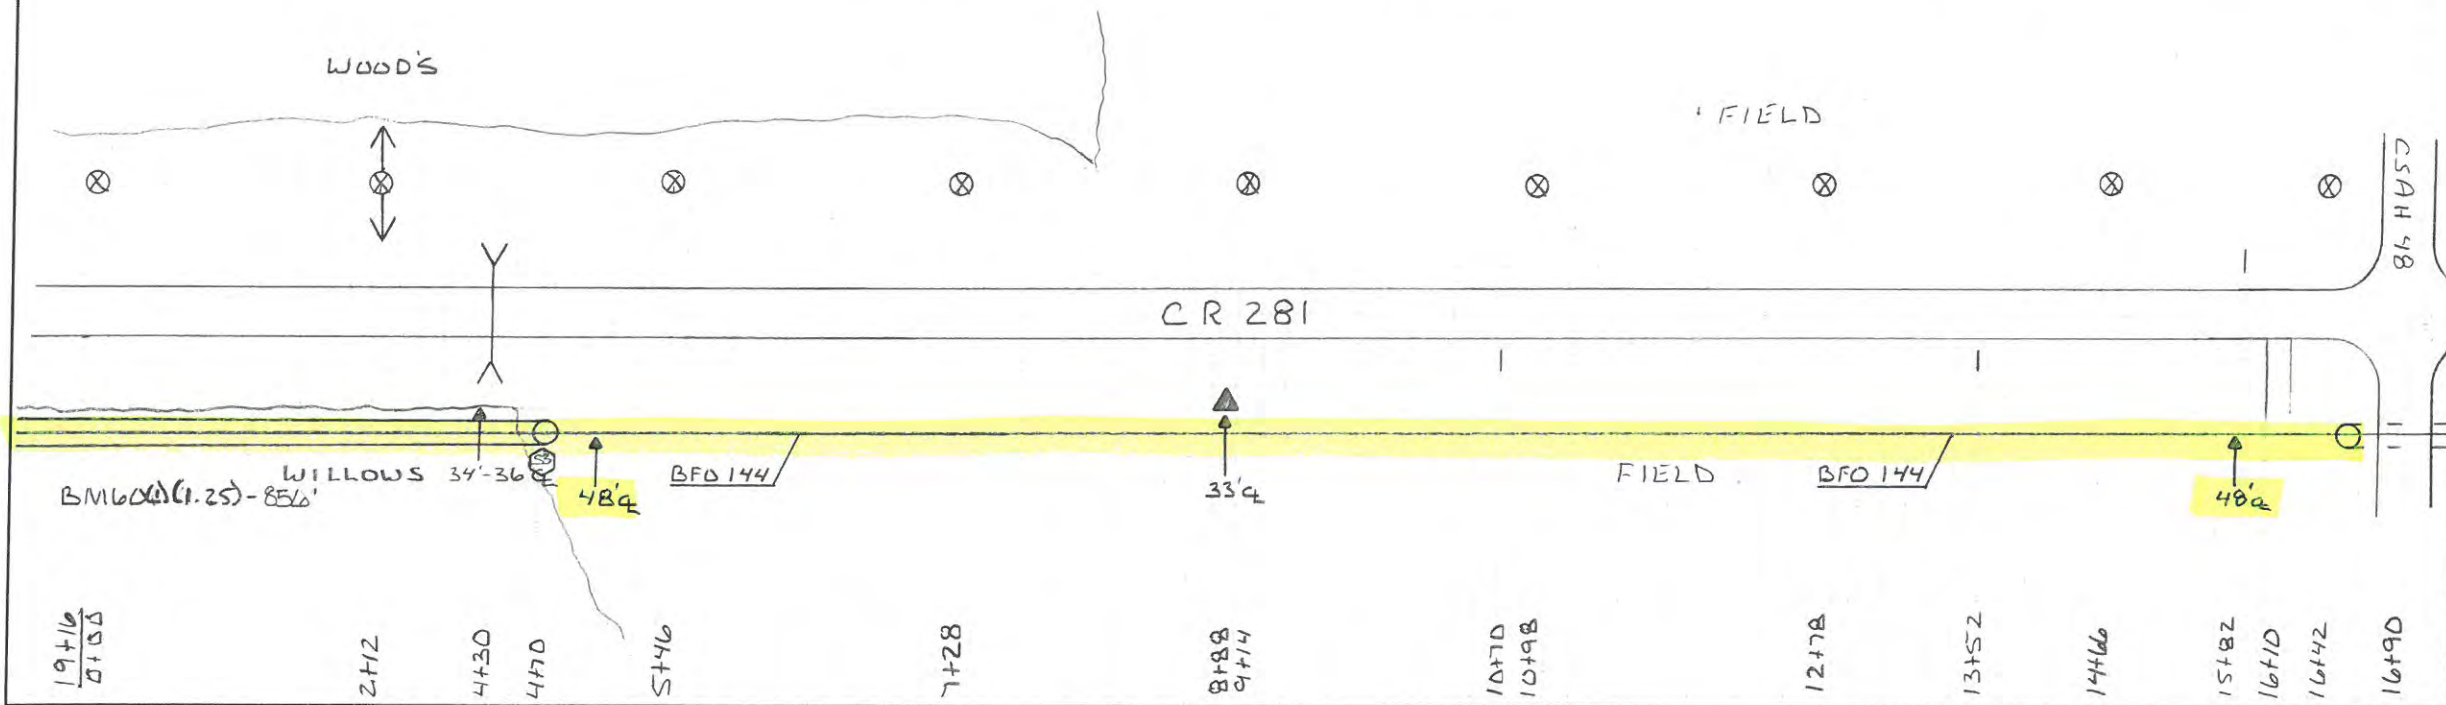

HOUSING NO.	BA		BDO		BFO		BH	BM		HBF	HO	NID	SUB NO.	SE	UD	UO				
								<u>No Units</u>												