



DISTANCE FROM \varnothing ROAD

SEE NOTATION



TWP 42 N

ROUTE: 1C12A

RNG 31 W

STAKED BY: ERR DATE: 2-25-15

PROJECT: MN 537

REV.

EXCHANGE: Freedom

SEC. 24/19


SHEET: 1 OF 3

AS BUILT BY: DATE:

TOWNSHIP: RIPLEY

CO. Morrison


SERVICE AREA: Freedom

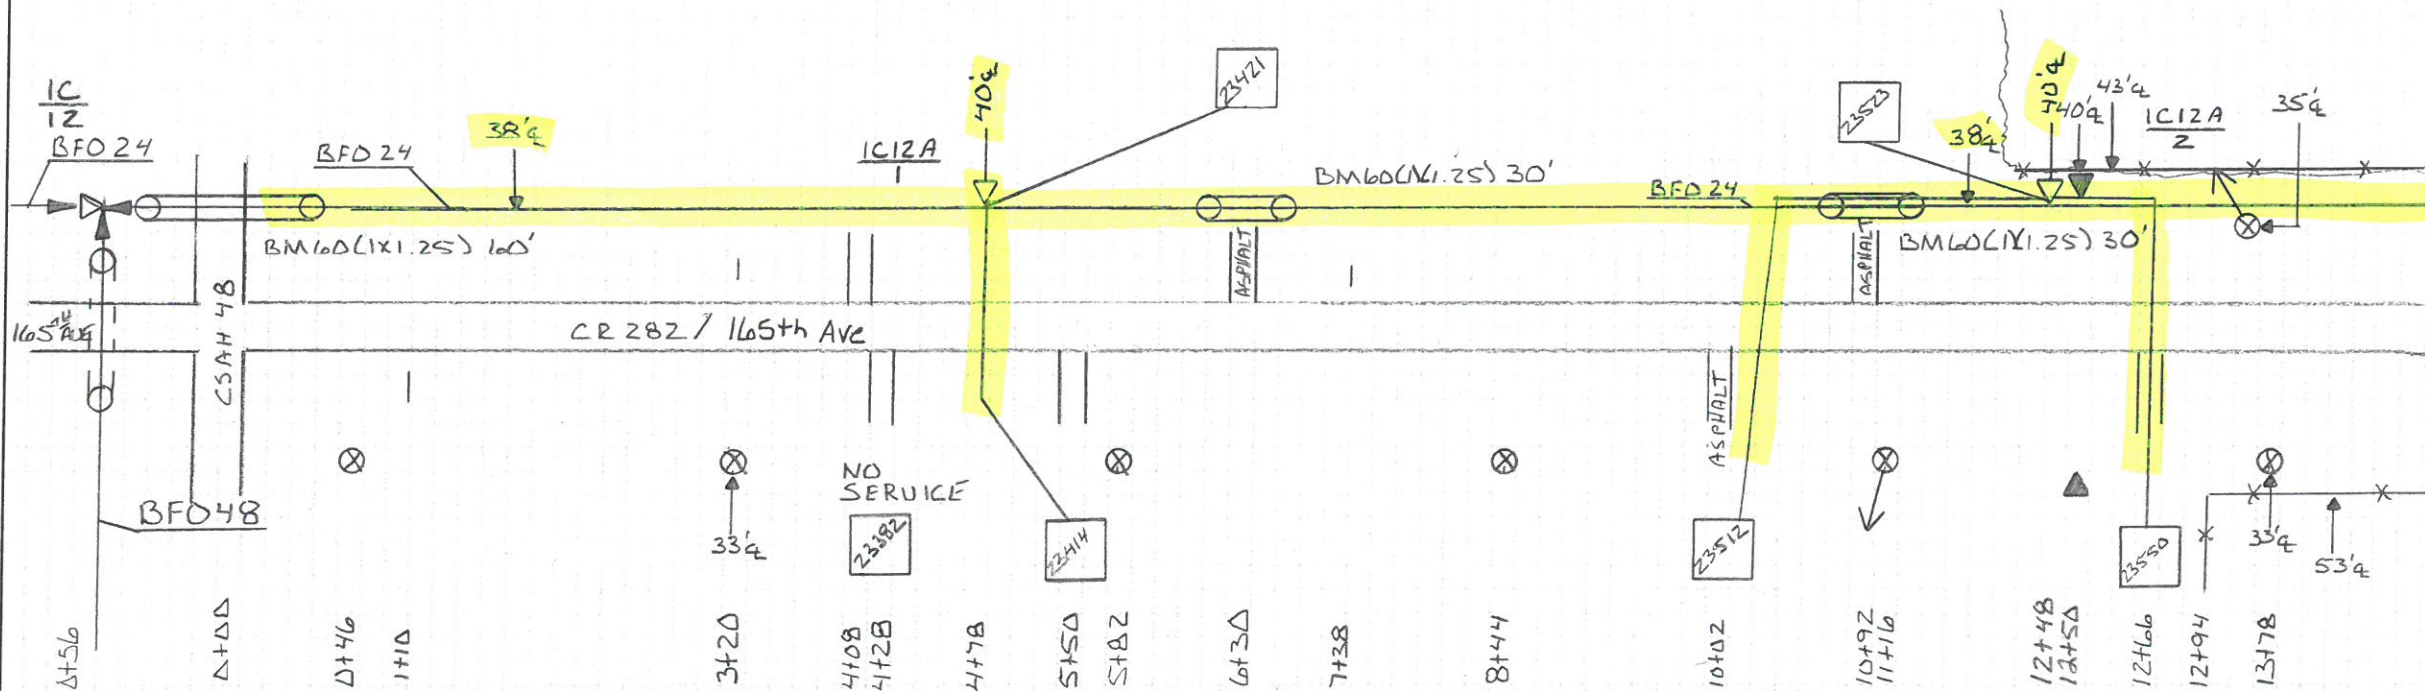

HOUSING NO.	BA		BDO		BFO		BH	BM			HBF		HO	MID	NID	SUB NO.	SE B	UD	UO
	3	4 (AGS)			24			2 (5/8) (8)	53A	60	61 (3)								
1	1	1			620			1	1	60	40		2	1			23414	670	
															1		23421	406	
2	1	1			862			1	1	60	40		3		1		23512	682	
															1		23523	314	
										40					1		23550	526	
	2	2			1482			2	2	120	120		5	1	1	3		2598	



DISTANCE FROM \bar{C} ROAD		SEE NOTATION				TWP	42	N	ROUTE: IC12A	
STAKED BY: ERR						DATE:	PROJECT:	MN 537		
REV.	REV.	EXCHANGE:	Freedhem		SEC.	24/19		SHEET: 2 OF 3		
AS BUILT BY:	DATE:	TOWNSHIP:	RIPLEY		CO.	Morrison		SERVICE AREA: Freedhem		

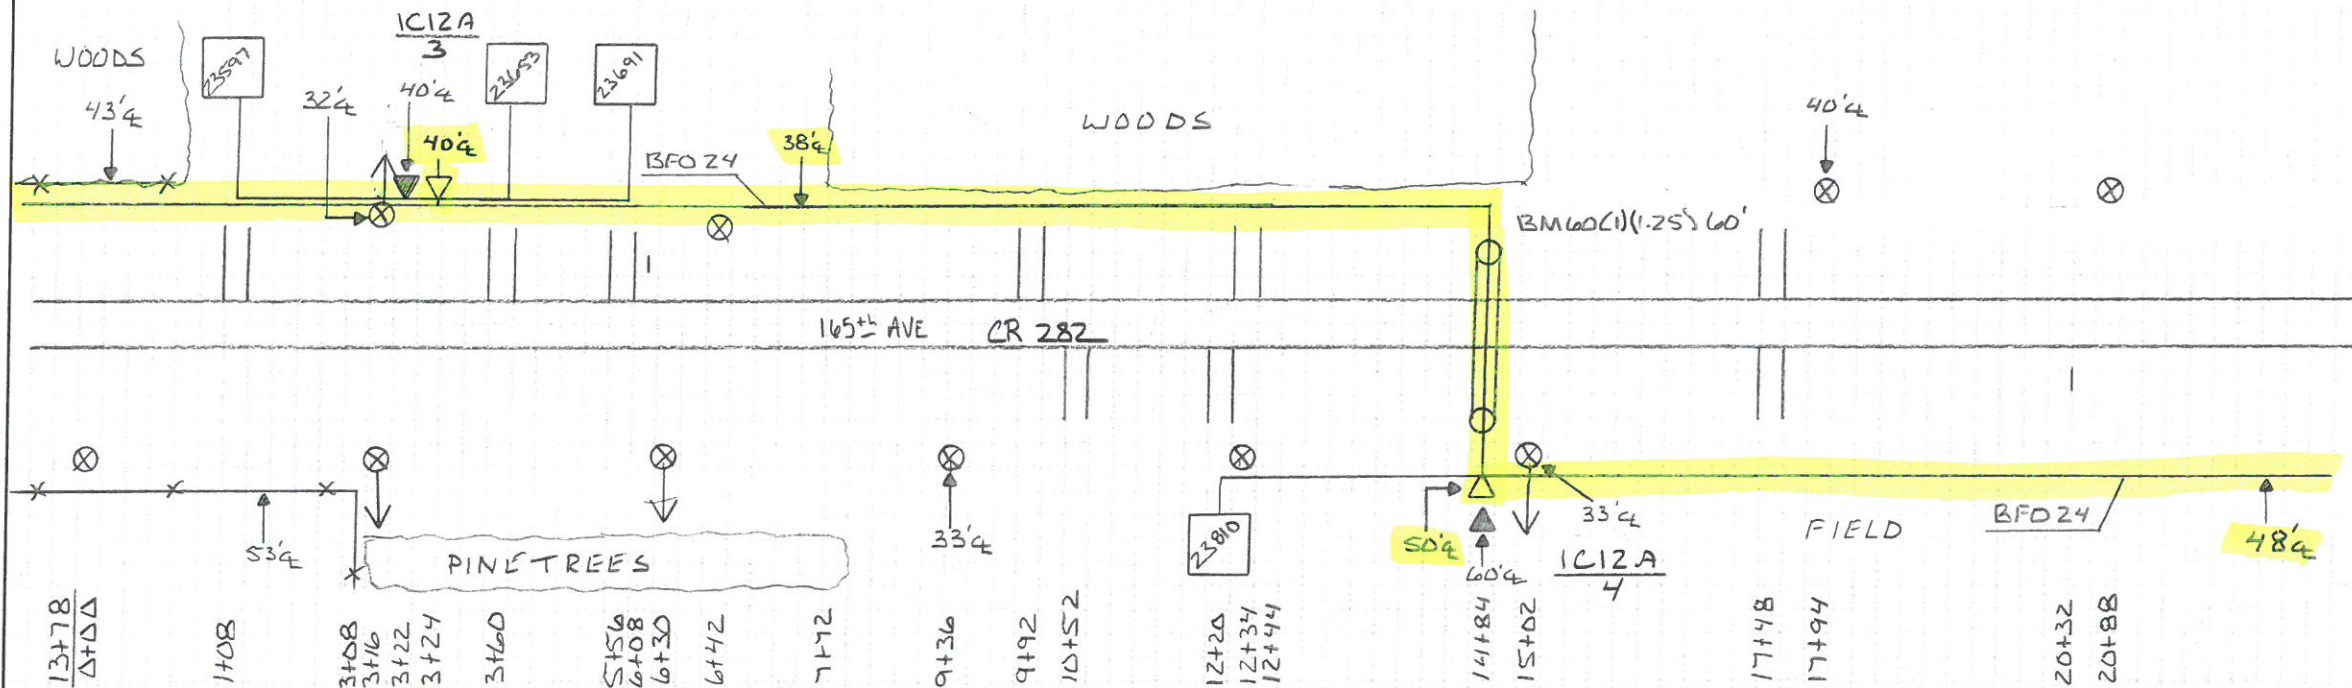


HOUSING NO.	BA	BDO	BFO	BH	BM	HBF	HO	NID	SUB NO.	SE B	UD	UO
	3	4 (AGS)	24		2 (S/A) (B)	S3A	60 (1.25)	-1	5	4		
3	1	1	5360		1	1		3	1	23597	440	
									1	23653	700	
									1	23691	604	
4	1	1	13660		1	1	60	1	1	23810	286	
	2	2	1962		2	2	60	4	4	2030		



DISTANCE FROM C ROAD		SEE NOTATION				TWP	42 N	ROUTE: IC12A	
STAKED BY: ERR						DATE: 2-26-15	PROJECT:		
REV.		REV.		EXCHANGE:		SEC: 24/19		SHEET: 3 OF 3	
AS BUILT BY:		DATE:		TOWNSHIP: RIPLEY		CO: Morrison		SERVICE AREA: Freedhem	

PINE TREES @ 80'

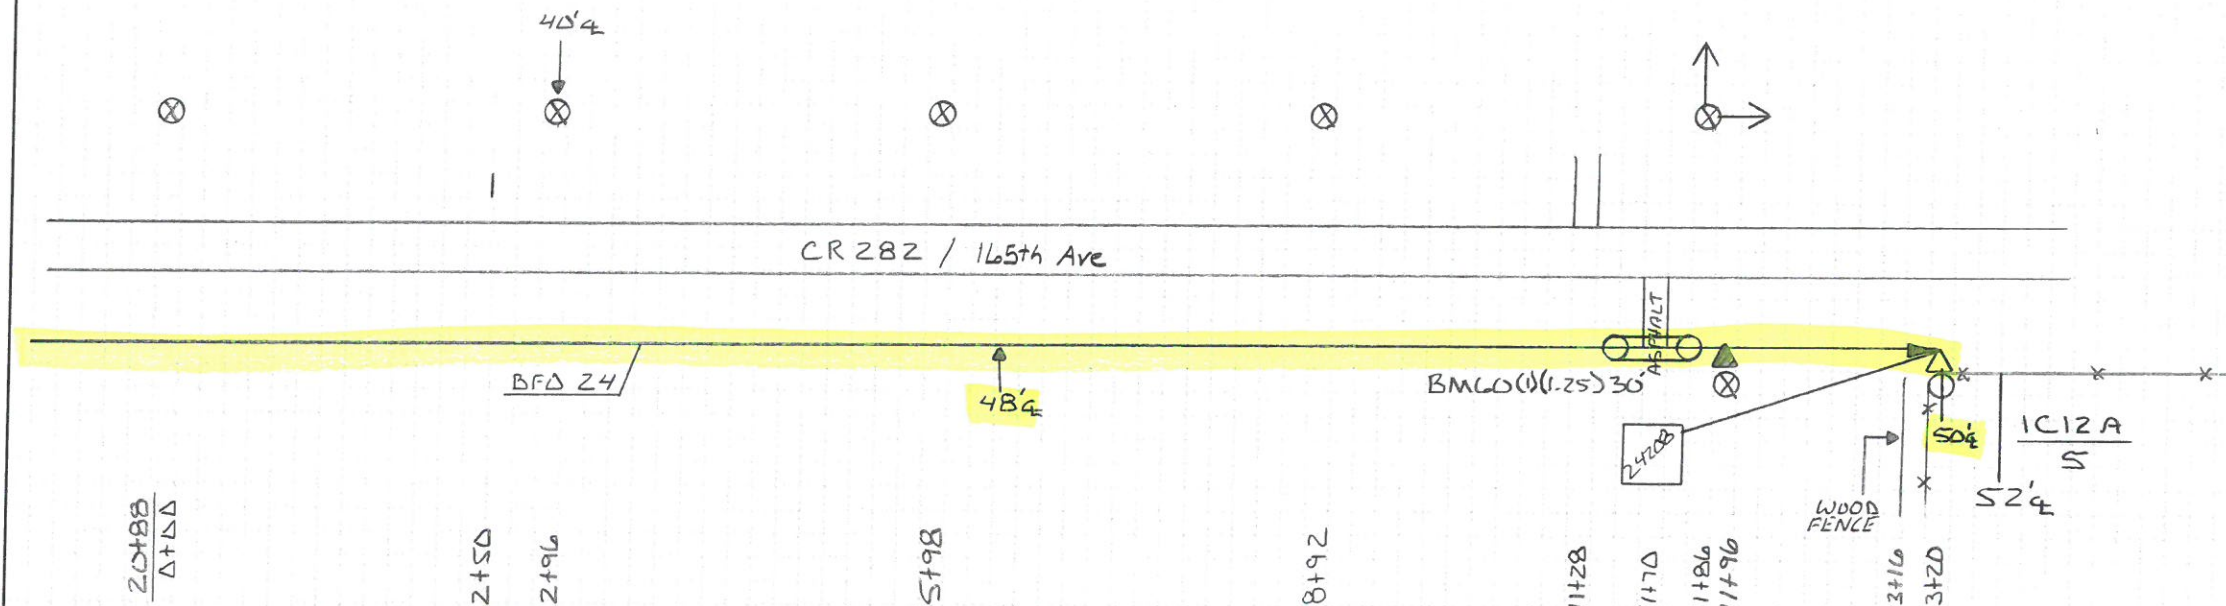

HOUSING NO.	BA	BDO	BFO			BH	BM			HBF	HO	NID	SUB NO.	SEB	UD	UO
3		4 (AGS)		24			2 (5/8) (3)	53A	60 (1.25)		-1	5		4		
5	1	1		2052			1		30		1	2420B	120			
	1	1		2052			1	1	30		1		120			