


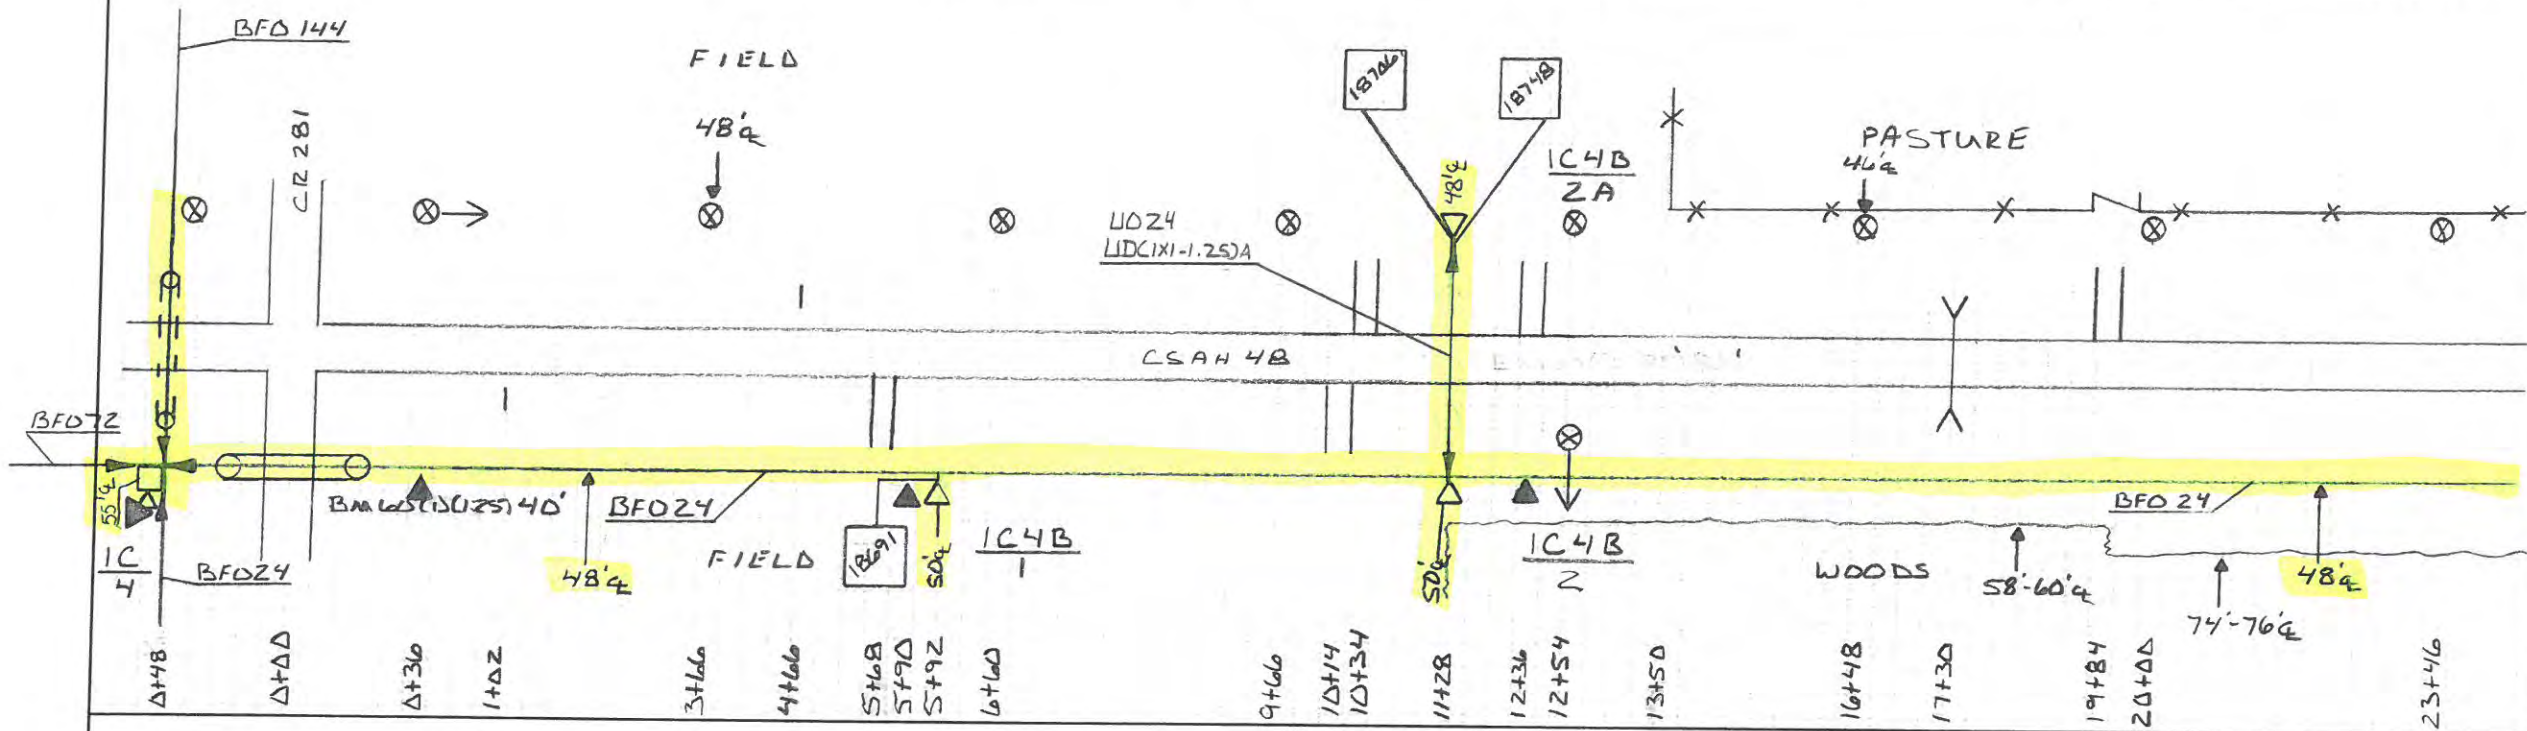

DISTANCE FROM ♀ ROAD
 SEE NOTATION
 STAKED BY: *ERR* DATE: *2-27-15*
 REV. _____ REV. _____
 AS BUILT BY: _____ DATE: _____




PROJECT: MN 537
 EXCHANGE: *Freedhem*
 TOWNSHIP: *RIPLEY*
 TWP: *42 N*
 RNG: *31 W*
 SEC: *28*
 CO: *Morrison*
 ROUTE: *1C4B*
 SHEET: *1* OF *4*
 SERVICE AREA: *Freedhem*



HOUSING NO.	BA		BDO		BFO			BH	BM				HBF		HO	NID		SUB NO.	SEB	UD	UO
	1	2	1	2	1	2	3	1	2	3	4	5	6	7	8	9	10	11	12	13	
	3		4 (GS)	4 (AGS)		24		2 (SAB)	S3A	60 (1.25)	61 (3)	73			-1	5	7		4	(1X1-1.25) A	24
1	1			1		792		1	1	40	14	1			1			18691	696		
2	1			1		620		1	1						3						
2A			1					1							2		1	18706	352	116	116
																	1	18748	230		
	2	1	2			1412		3	2	40	14	1			6	2	1		1278	116	116



DISTANCE FROM C ROAD		SEE NOTATION		CTC		TWP 42 N		ROUTE: 1C4B	
STAKED BY: ERR						DATE: 3-2-15			
REV.		REV.		EXCHANGE: Freedhem		RNG 31 W		SHEET: 2 OF 4	
AS BUILT BY:		DATE:		TOWNSHIP: RIPLEY		SEC. 28		CO. Morrison	
								SERVICE AREA: Freedhem	

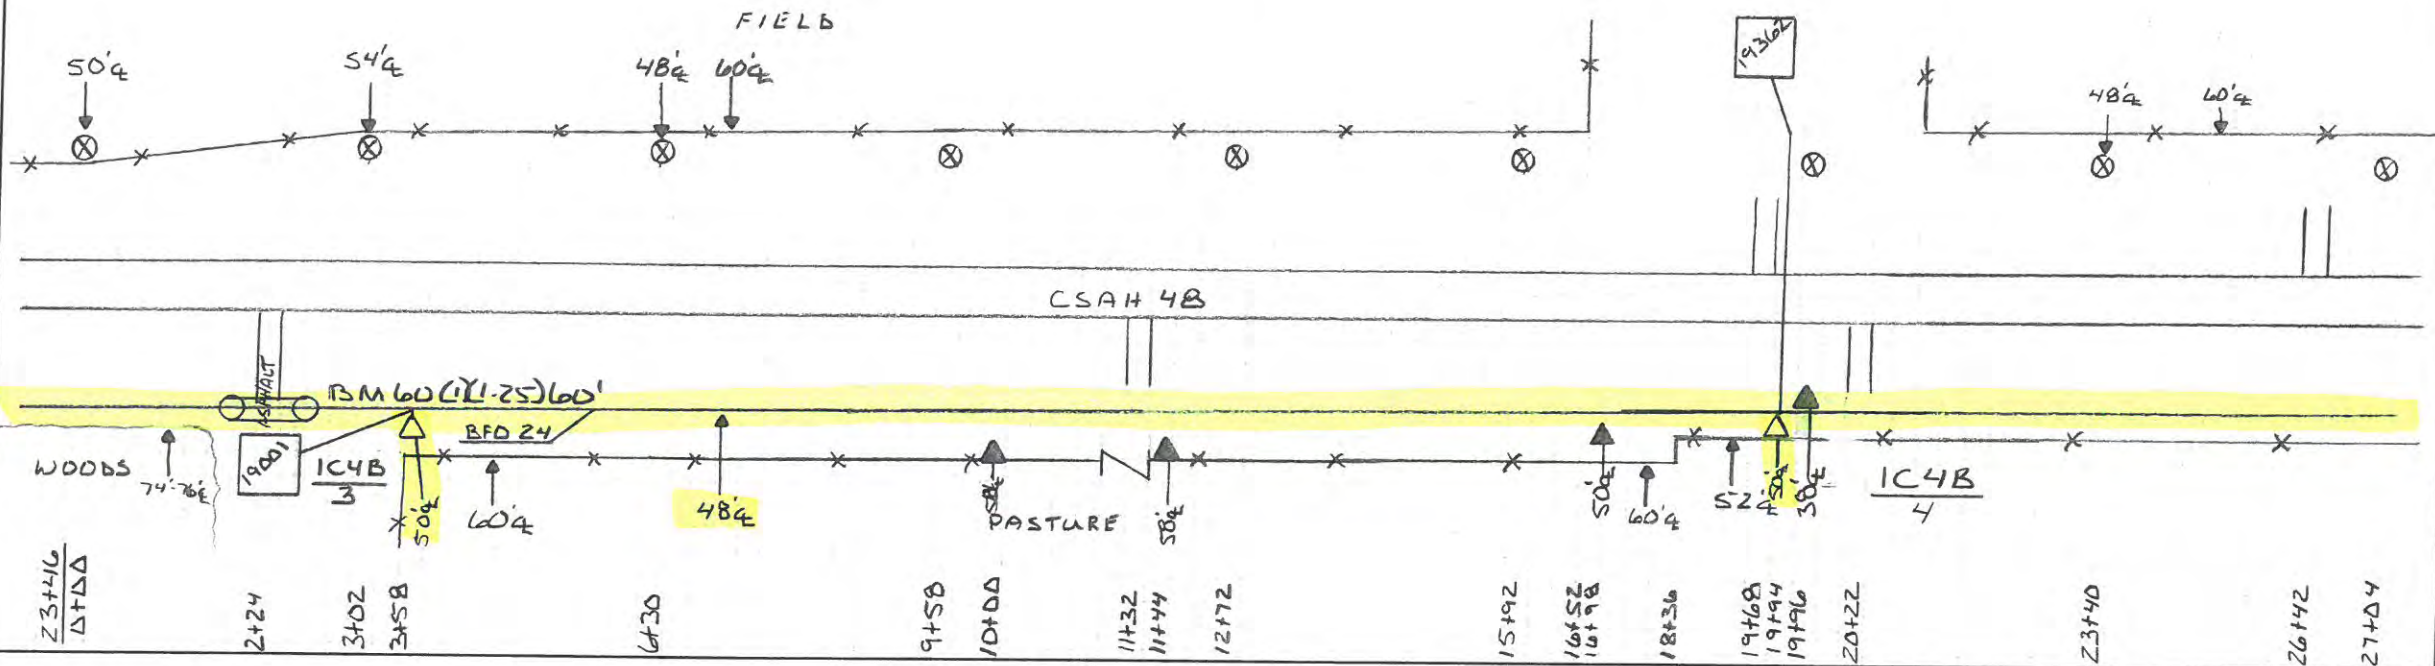


HOUSING NO.	BA		BDO		BFO		BH	BM			HBF		HO	NID		SUB NO.	SE B	UD	UO
	3	4	(1765)		24			2	S3A	60	60	(3)	-1	3	5		4		
3	1	1			1692			1	1	60			1	1		19001	212		
4	1	1			1754			1	1	60			1	1		19362	290		
2	2				3446			2	2	60	60		2	1	1		502		



DISTANCE FROM C ROAD		SEE NOTATION				TWP	42 N	ROUTE: 1C4B	
AS BUILT BY:						DATE:	PROJECT:		
STAKED BY: ERR		DATE: 3-2-15		PROJECT: MN 537		SEC.	22 27	SHEET: 3 OF 4	
REV.		REV.		EXCHANGE: Freedhem		CO.	Morrison	SERVICE AREA: Freedhem	
TOWNSHIP: RIPLEY									

DNR WATER CROSSING

19918 NO SERVICE

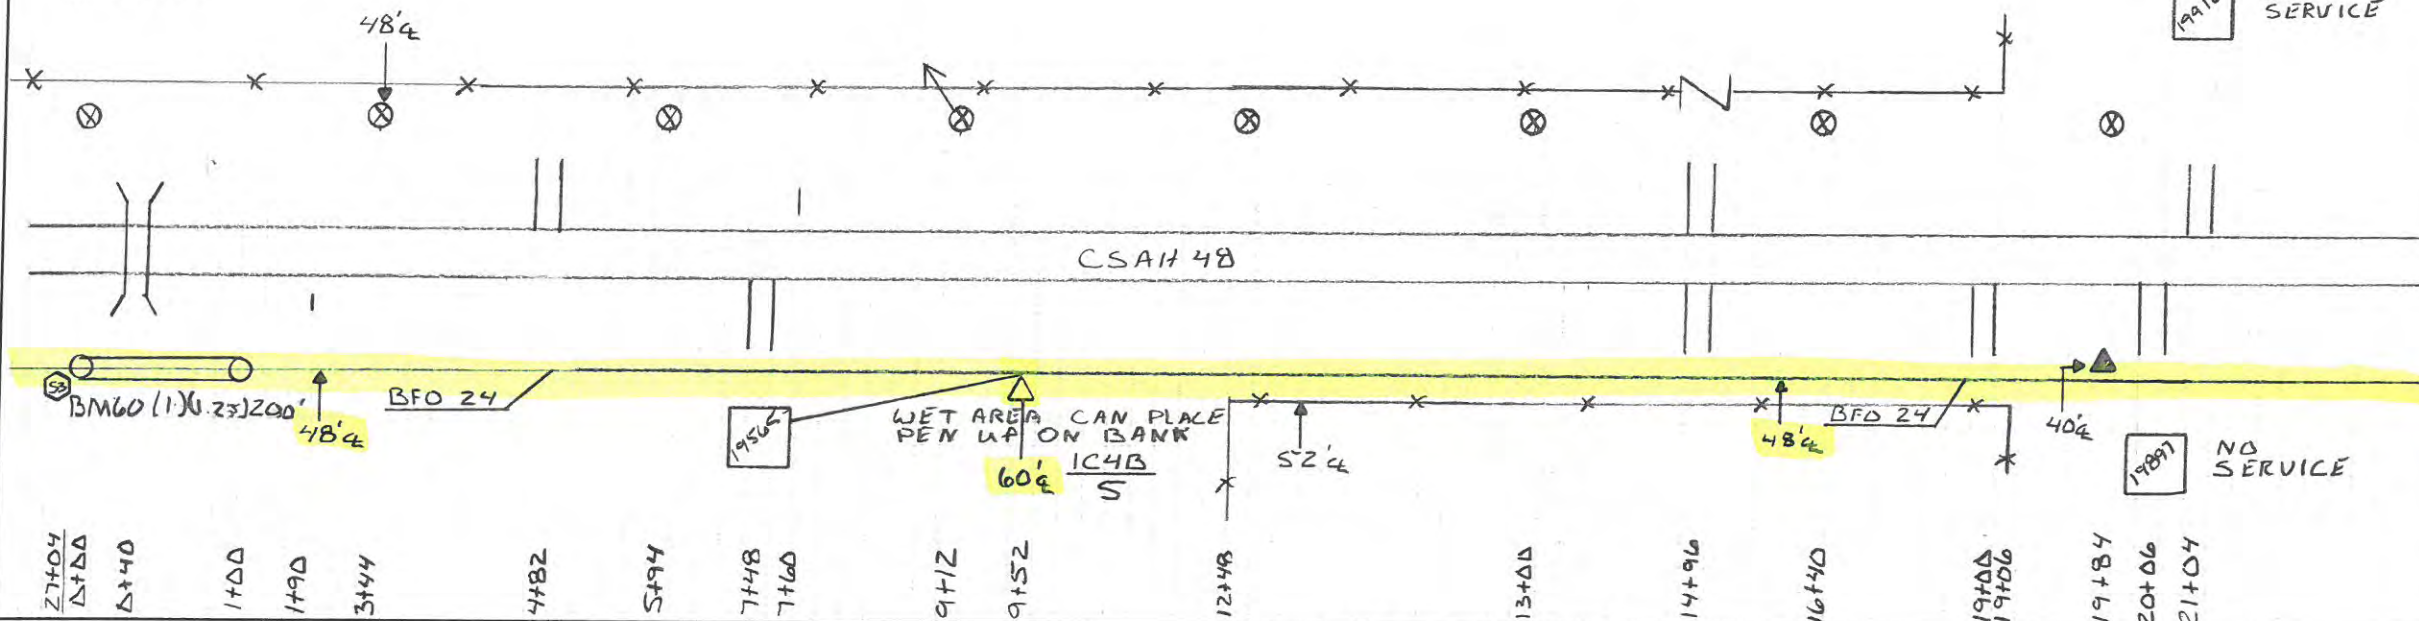

19897 NO SERVICE

- 27+04
- Δ+ΔΔ
- Δ+40
- 1+ΔΔ
- 1+9Δ
- 3+44
- 4+82
- 5+94
- 7+48
- 7+60
- 9+12
- 9+52
- 12+48
- 13+ΔΔ
- 14+96
- 16+40
- 19+ΔΔ
- 19+06
- 19+84
- 20+06
- 21+04


HOUSING NO.	BA		BDO		BFO		BH	BM				HBF		HO	NID	SUB NO.	SEB	UD	UO
	3	4 (AGS)			24			2	53	S3A	60 (1125)			-1	5		4		
5	1	1			1780			1	1	1	200			1	1	19565	220		
	1	1			1780			1	1	1	200			1	1		220		



DISTANCE FROM ϕ ROAD
 SEE NOTATION
 STAKED BY: *ERR* DATE: *3-2-15*
 REV. _____ REV. _____
 AS BUILT BY: _____ DATE: _____



PROJECT: **MN 537**
 EXCHANGE: **Freedhem**
 TOWNSHIP: **RIPLEY**
 TWP: **42 N**
 RNG: **31 W**
 SEC: **$\frac{22}{27}$**
 CO: **Morrison**
 ROUTE: **1C4B**
 SHEET: **4** OF **4**
 SERVICE AREA: **Freedhem**

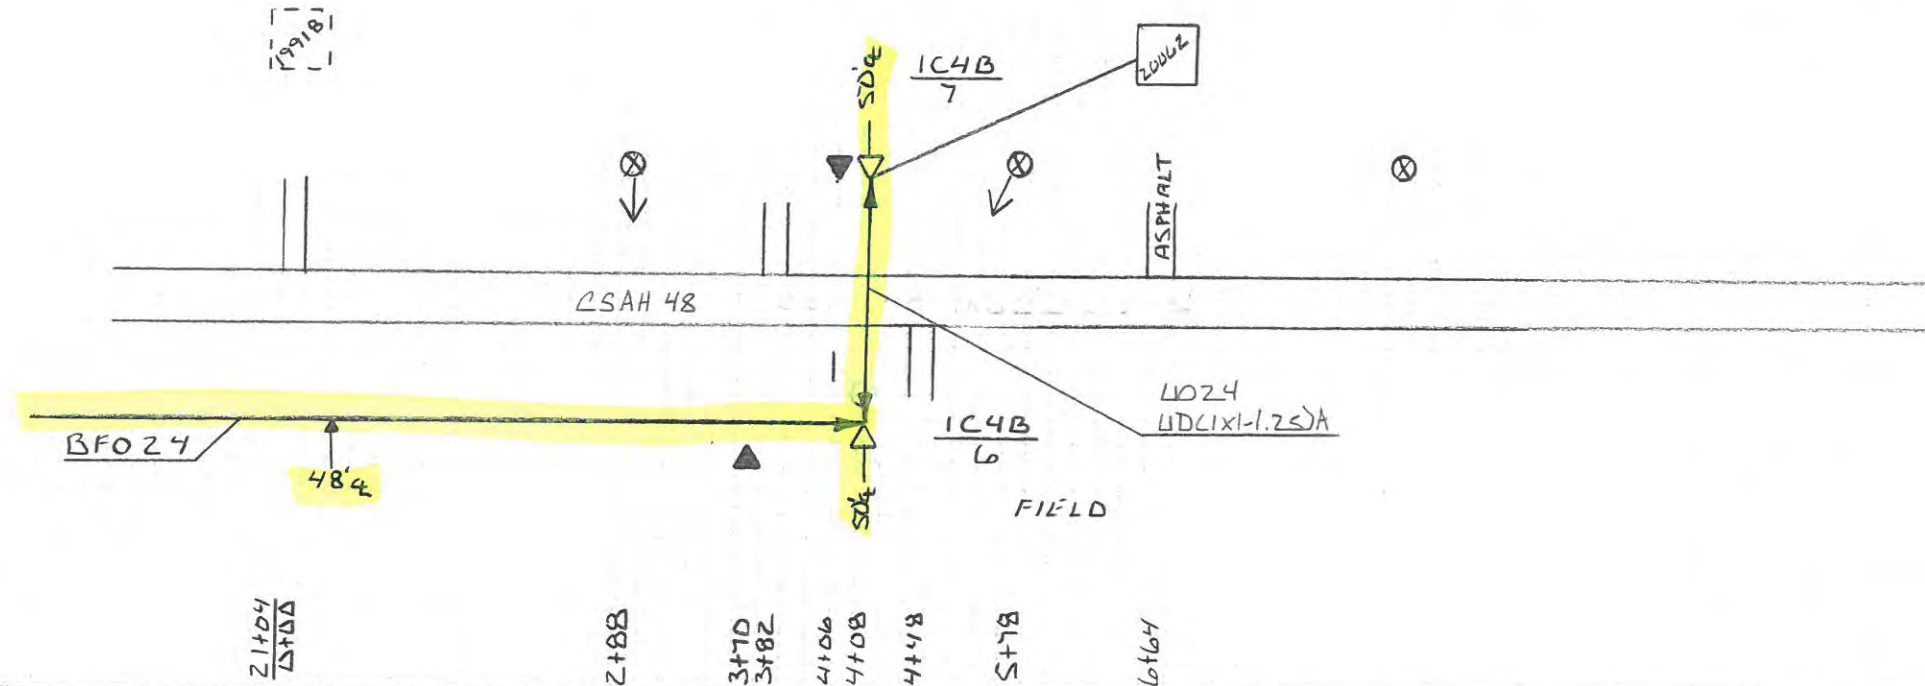

$\frac{21+04}{\Delta+5\Delta}$

2+88

3+70
3+82

4+06
4+08

4+44

5+78

6+64

HOUSING NO.	BA	BDO	BFO		BH	BM		HBF	HO	NID	SUB NO.	SEB	UD	UO
	3		4 (AGS)	24			2 (3/8)	S3A		-1	5		4	(1X1-1.25) A
6	1	1	1674			1	1							
7	1	1				1	1		1	1	20062	286	118	168
2	2	2	1674			2	2		1	1		286	118	168