


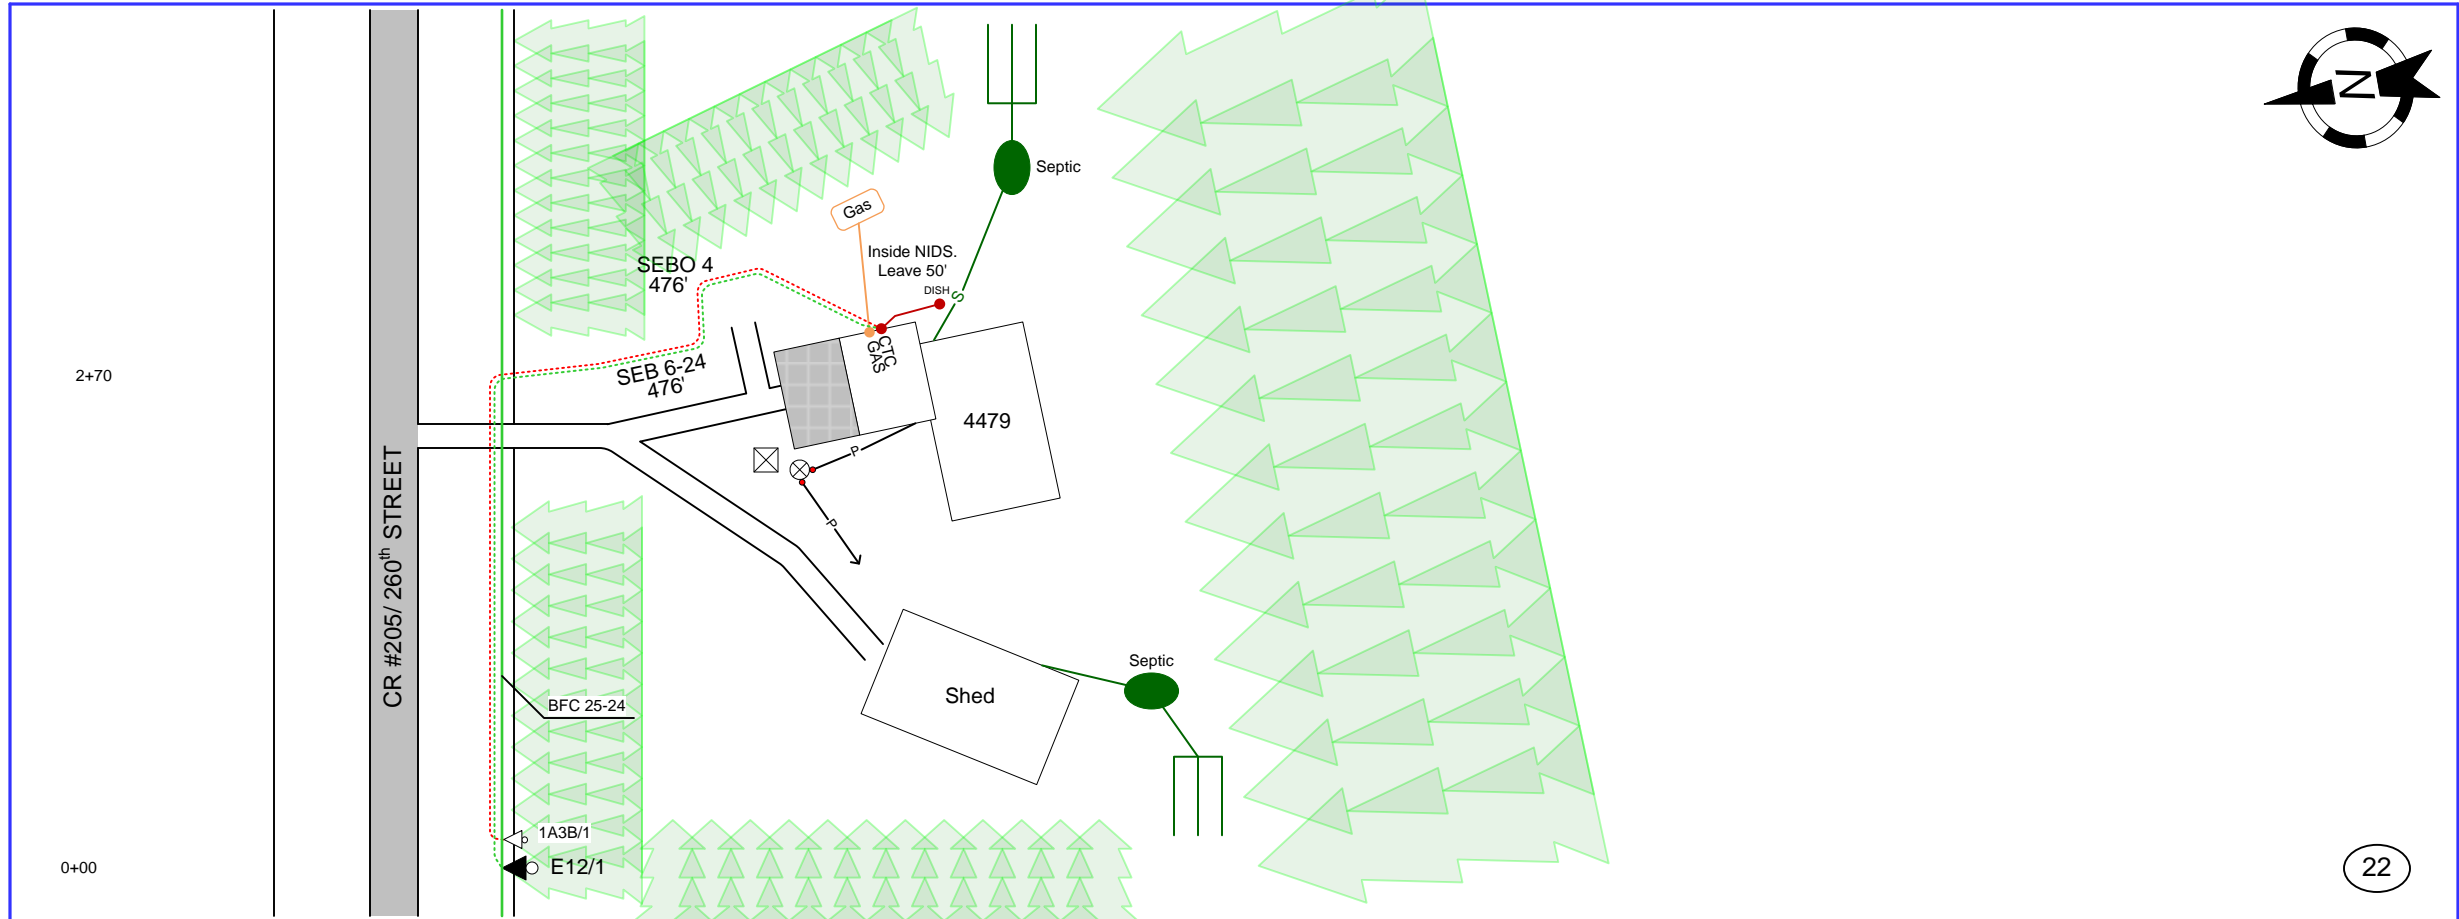

22



From	To	PType	Units	Feet	HC	NID	W	Remarks
4479	4479		SEBO 4	476		(3)		Power Ground Inside
E12/1	4479		SEB 6-24	476		F(l)		Inside Fiber NID
	E12/1				1	1	BD 3A 1	Splice for Address 4479 Re-enter Ped for Address 4479

As Staked
Consolidated Telephone Company
 Name: 2015 4479 260TH Street
 WO: 2015 CTC
 Exch: Randall
 Route: E12
 ROW: House Drop
 State: Minnesota
 County: Morrison
 Range: 31W
 Twsp: 131N Section: 22
 Township: CUSHING
 Staked By: EMD Date: 5-6-15
 Revised By: _____ Date: _____
 Revised By: _____ Date: _____
 Revised By: _____ Date: _____
 As-Built By: _____ Date: _____