



Category: ☒ Resi Primary Heat  
☐ Resi Non-Primary  
☐ Ag Interruptible

☐ Small Commercial  
☐ Medium Commercial  
☐ Large Commercial

☐ Industrial  
☐ Other  
☐ Rental Prop

#### Service Address Information

Name(s): Randy & Barbara Vanseth  
Address: 13031 30th Ave  
City, St, Zip: Sussexville, MN 56382  
Phone: 612-846-0696  
Email: \_\_\_\_\_  
County: Morrison  
Twn/Sect: Caldwells Twp  
Sch Dist: 486  
Subdivision: \_\_\_\_\_

#### Alternate Mailing Address:

Name(s): \_\_\_\_\_  
Address: 904 Windsor Dr  
City, St, Zip: Lititz, Canada, MN 55109-1033  
Phone: \_\_\_\_\_  
Phone: \_\_\_\_\_  
Email: \_\_\_\_\_

ANTICIPATED READY DATE: \_\_\_\_\_


MAXIMUM HOURLY LOAD (BTUS): \_\_\_\_\_

#### Property Sketch:

- ☐ All Buildings on Property  
☐ St w/ Main + Nearest Intersecting  
☐ Location of Meter  
☐ Drain Tiles  
☐ Private Utility Lines

- ☒ Septic System or Sewer Line  
☐ Does Not Interfere  
☐ Will Cross (verify depth & label on sketch)

☒ Water Well

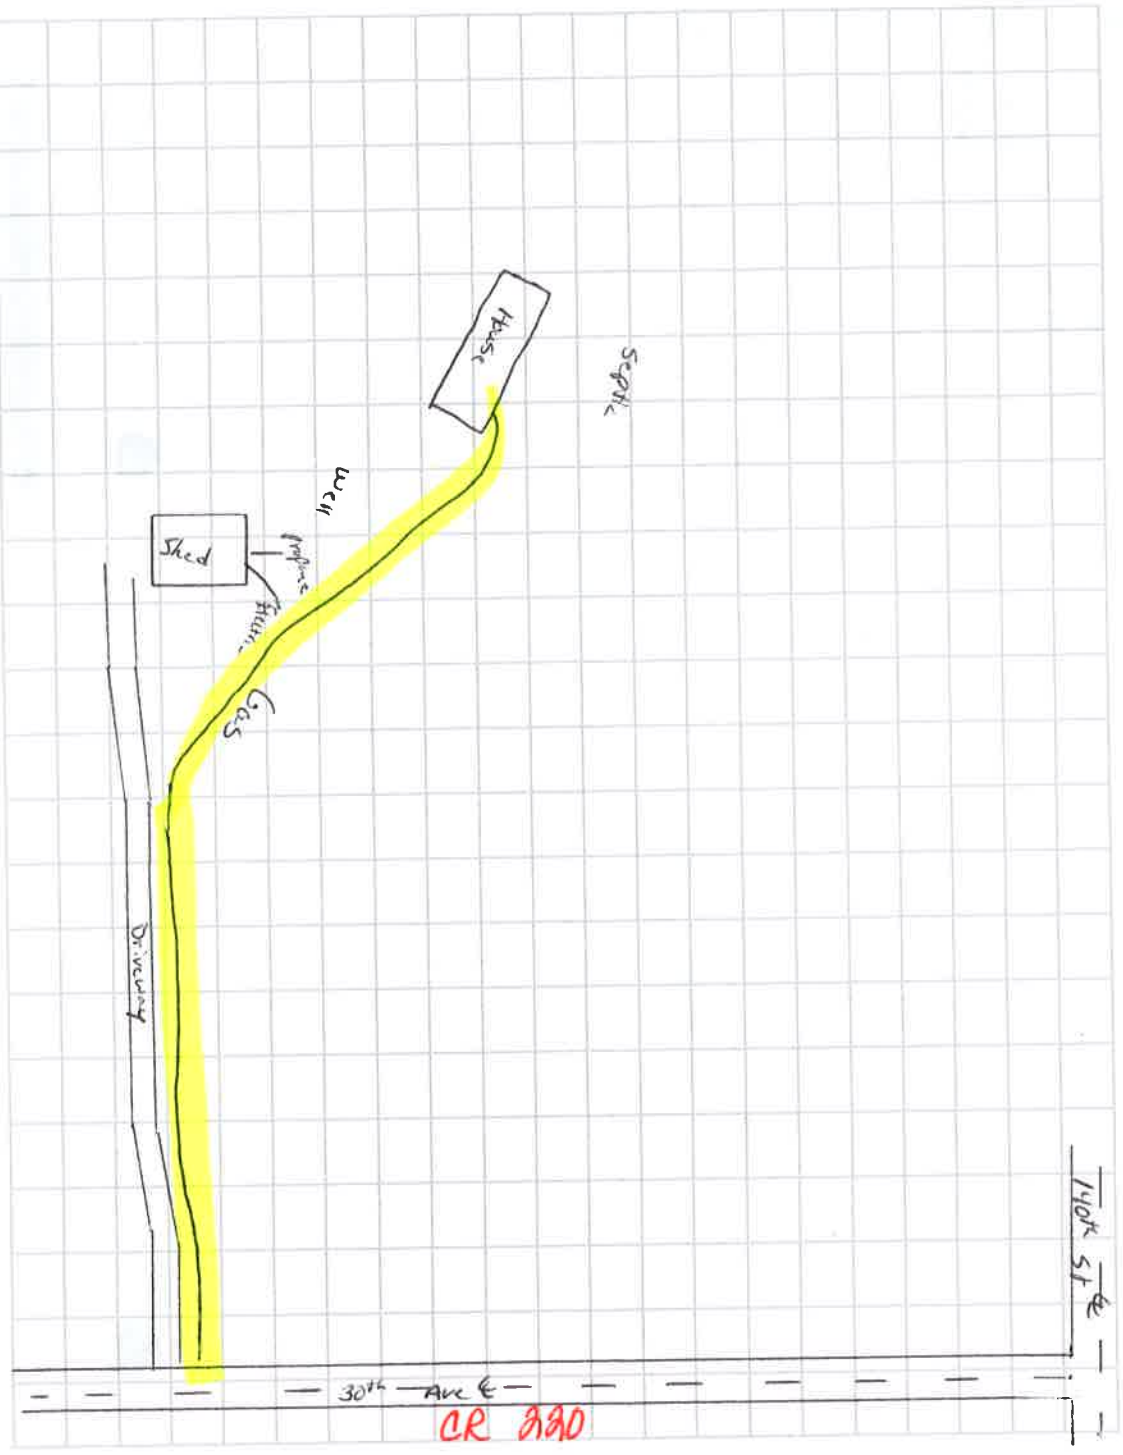

By my signature, I certify that I have provided the location of all items that are applicable as listed above on the property sketch. I have reviewed and agree with the placement of all service lines and rise/meter. I understand that construction will be performed in accordance with safety standards. I have had a chance to read, review and ask questions regarding the terms and conditions of this service as listed on the back of this form.

Customer Printed Name:

RANDY VANSETH

Customer Signature:

Randy Vanseth

Date:

24 April 2015

ACT	WO	CLASS	LOC	ID