

W/O # 2015 10 650

33289

CO ROAD 33

61203

33290

33290

33292 33297

SLACK-SPAN
TO NEW
POLE & ANCHOR

REMOVE ANCHOR
IN CLEAR ZONE

3928-31-0005 33291

ADDRESS 4399


33293

157065


3928-31-0010

33293

33294

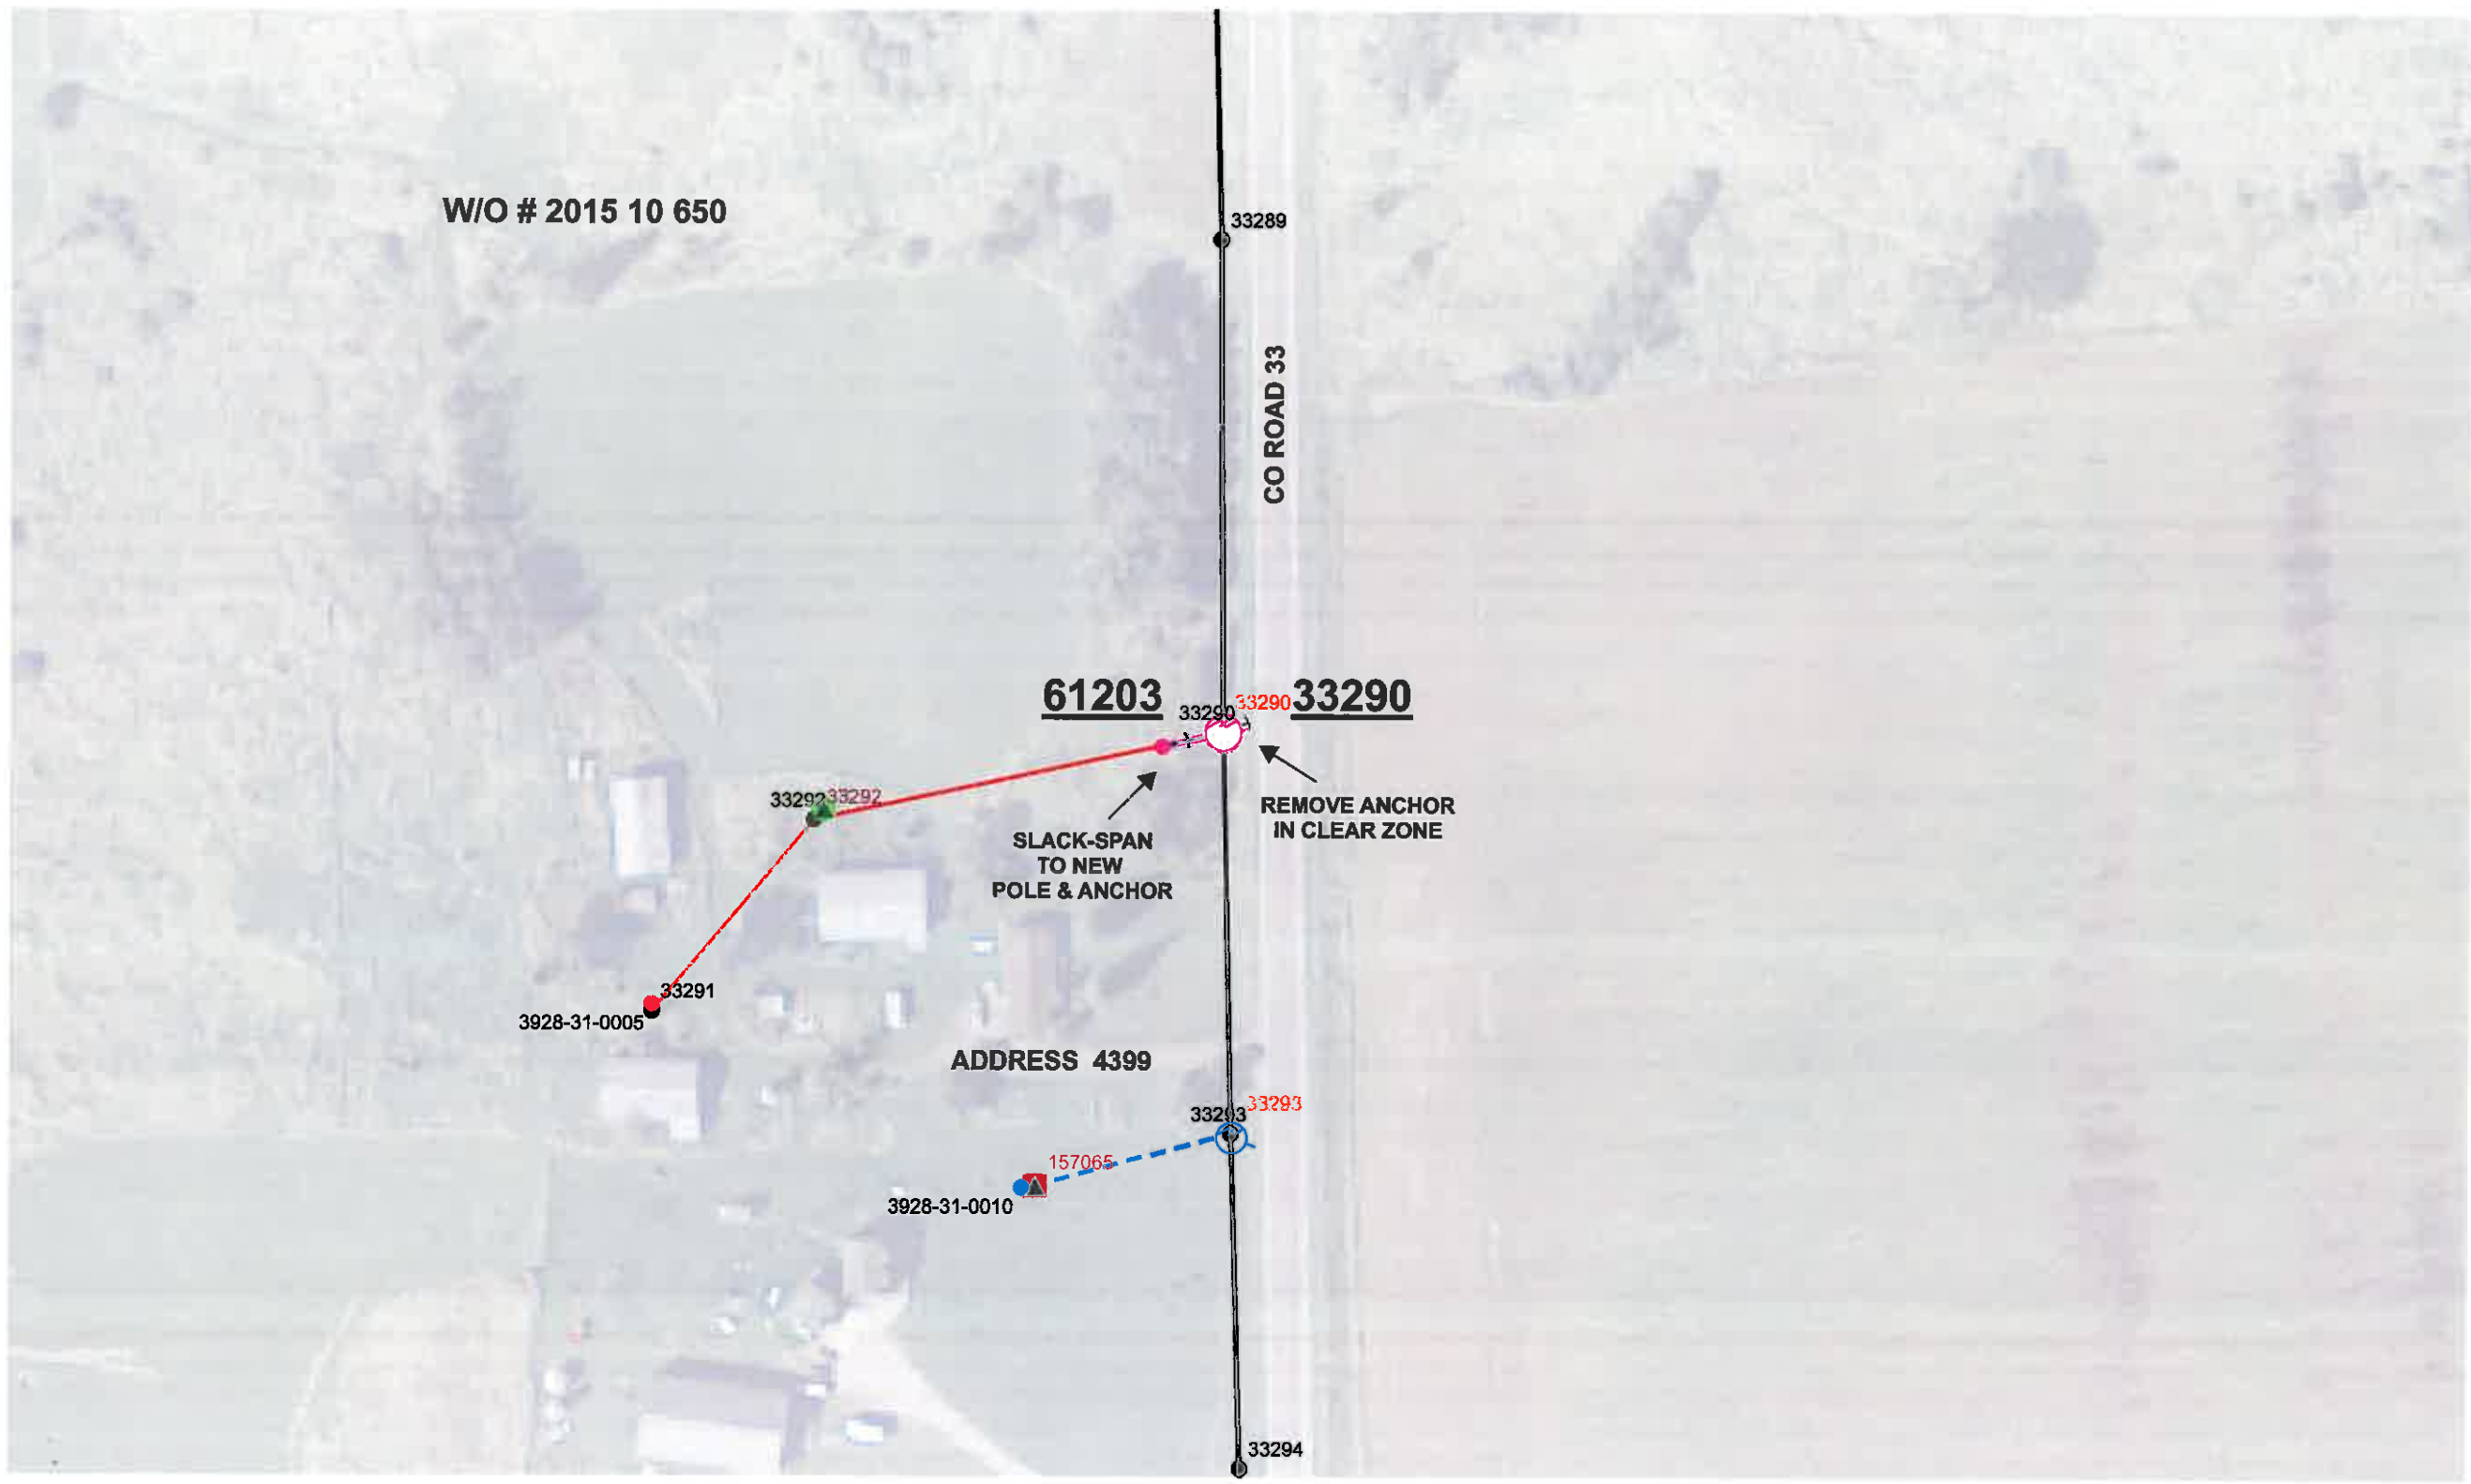

W/O # 2015 10 650-1

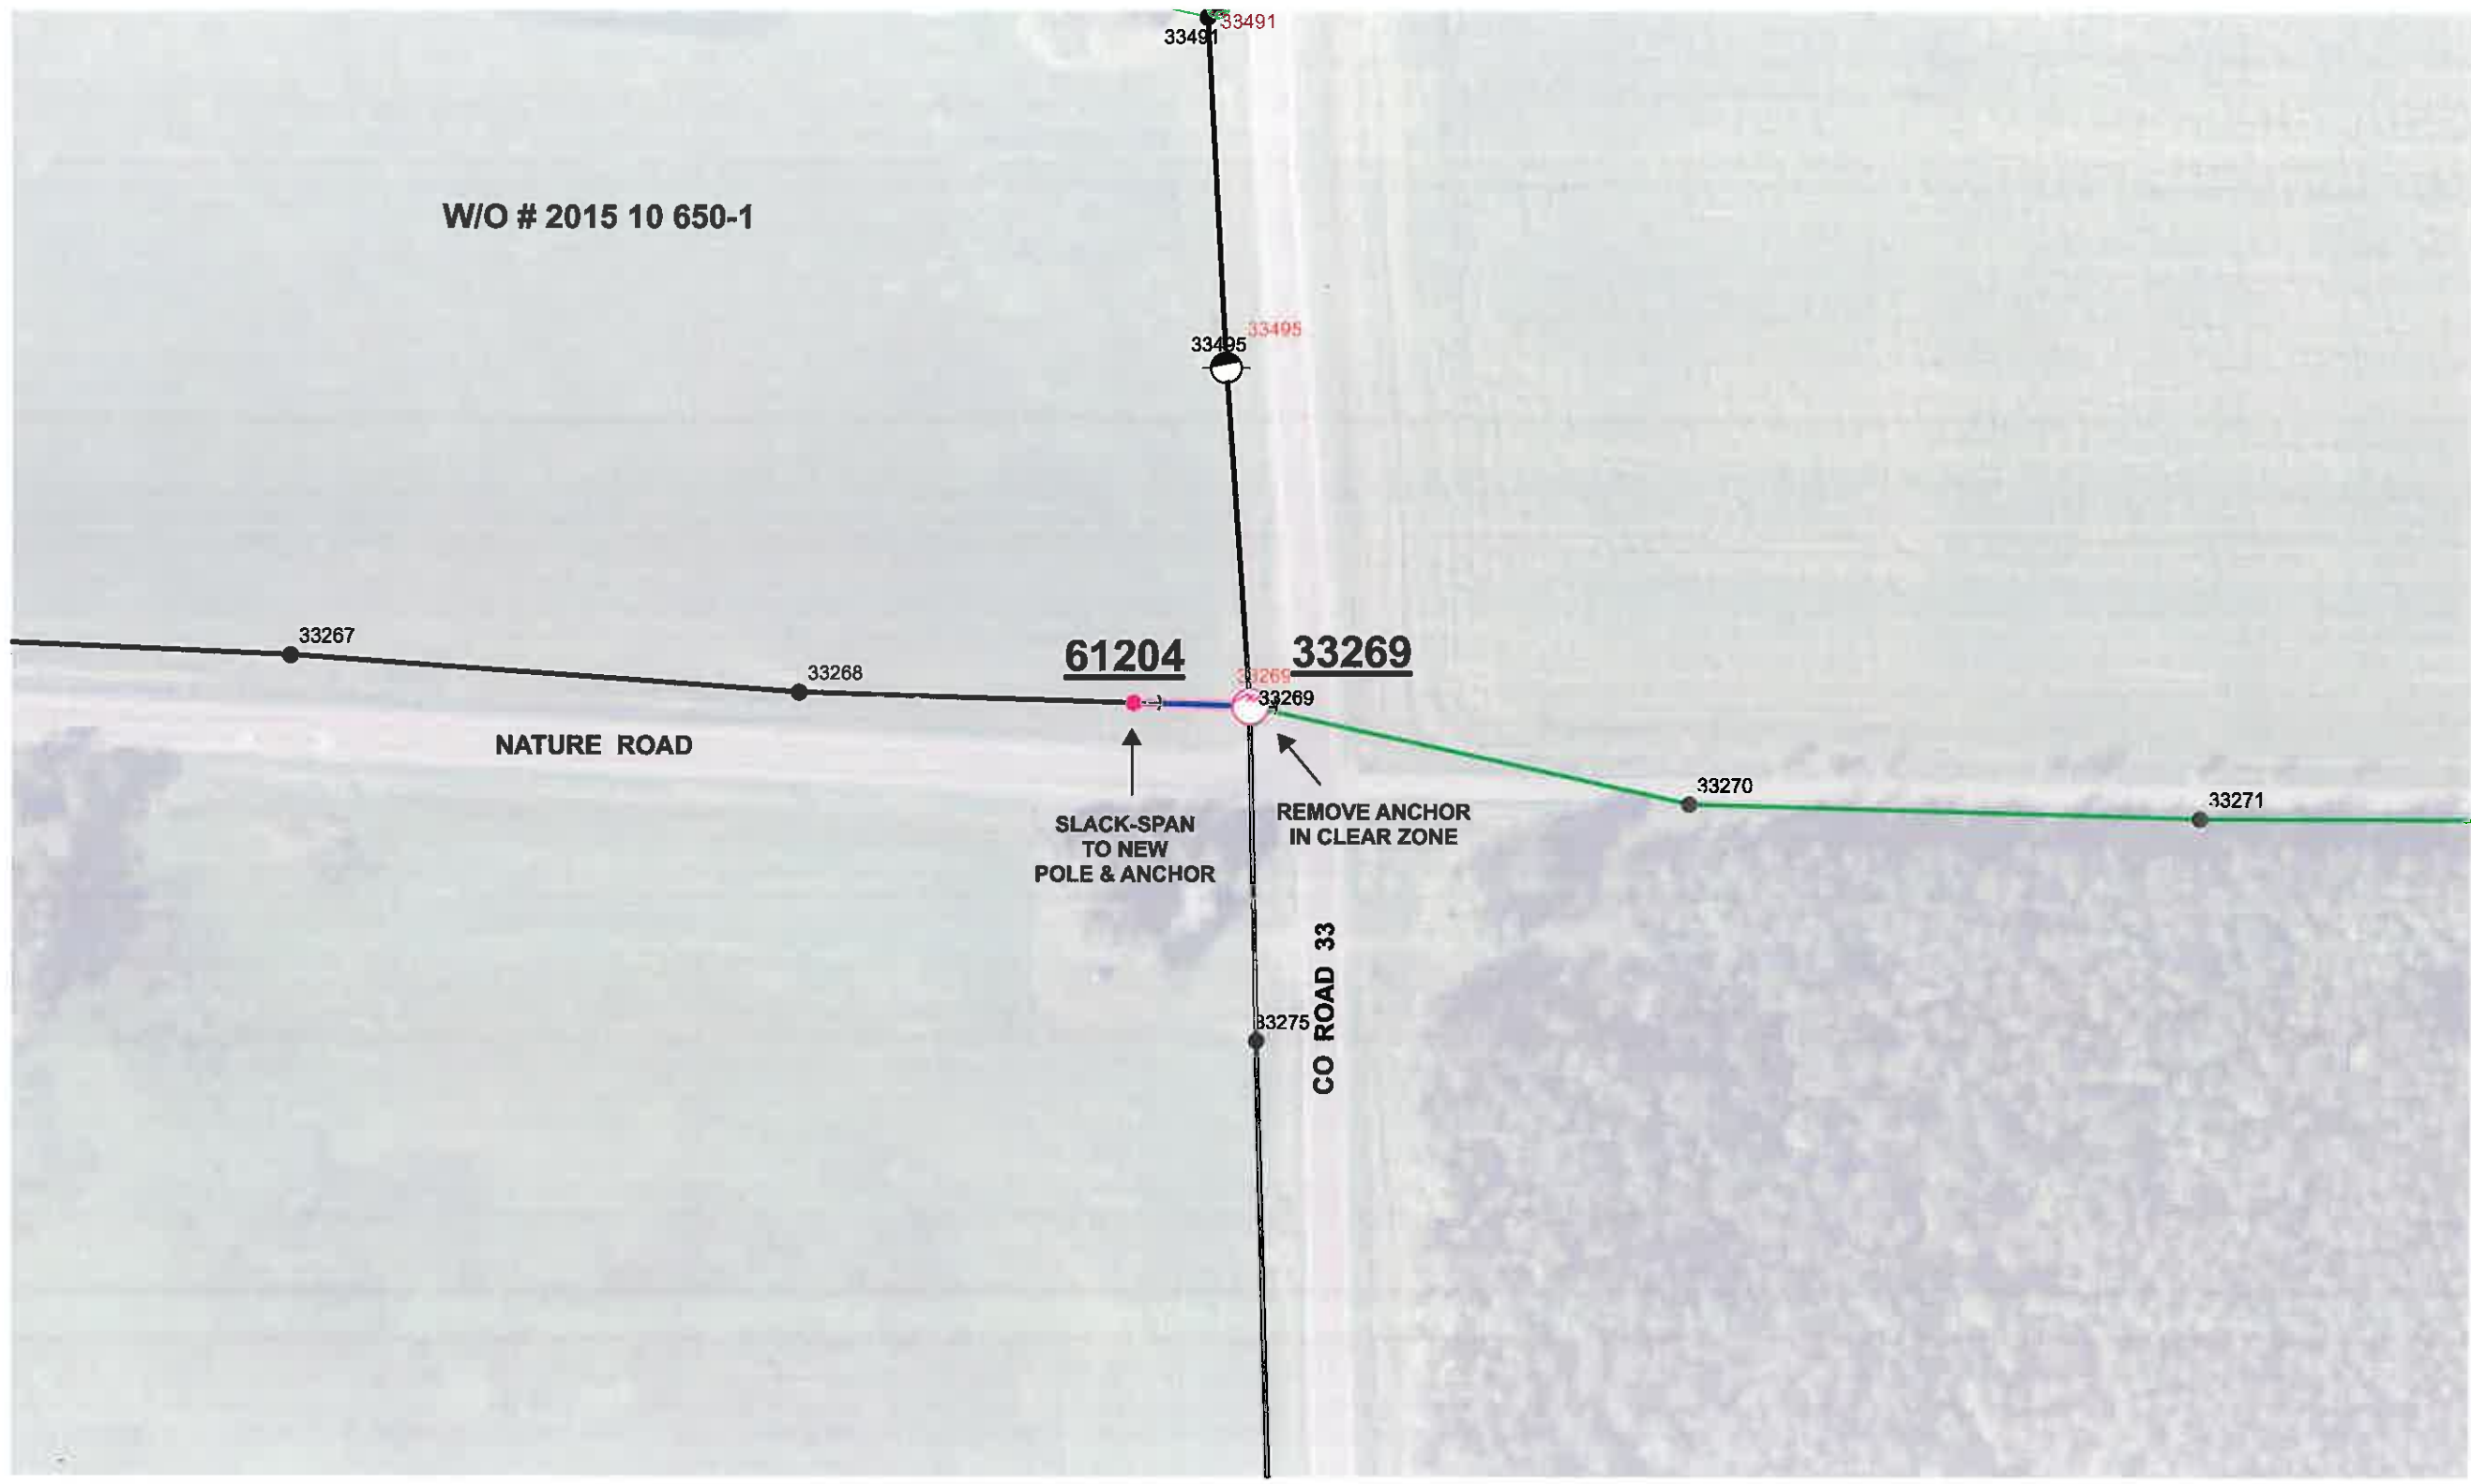

33491

33495

61204

33269

NATURE ROAD

CO ROAD 33

SLACK-SPAN
TO NEW
POLE & ANCHOR

REMOVE ANCHOR
IN CLEAR ZONE

33267

33268

33269

33270

33271

33275

W/O # 2015 10 650-2


32798

SET NEW POLE
17 FEET SOUTH OF
EXISTING POLE
STA 2126+35

32797


32797

32796

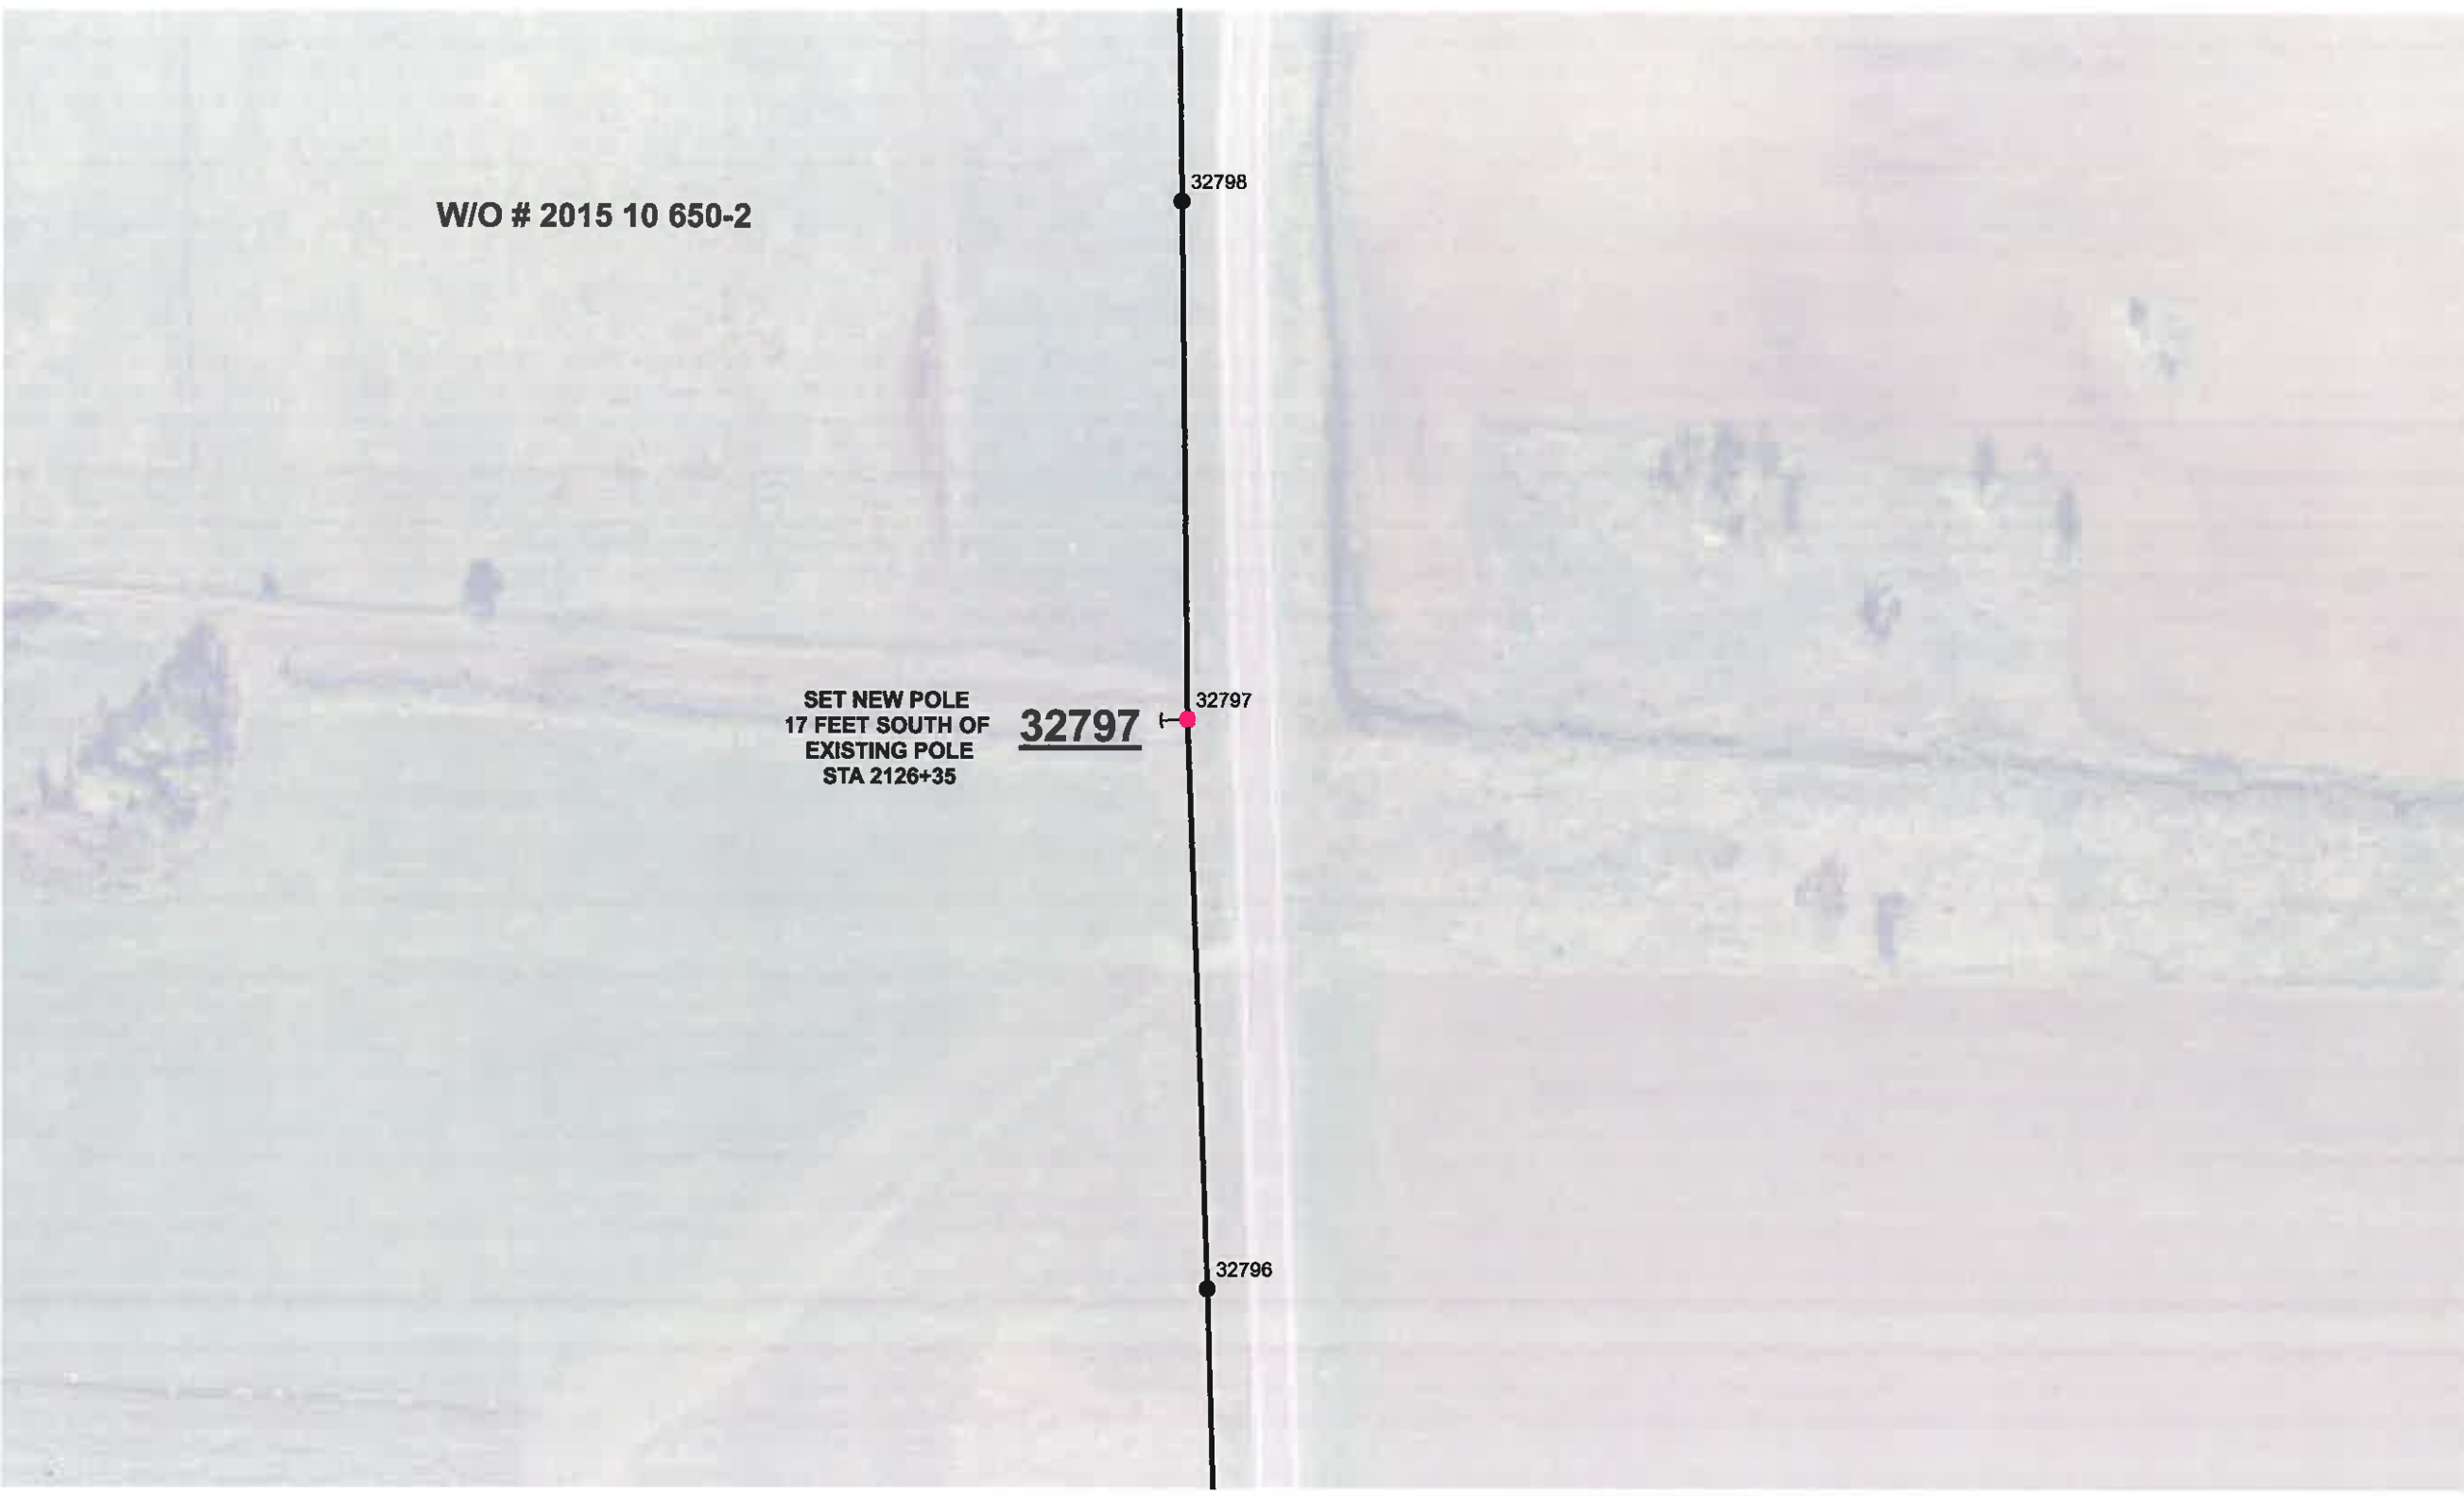

W/O # 2015 10 650-3

REMOVE THIS POLE,
SET NEW POLE 40
FEET NORTH... AWAY
FROM THE INTERSECTION

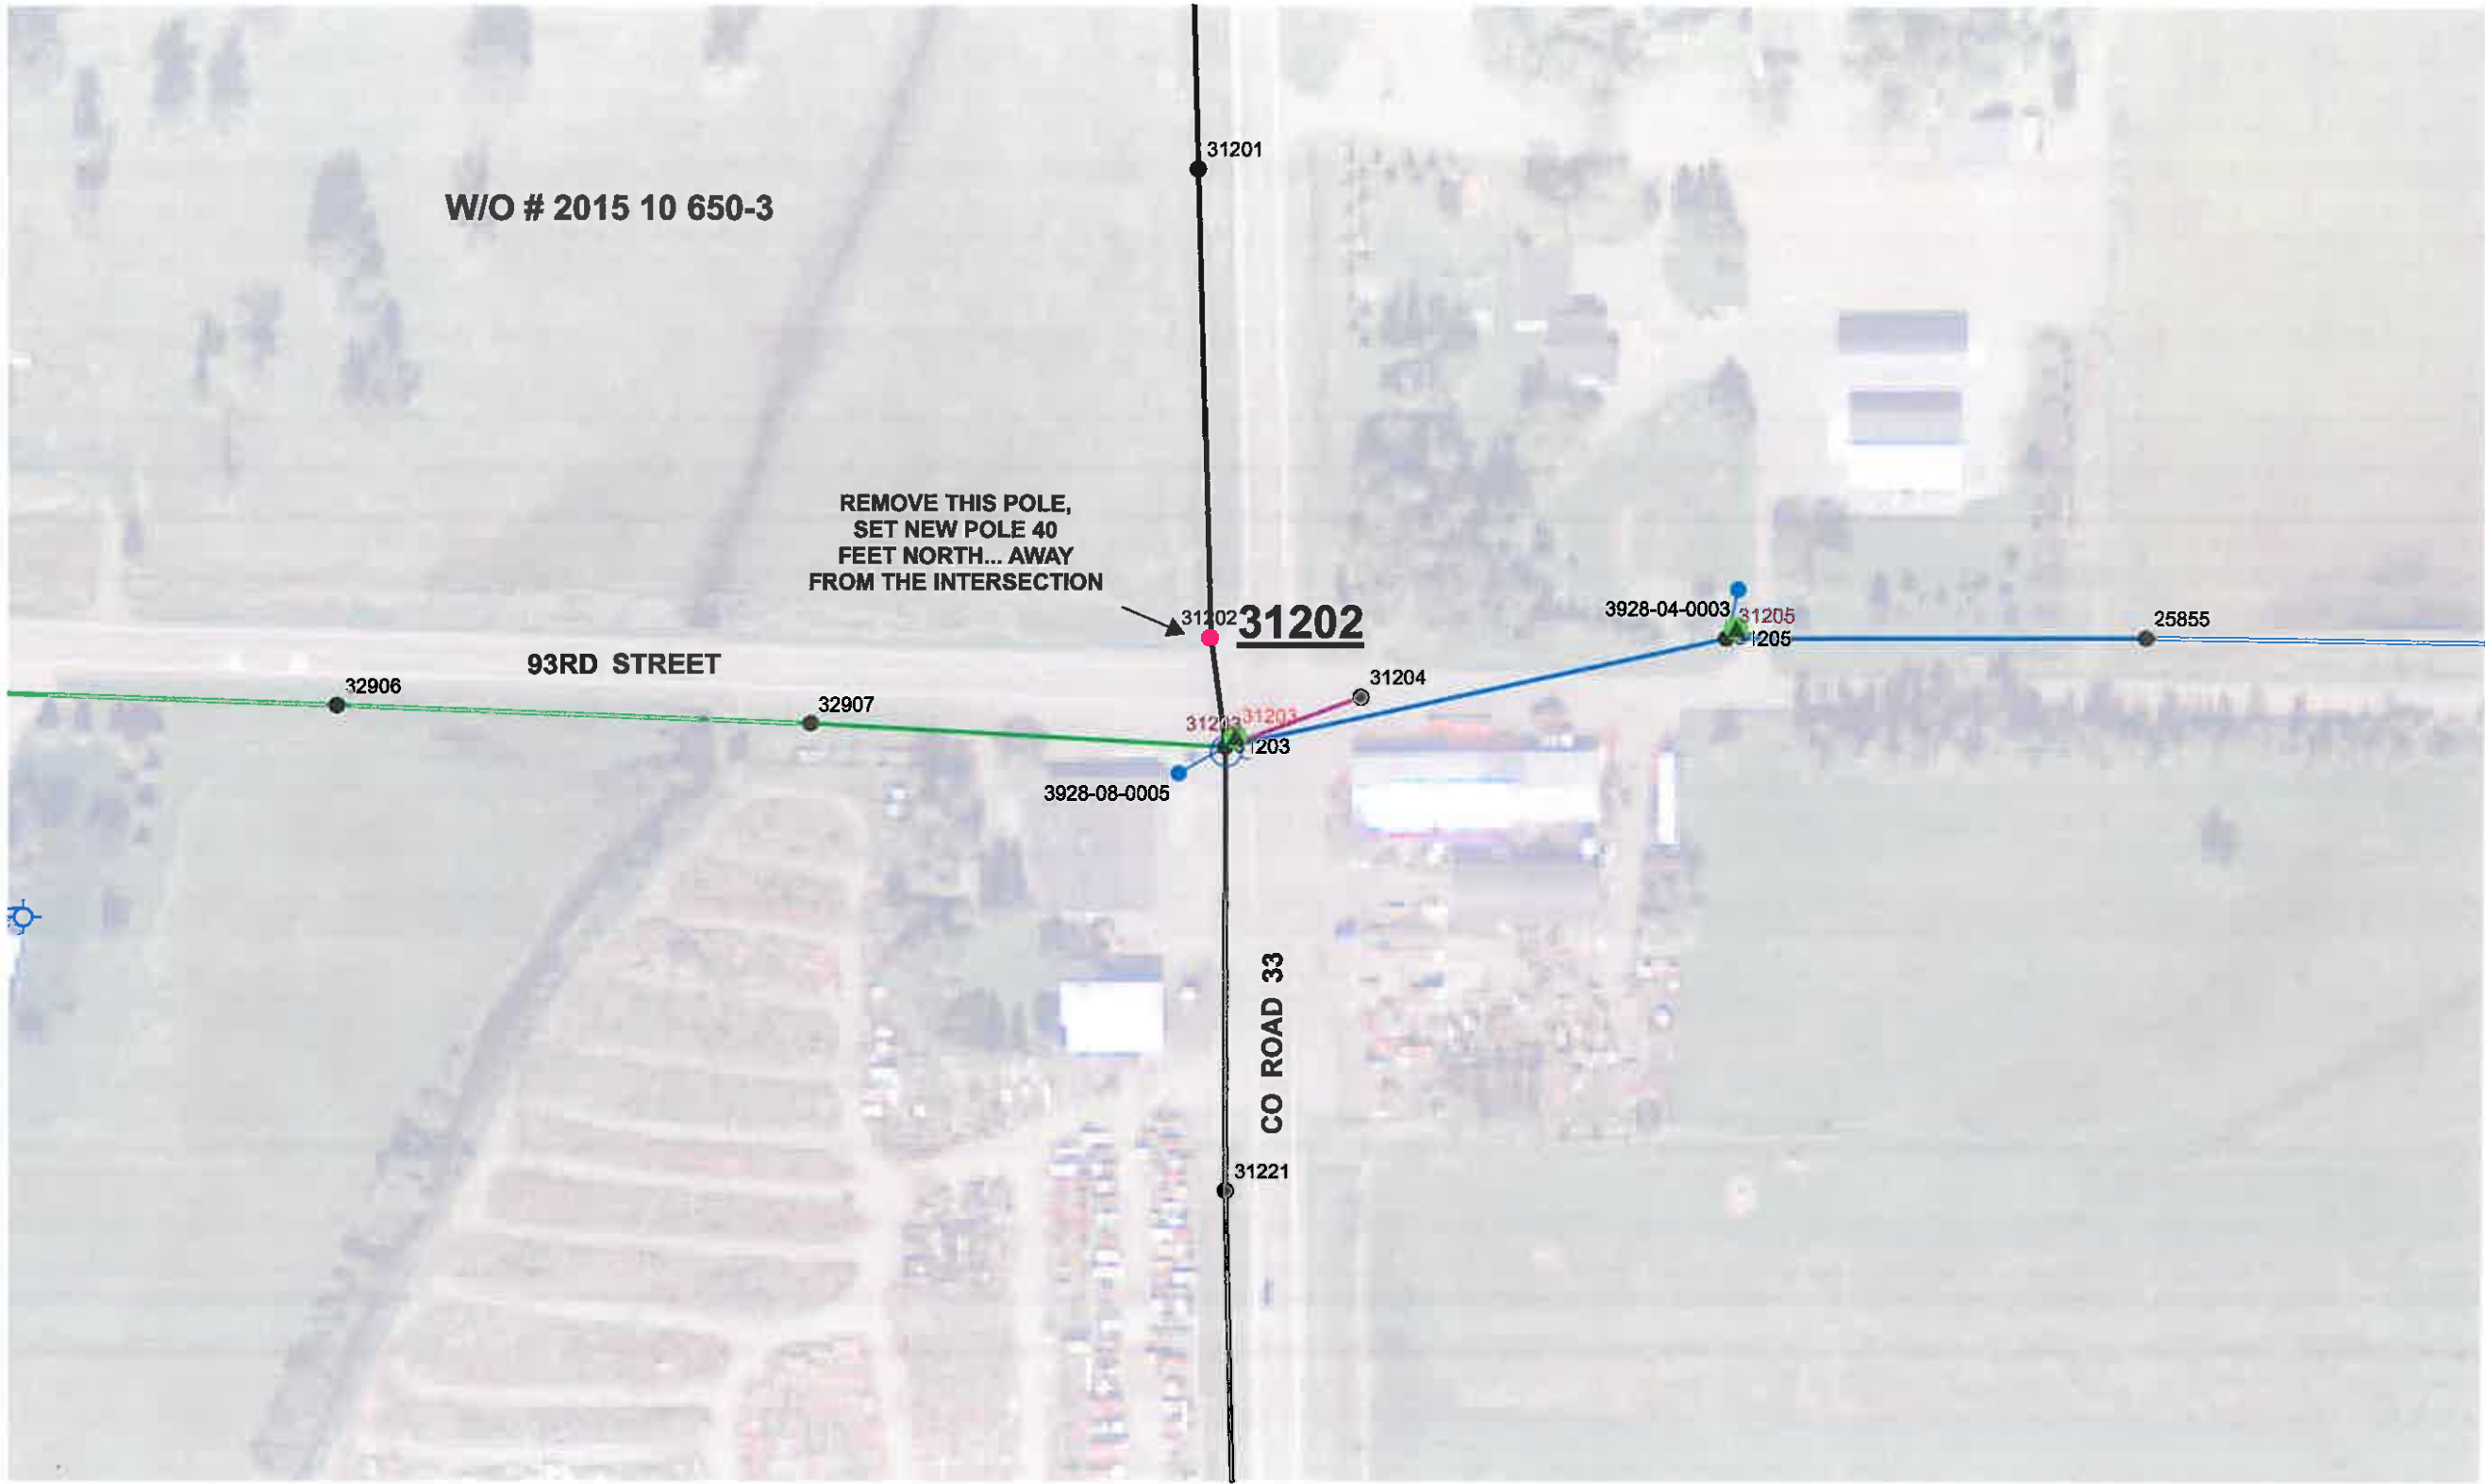

31201

31202

3928-04-0003 31205

25855

93RD STREET

32906

32907

31204

31203

3928-08-0005

CO ROAD 33

31221

W/O # 2015 10 650-4

30697

30696

4028-33-0005

61205

REMOVE THIS POLE,
SET NEW POLE 60
FEET NORTH

30698

33205

33206

31114


31115

31172

31173

103RD STREET

CO ROAD 33

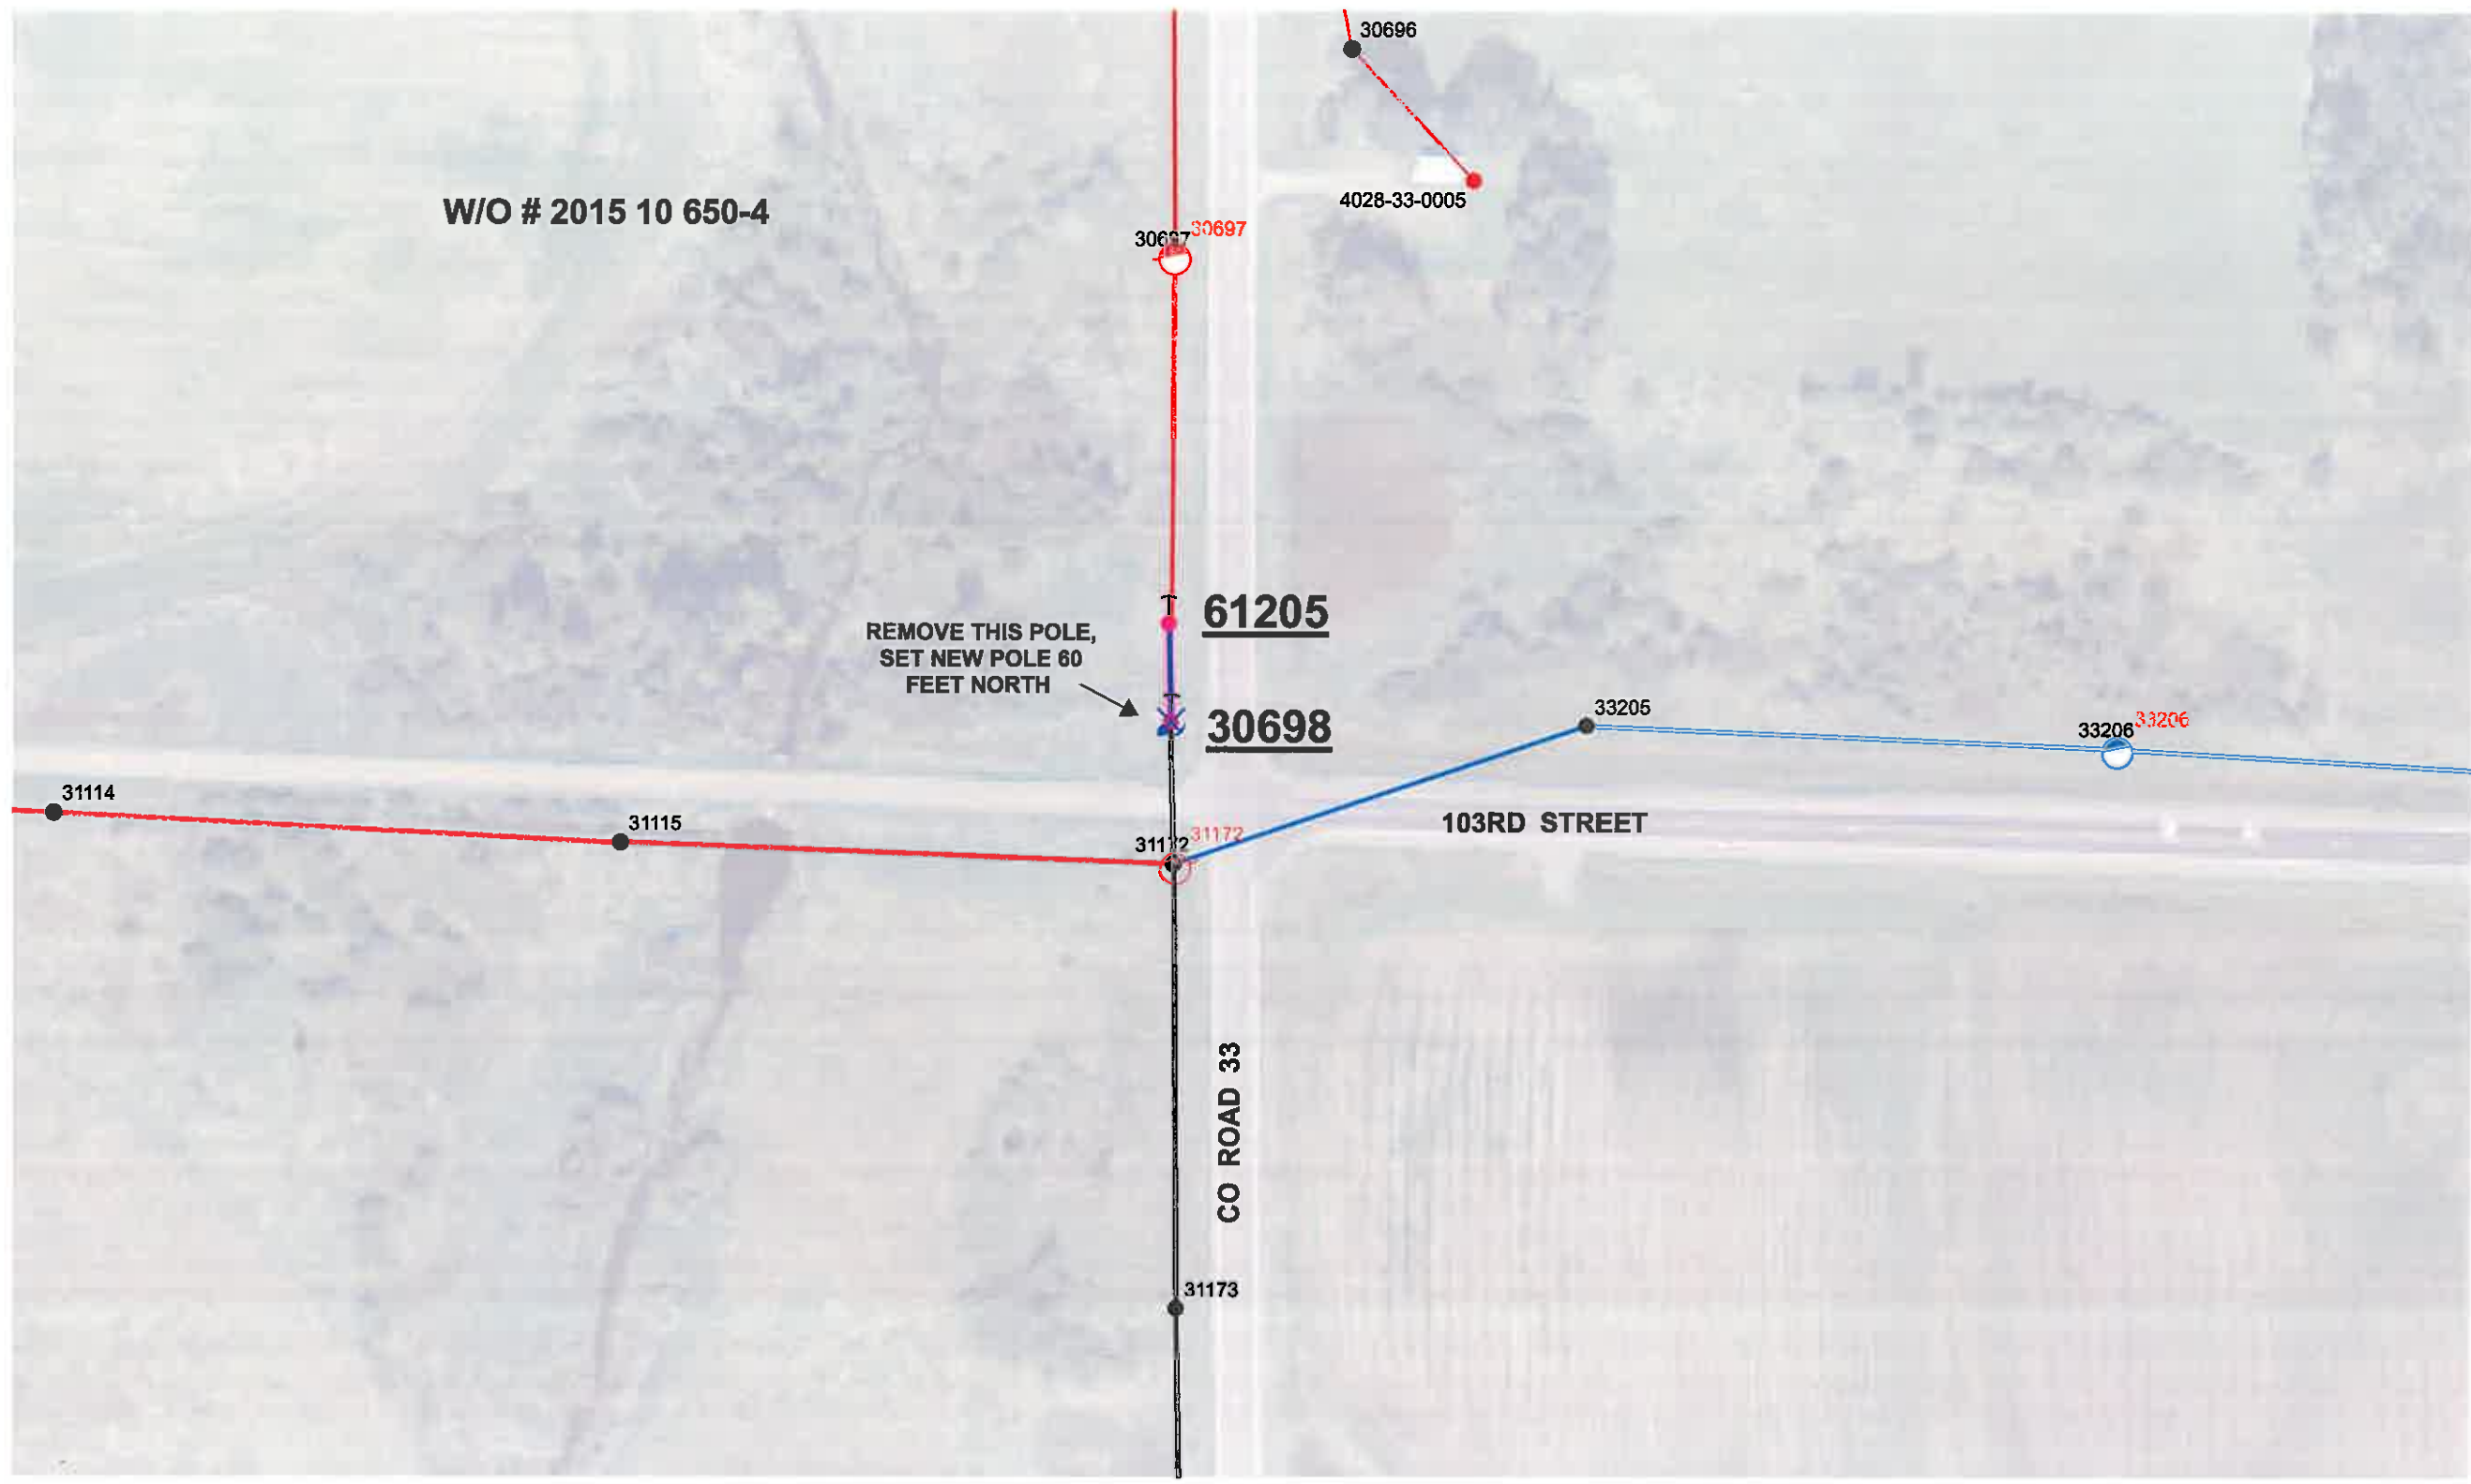

W/O 2015 10 650-5

4028-32-0001 30685
4028-32-0005

ADDRESS 10897

30684

SHORTEN THIS GUY
WIRE TO REMOVE IT
FROM CLEAR ZONE

30686

RETIRE ANCHOR IN
CLEAR ZONE, IT'S
NOT DOING ANYTHING


CO ROAD 33

30679

30680

30681

30687

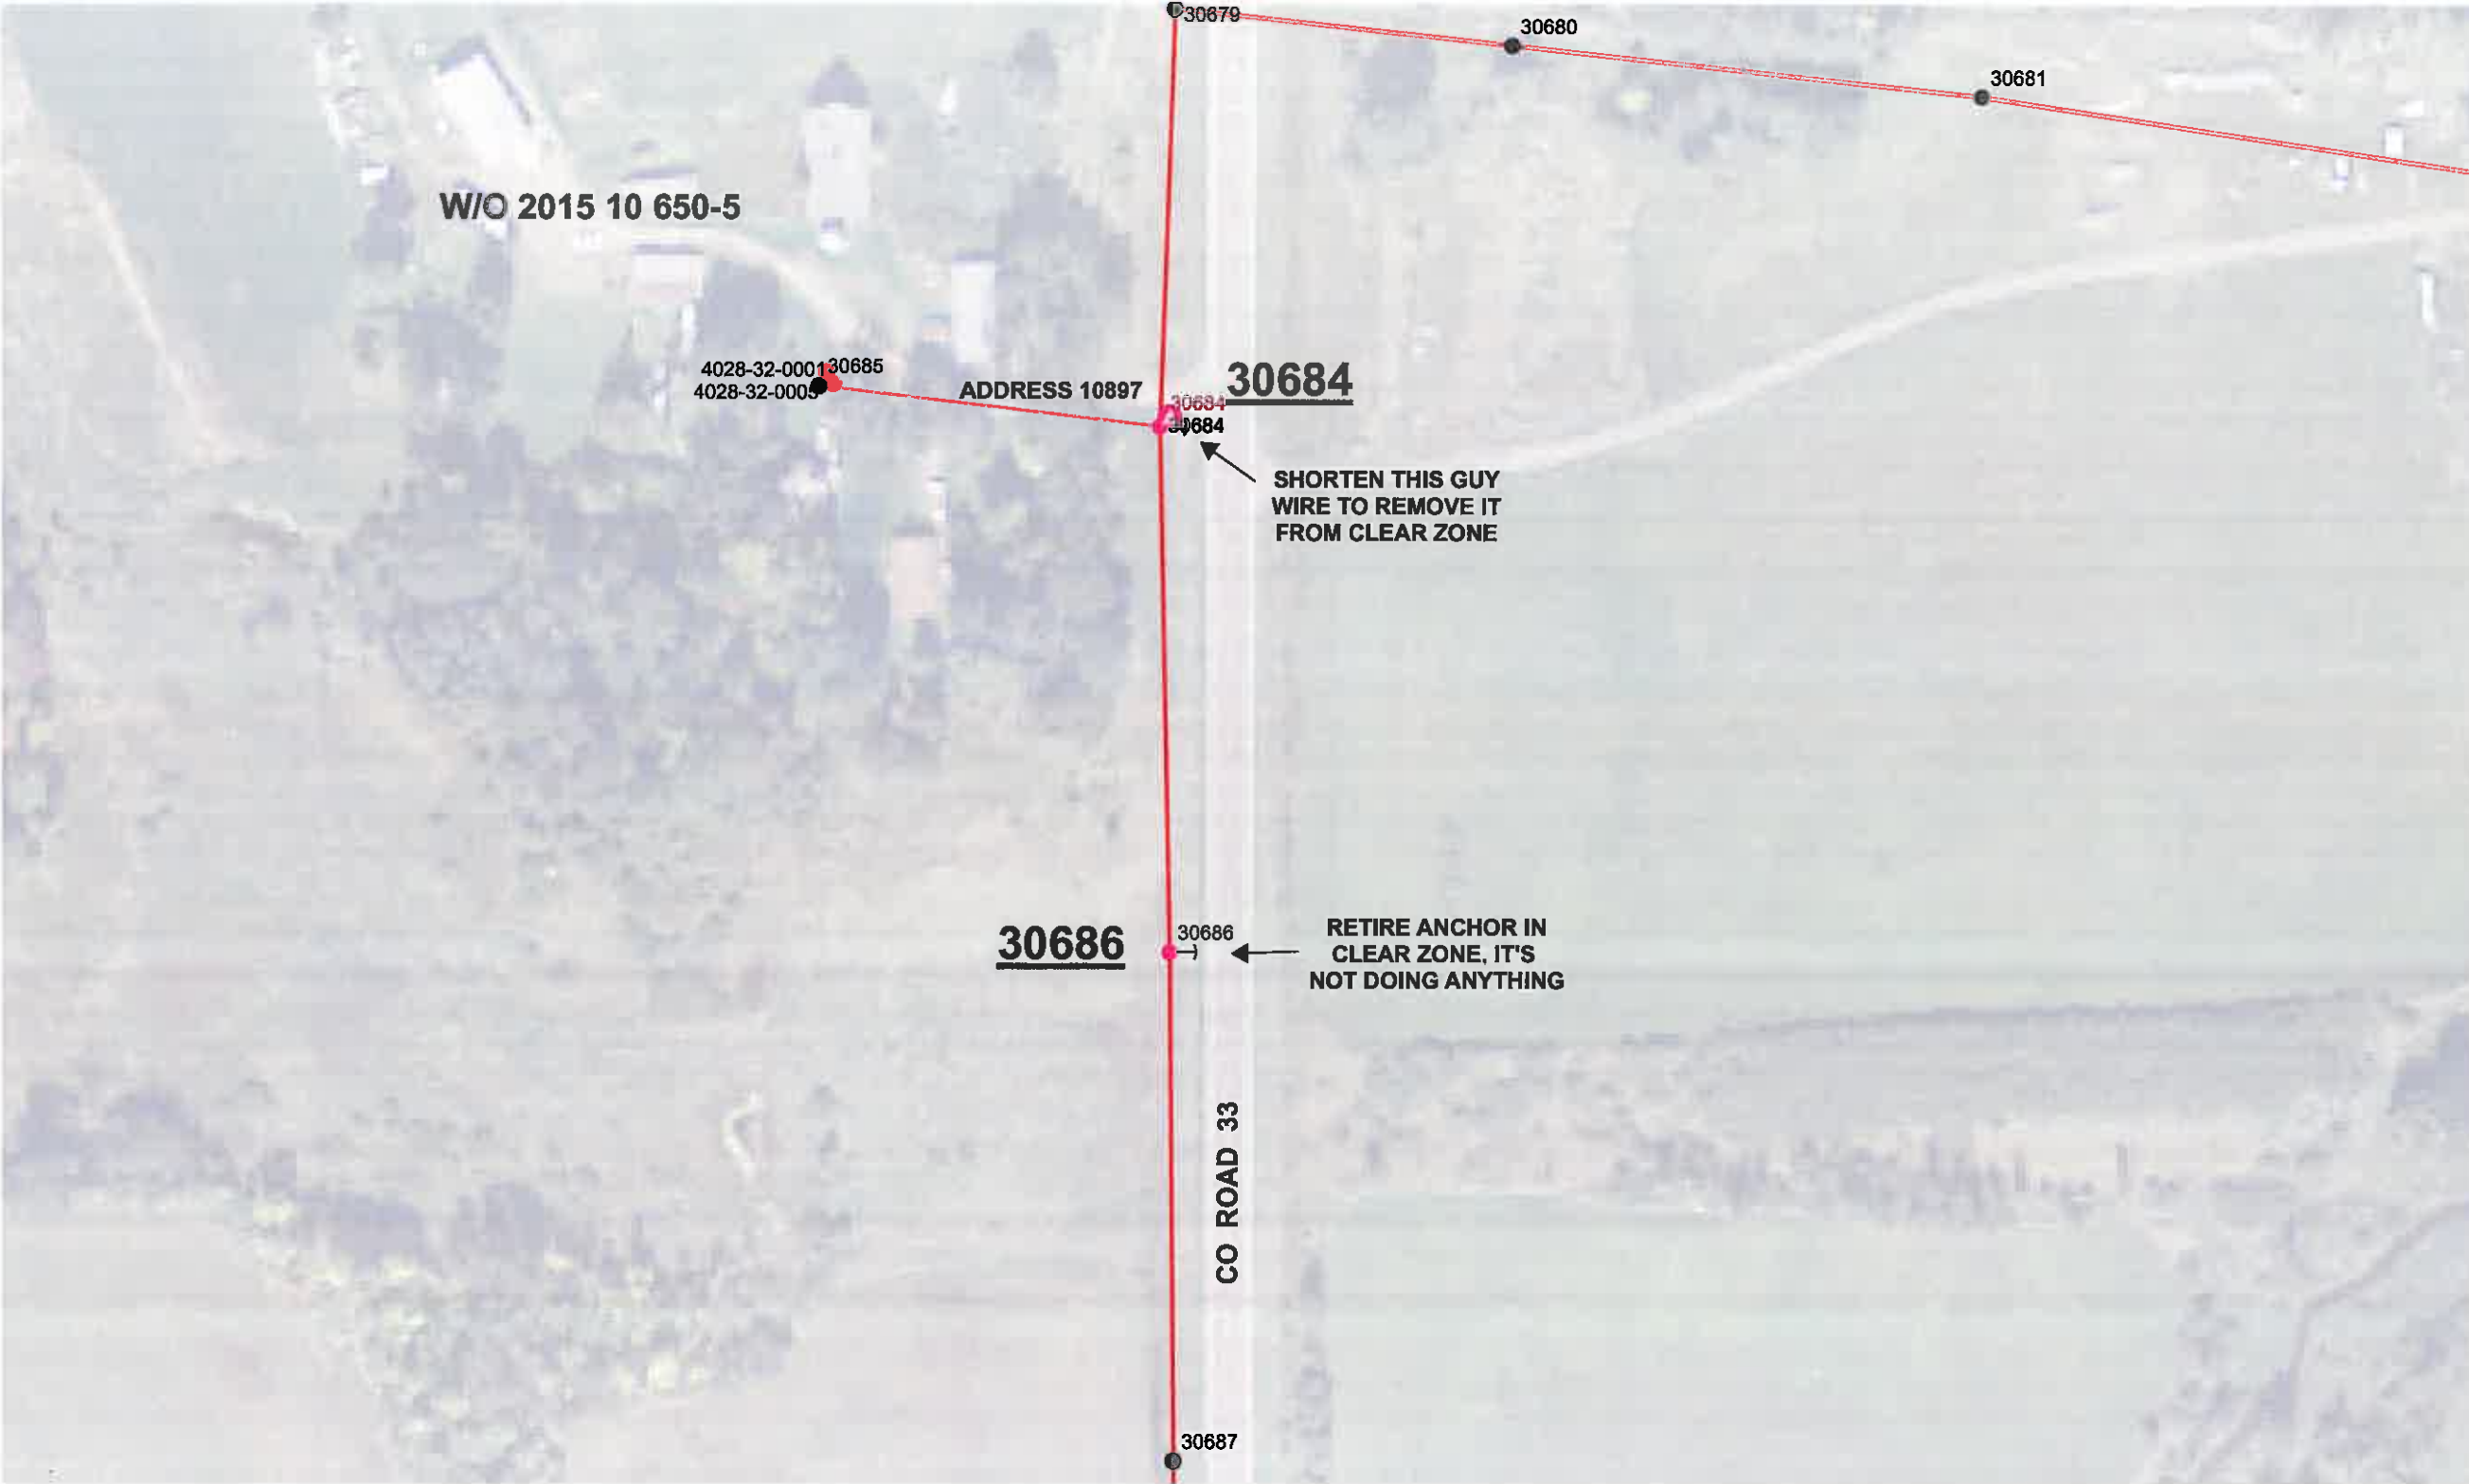

W/O 2015 10 650-6

30676

30676

1

155853

155855

4028-32-0004

155854

4028-33-0007

ADDRESS 11041

30678


4028-32-0006

30677

SHORTEN GUY LEAD
LENGTH THREE FEET

30679

30680

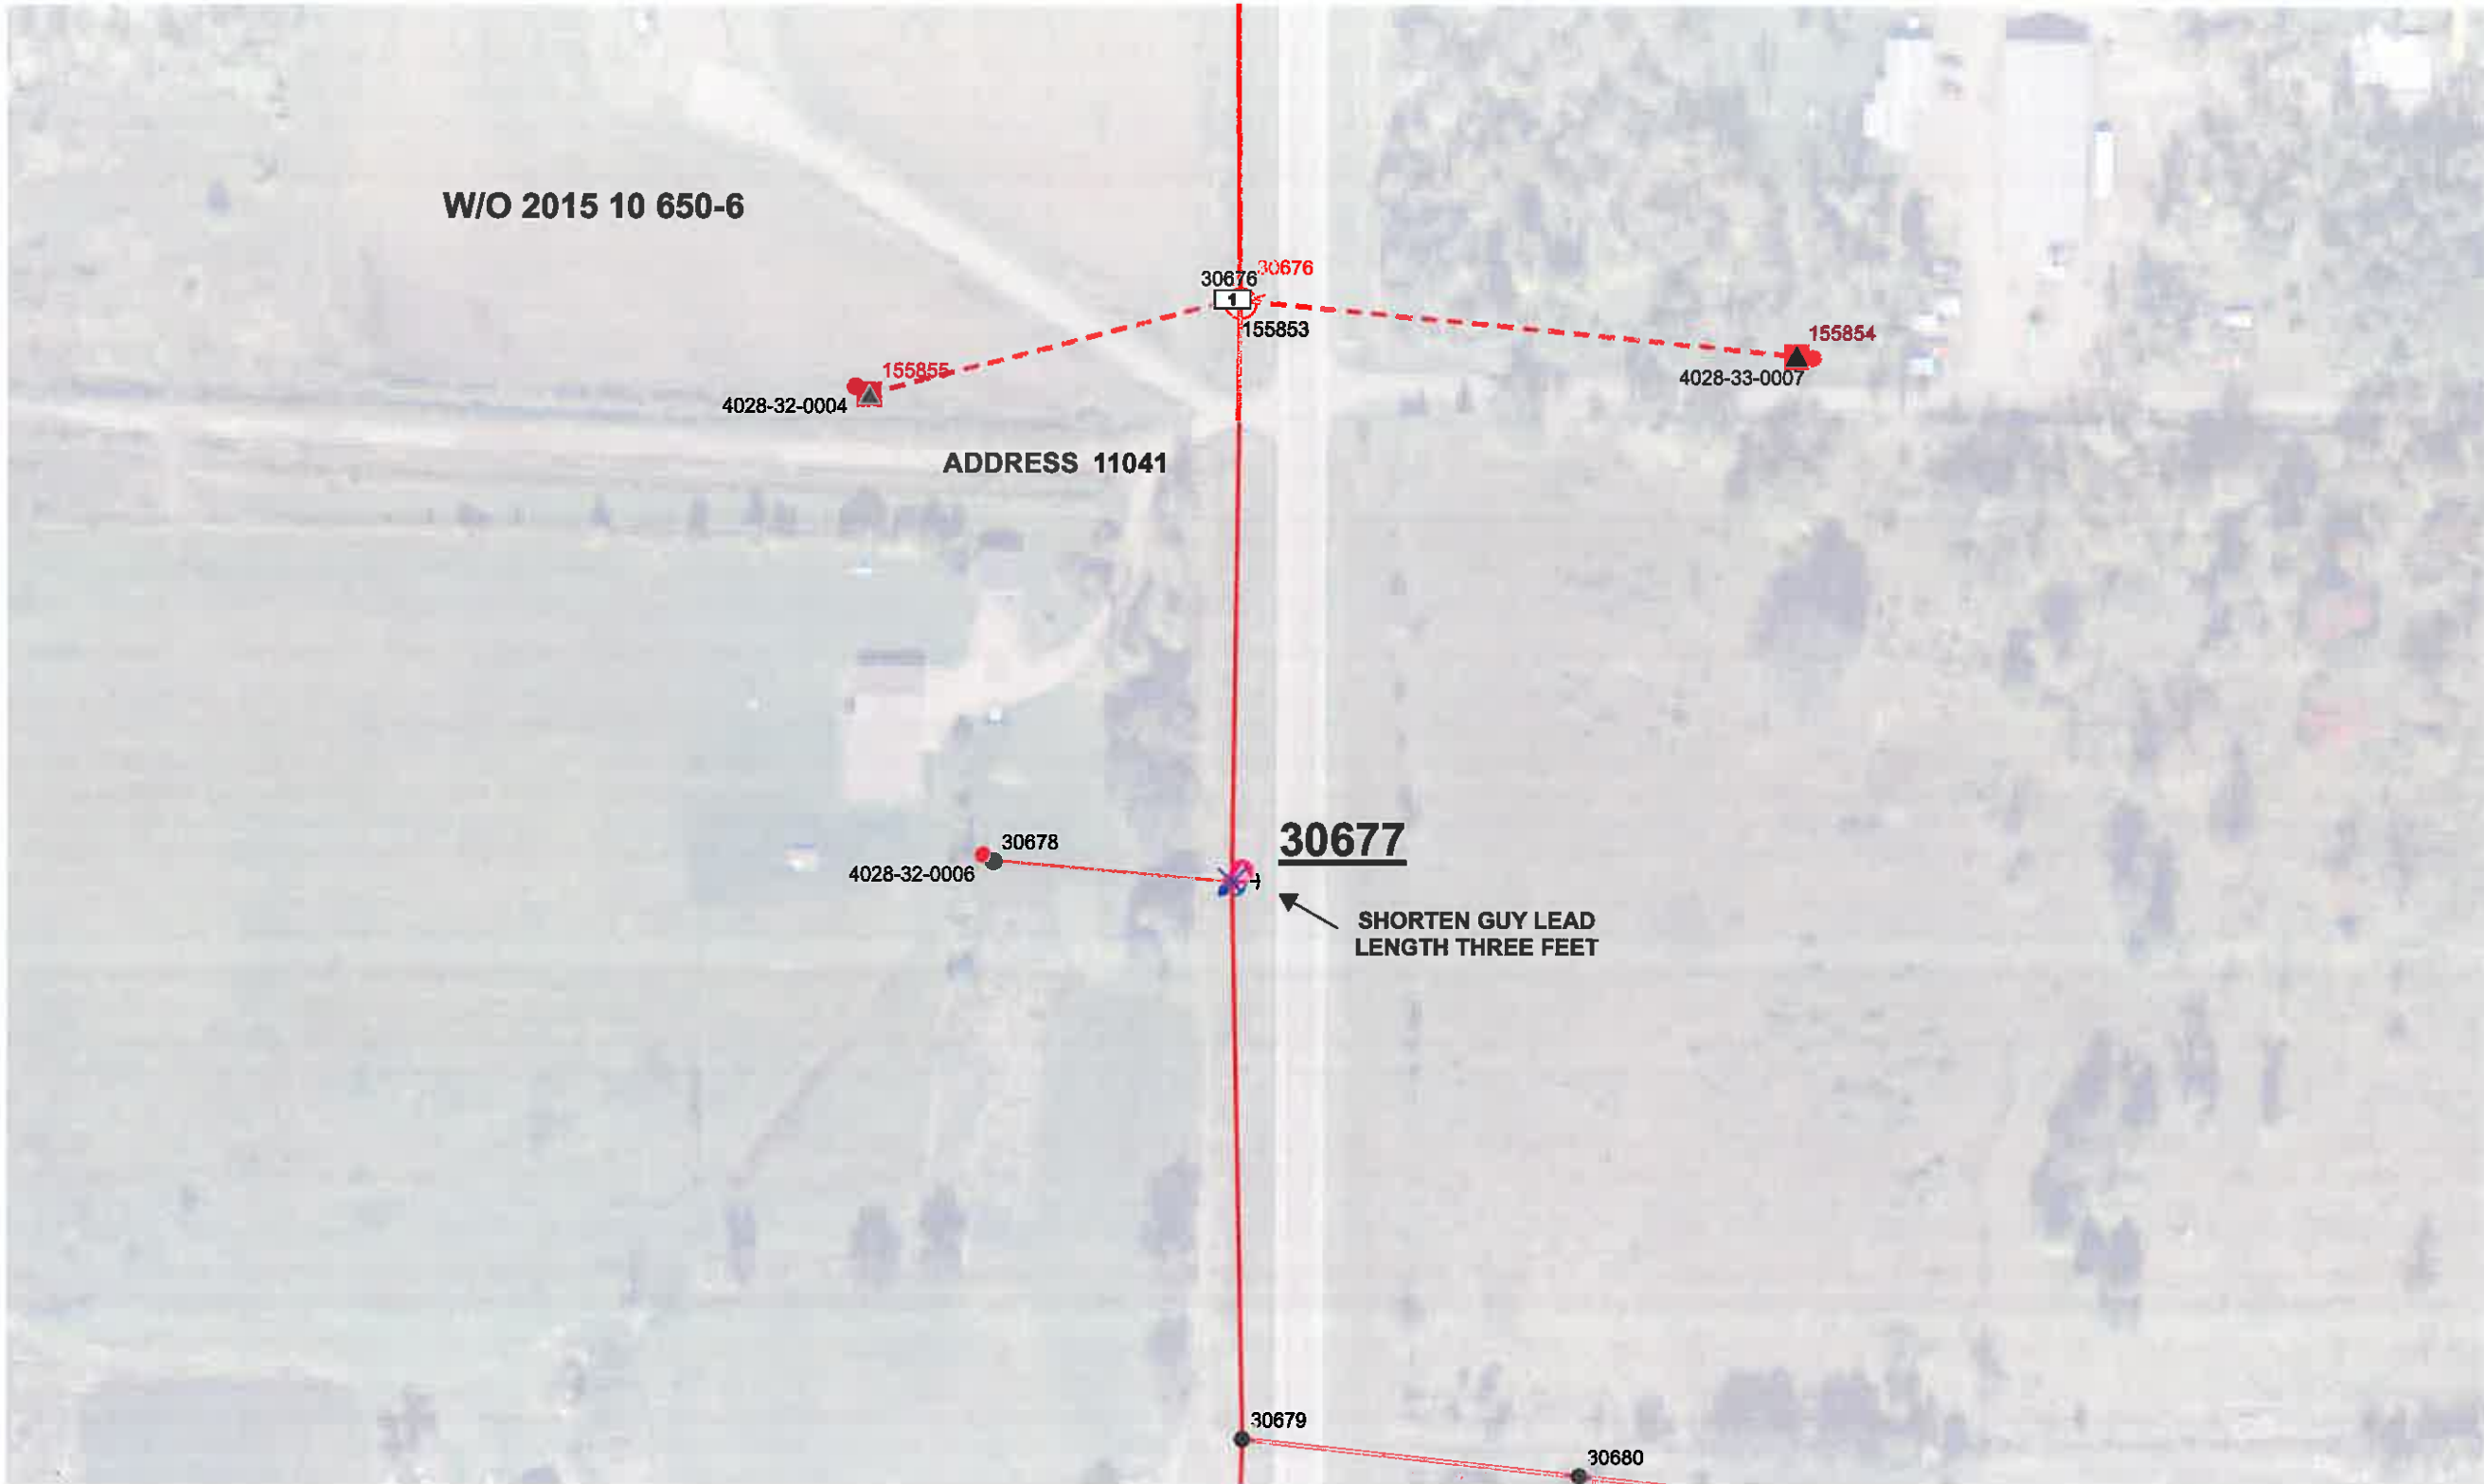

W/O # 2015 10 650-7

30620


RETIRE ANCHOR IN
CLEAR ZONE, THIS ACCOUNT
HAS URD SECONDARY WIRE

4028-20-0003
ADDRESS 12327

30622
4028-20-0002

30621
30621

28616
4028-21-0003

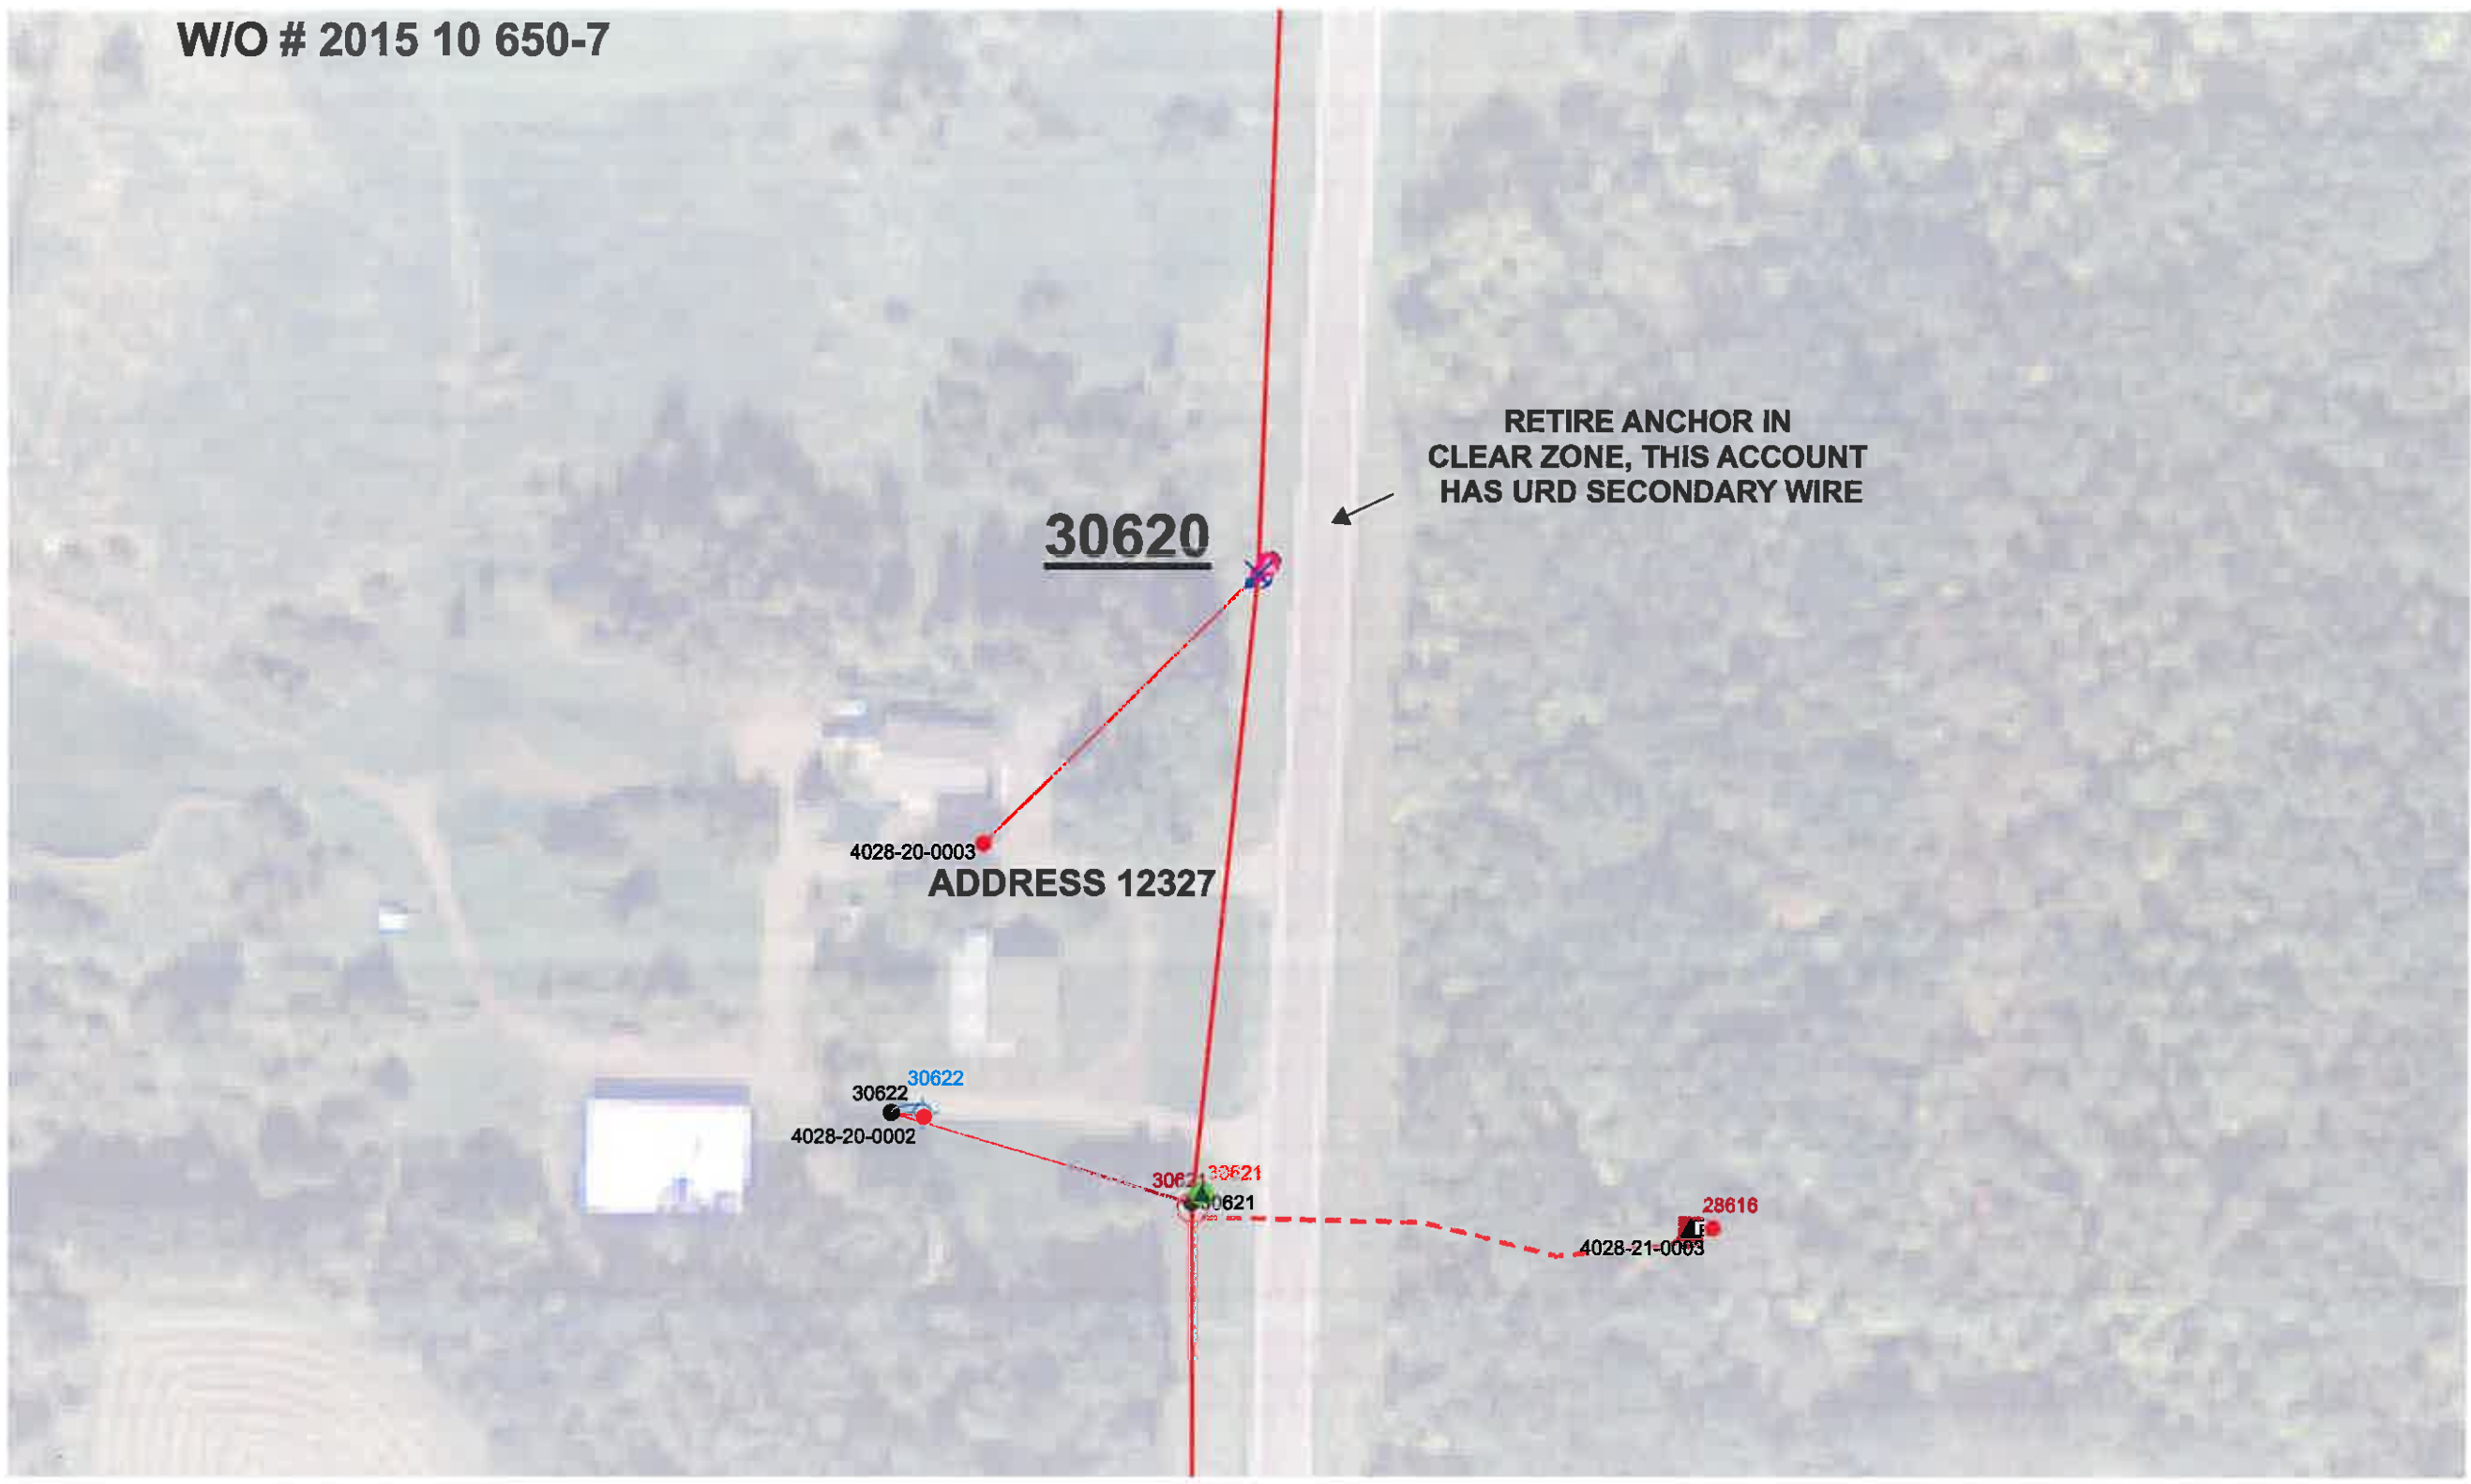

W/O # 2015 10 650-8

15374

CO ROAD 33

30592

30591

61206

30590

30590

133RD STREET


SLACK-SPAN TO
NEW POLE & ANCHOR

RETIRE ANCHOR IN
CLEAR ZONE

30601

30602

30602

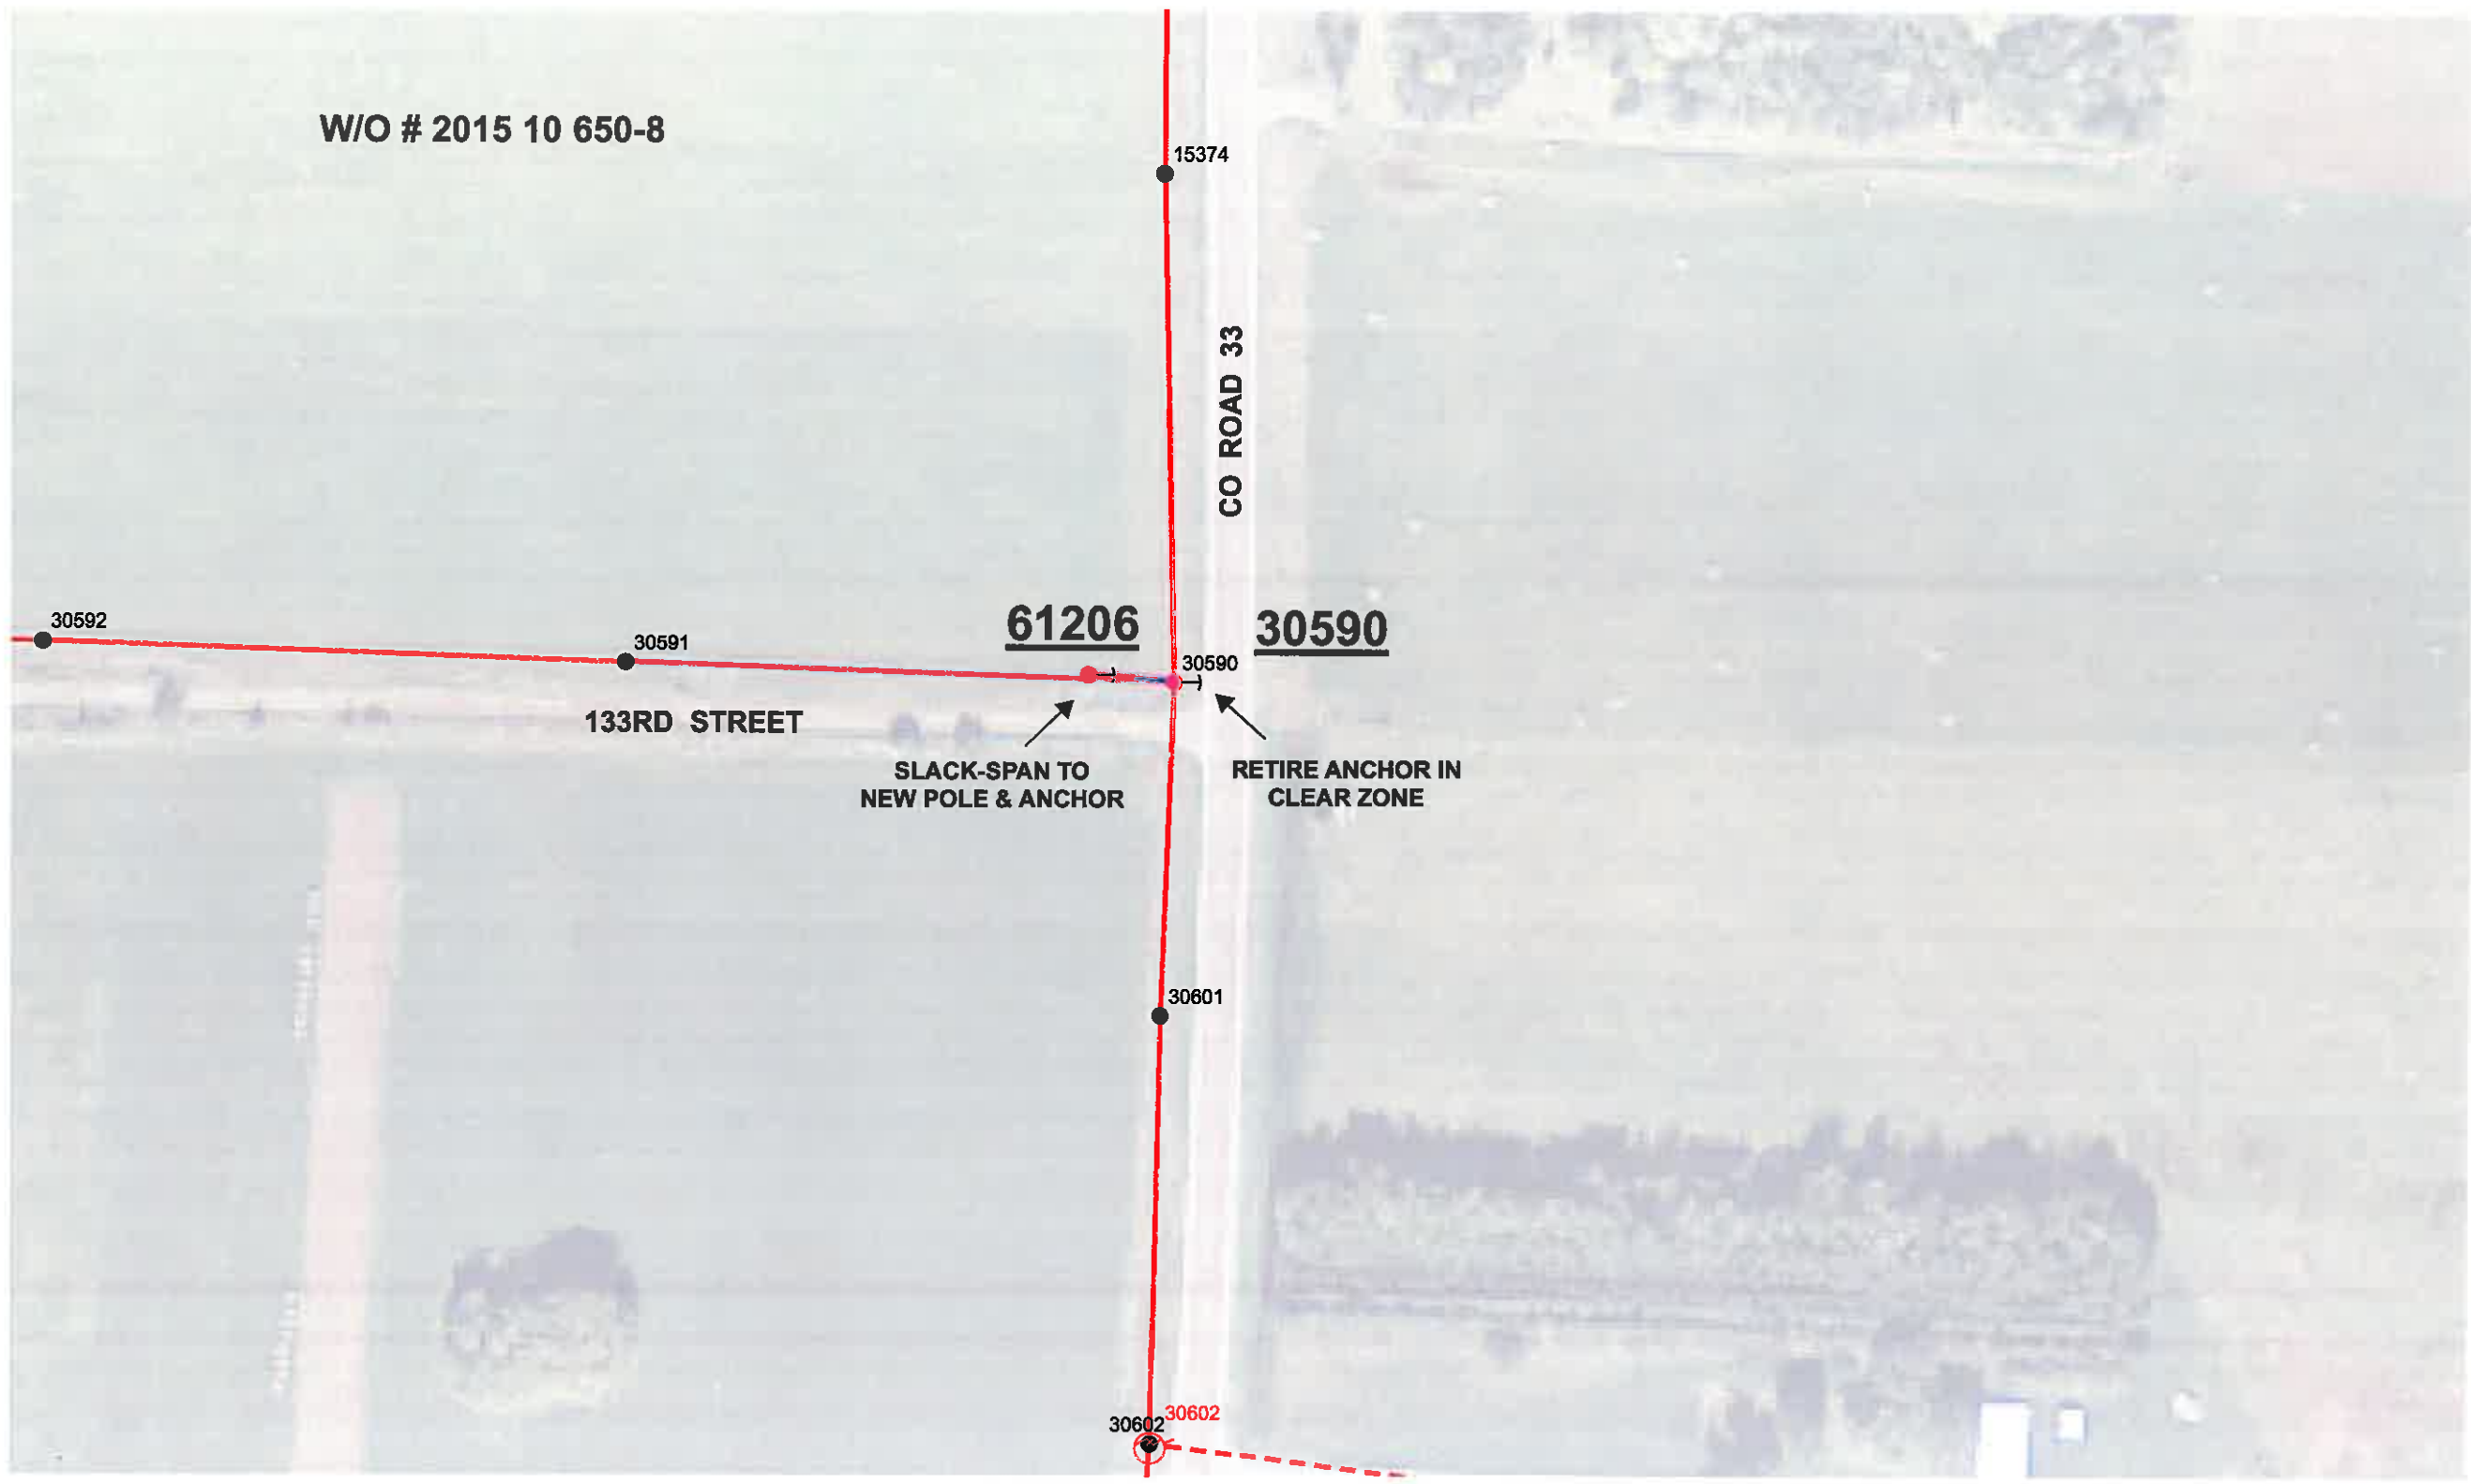

W/O # 2015 10 650-9

15380

30589
30589
4028-17-0002

ADDRESS 13635

15379

15379

REMOVE TWO ANCHORS
FOR CULVERT WORK,
PUT BACK IN WHEN THEY
ARE DONE

15378

CO ROAD 33

15377

W/O 2015 10 650-10

15387

CO ROAD 33

15386

15386

RETIRE ANCHOR IN
CLEAR ZONE, FAN-OUT
2 NEW ANCHORS
AT 12 FEET

30583

30583

4028-17-0001

30583

ADDRESS 14023

15385

