

DISTANCE FROM C ROAD

SEE NOTATION

STAKED BY: ERR

DATE: 6-3-15

REV.

REV.

AS BUILT BY:

DATE:

PROJECT:

MN 537

EXCHANGE:

Randall

TOWNSHIP:

CUSHING



TWP 131 N

RNG 30 W

SEC. 25 24 30 19

CO. Morrison

ROUTE:

SHEET: 6 OF

SERVICE AREA: Randall



25 24
30 19

BM (1)(1.25) 90'

CR 205

BFO 24

CRP

26119

BM 60 (1)(1.25) 40'

GRASS

FIELD

CR 206 70TH ST.

CR 205 70TH ST.

18+38
0+00

3+04

3+36

4+04

4+08

4+84

4+88

32' 1/2

7+46

9+40

9+46

9+70

10+10

11+12

12+74

32' 1/2

15+48

WOODS

HOUSING NO.

BA

BDO

BFO

BH

BM

HBF

HO

NID


SUB NO.

SE

UD

UO

[illegible]

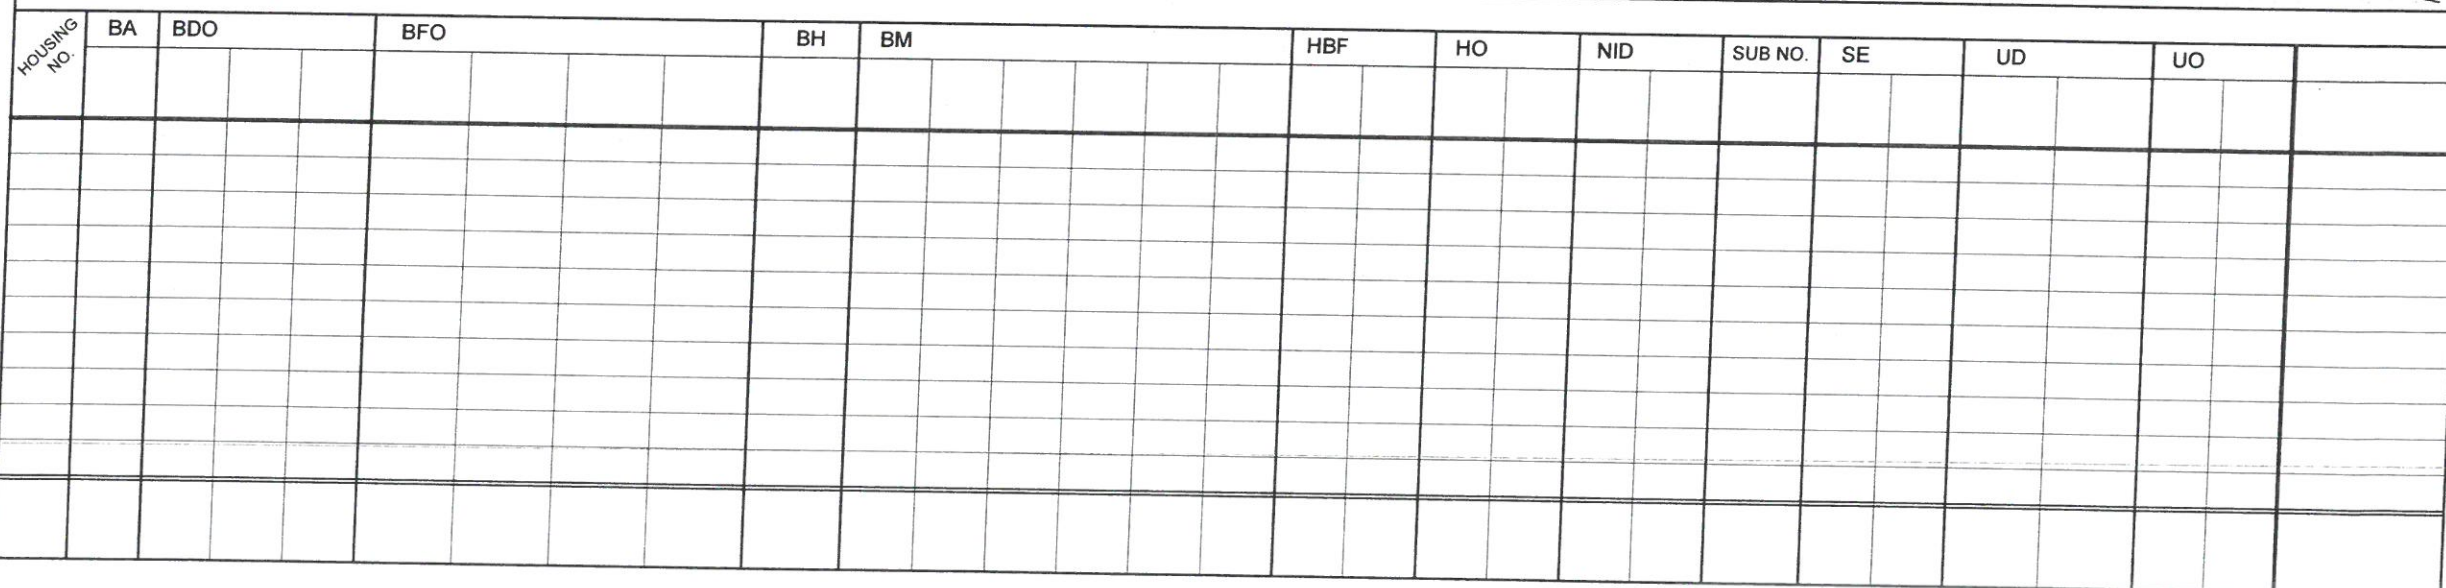

[illegible]



DISTANCE FROM C ROAD

SEE NOTATION



TWP 131 N

RNG 31 W

SEC. 31
30

CO. Morrison

ROUTE:

SHEET: 1 OF

SERVICE AREA: Randall

STAKED BY: ERR

DATE: 6-2-15

PROJECT:

MN 537

REV.

REV.

EXCHANGE:

Randall

AS BUILT BY:

DATE:

TOWNSHIP:

CUSHING

CSAH 1 DOVERD.

1+00

Δ+00

Δ+00

Δ+48

Δ+58

Δ+66

WOODS @ 68'±

FIELD

BFOZY

CR 206

250TH ST.

WOODS

35'±

2+34

4+78

5+78

7+22

9+64

10+18

13+02

13+16

HOUSING
NO.

BA

BDO

BFO

BH

BM

HBF

HO

NID


SUB NO.

SE

UD

UO



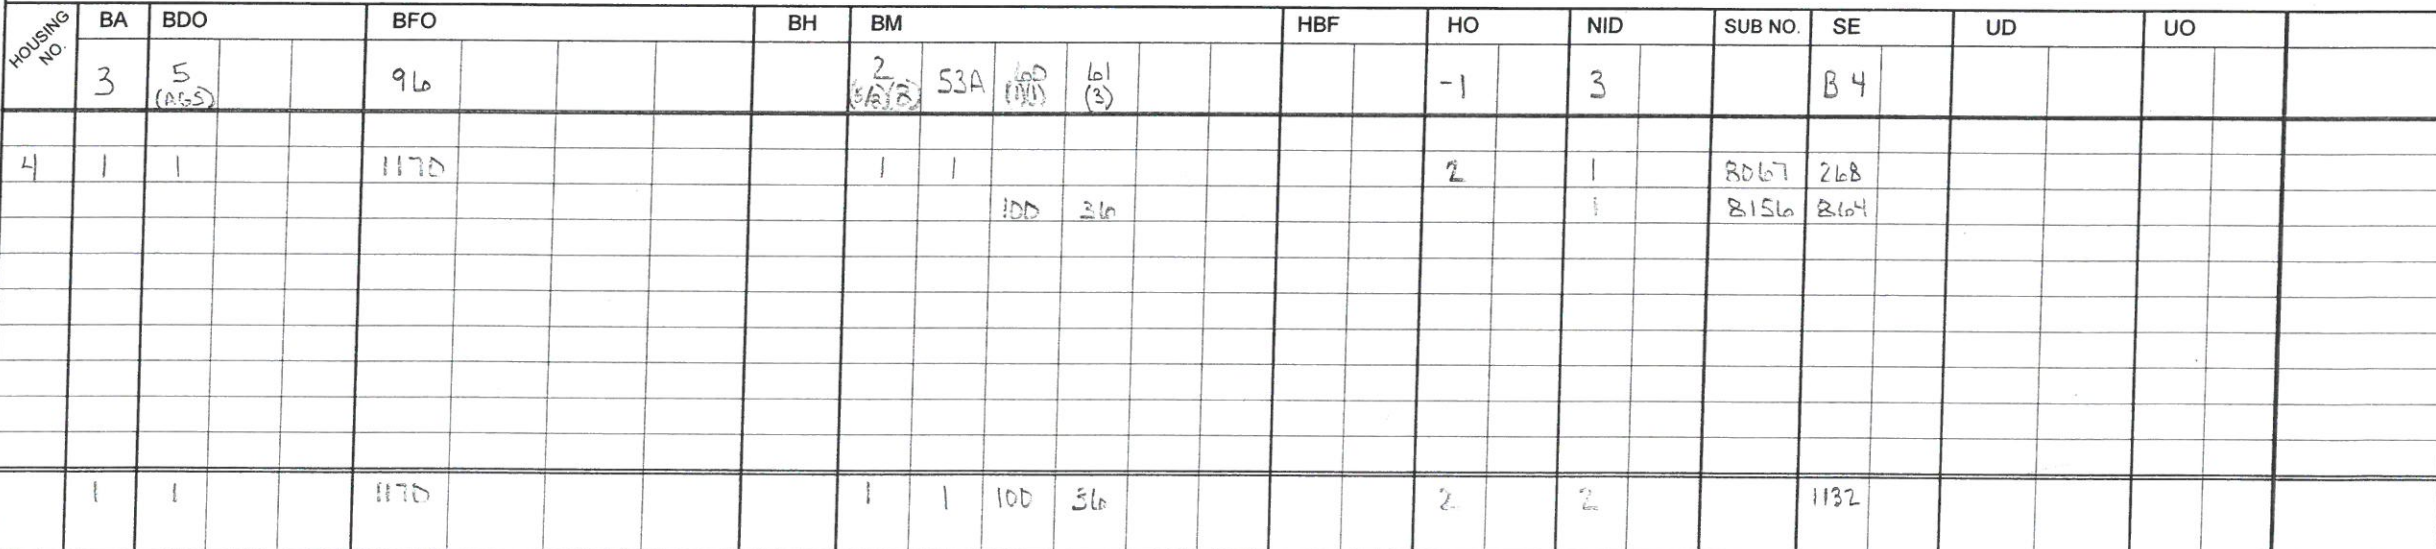



DISTANCE FROM C ROAD

SEE NOTATION

STAKED BY: RF

DATE: 3-10-2015

REV.

REV.

AS BUILT BY:

DATE:



PROJECT:

MN 537

EXCHANGE:

Randall

TOWNSHIP:

CLISHING

TWP

131

N

RNG

30

W

SEC.

29

32

CO.

Morrison

ROUTE:

COA7B

SHEET:


5

OF

SERVICE AREA:


Randall

TREES PLANTED

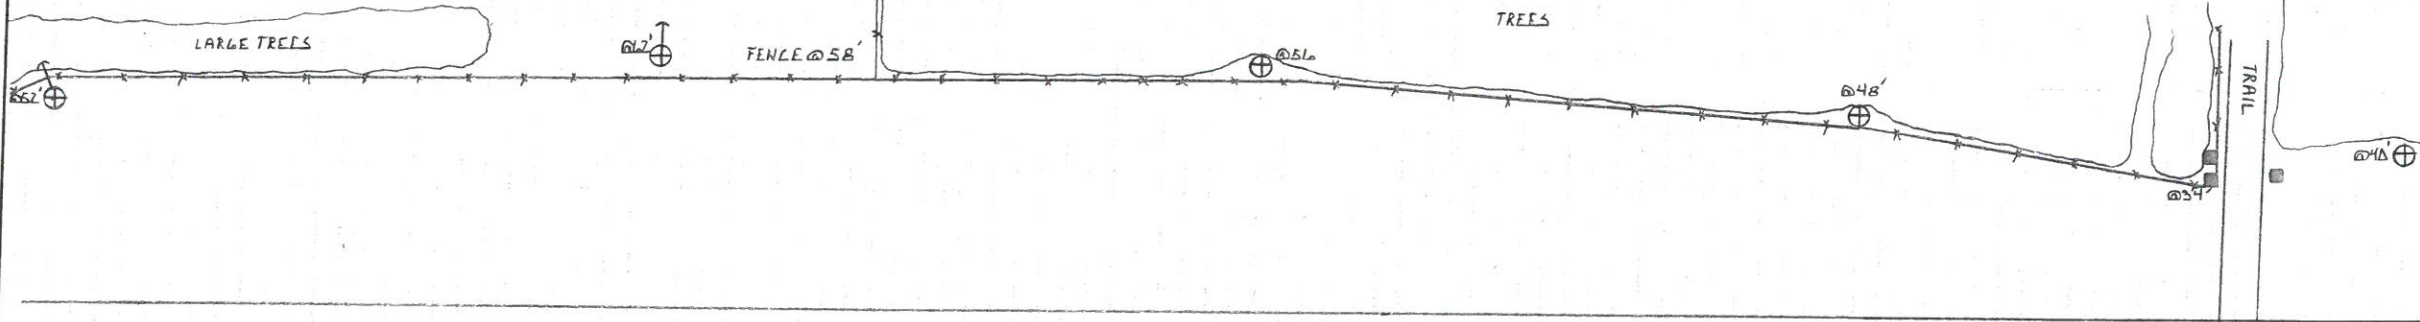

250TH ST.


EMERALD RD.

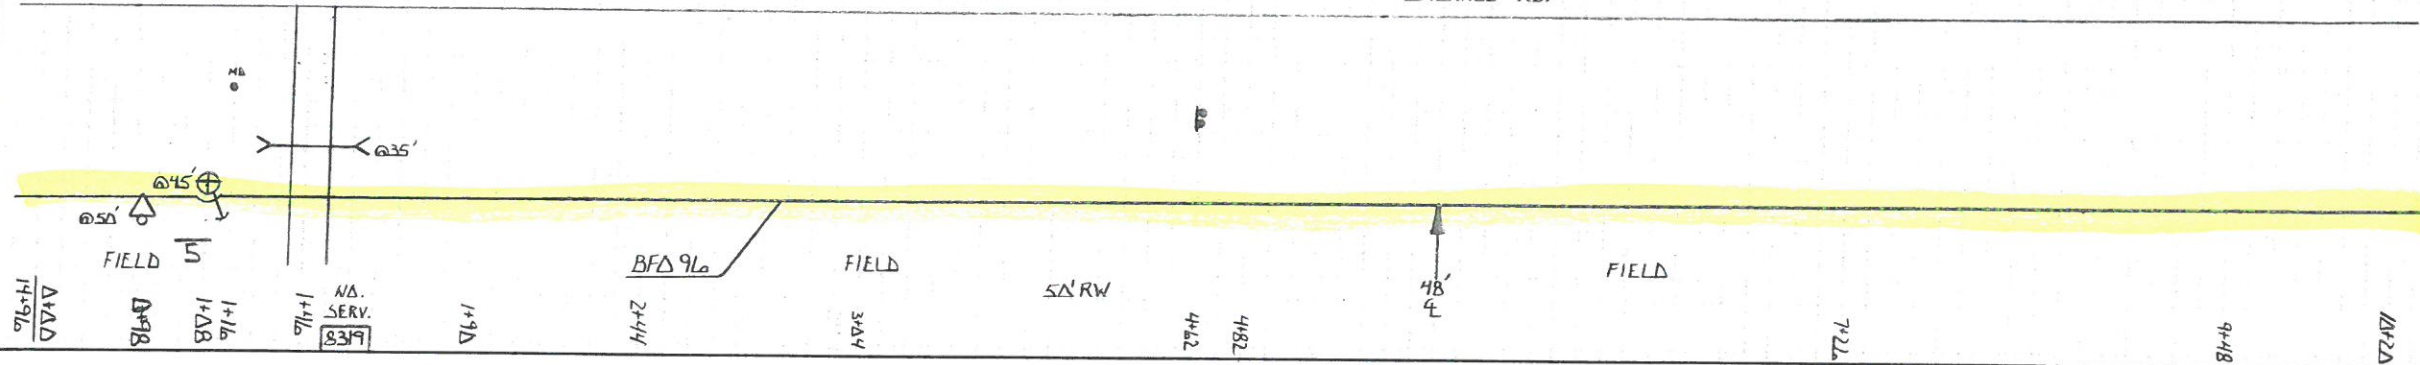

HOUSING NO.	BA	BDO	BFO	BH	BM	HB	HO	NID	SUB NO.	SE	UD	UO
3	5	(AGS)	96		2	(5/8) 53A	-1					
5	1	1	1206		1	1						
1	1		1206		1	1						




DISTANCE FROM C ROAD			TWP	131	N	ROUTE: COA7B			
SEE NOTATION			RNG	30	W				
STAKED BY: RF	DATE: 3-10-2015		PROJECT:	MN 537			SEC.	29	
REV.	REV.		EXCHANGE:	Randall			SHEET: 6	OF	
AS BUILT BY:		DATE:	TOWNSHIP:	LUSHING		CO.	Morrison	SERVICE AREA:	Randall

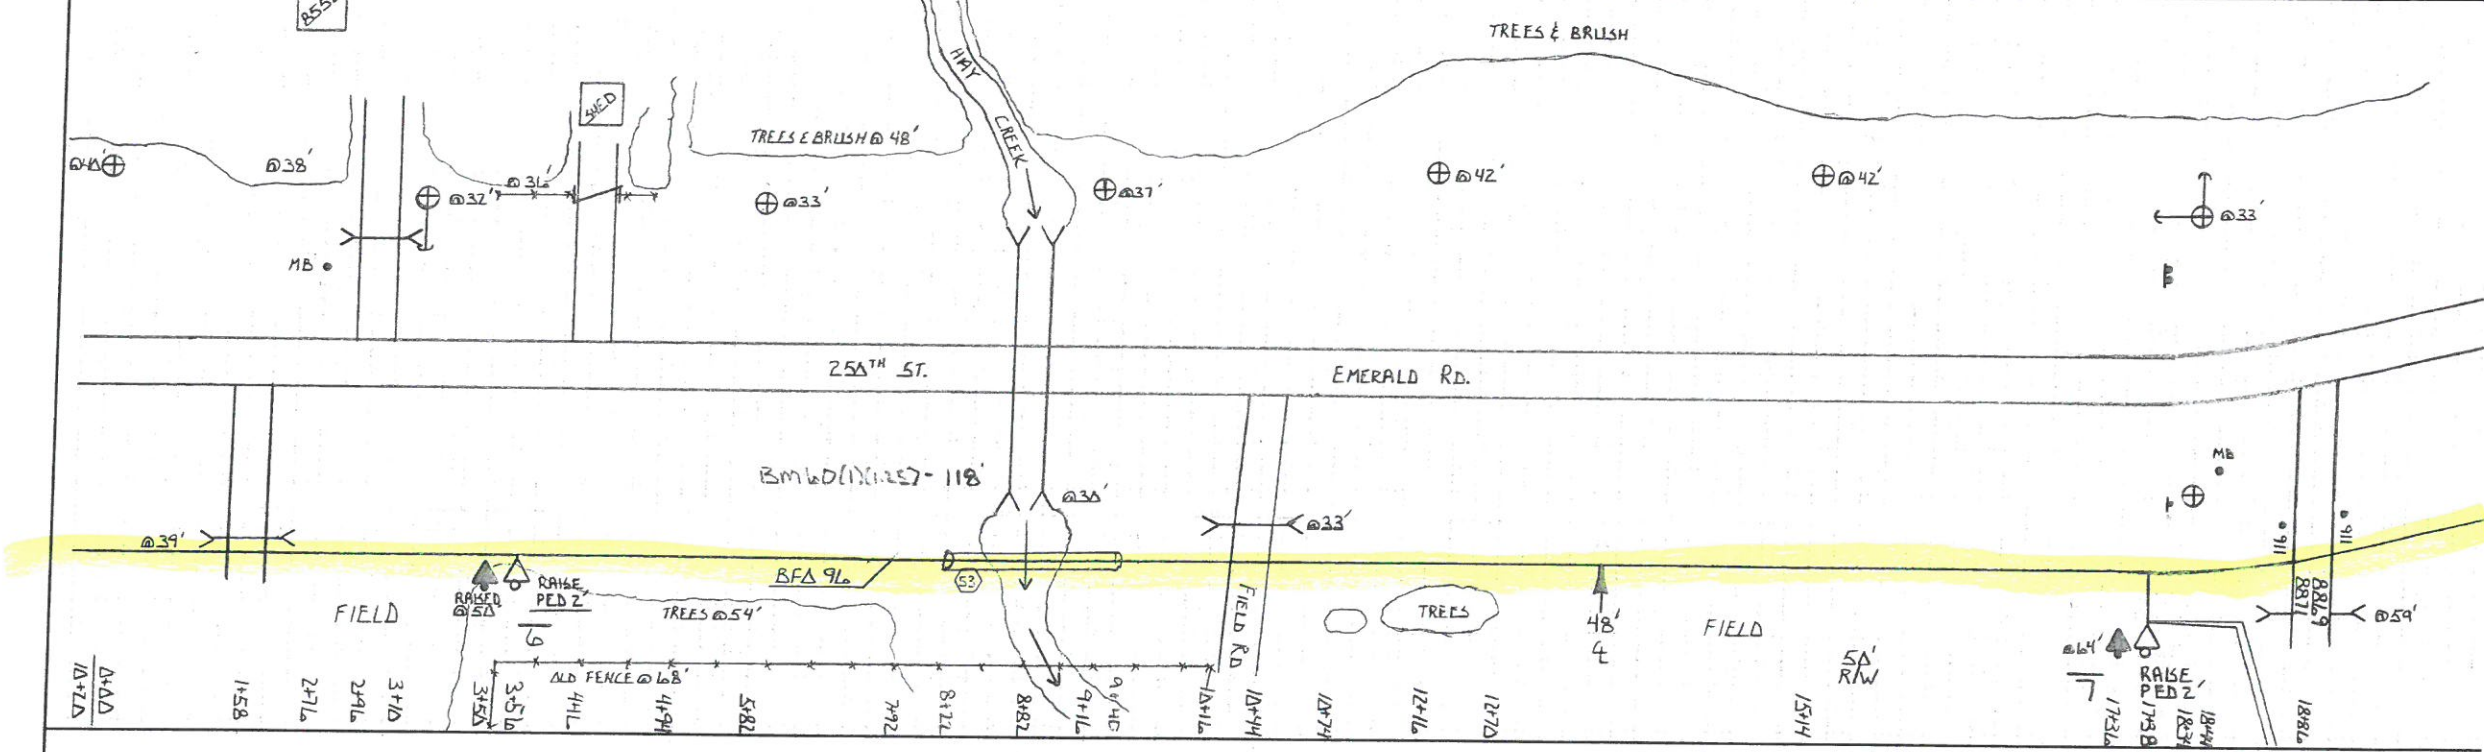

HOUSING NO.	BA	BDO	BFO	BH	BM	HB	HO	NID	SUB NO.	SE	UD	UO
	4	5 (AS)	96		2 (5/8) R 53 53A 60 (11257) 81		-1	3		B 4		
6	1	1	1362		1							
7	1	1	1488		1 1 1 118 1		2	1 1	8871 8869	556 822		
	2	2	2850		2 1 1 118 2		2	2		1378		

[illegible]

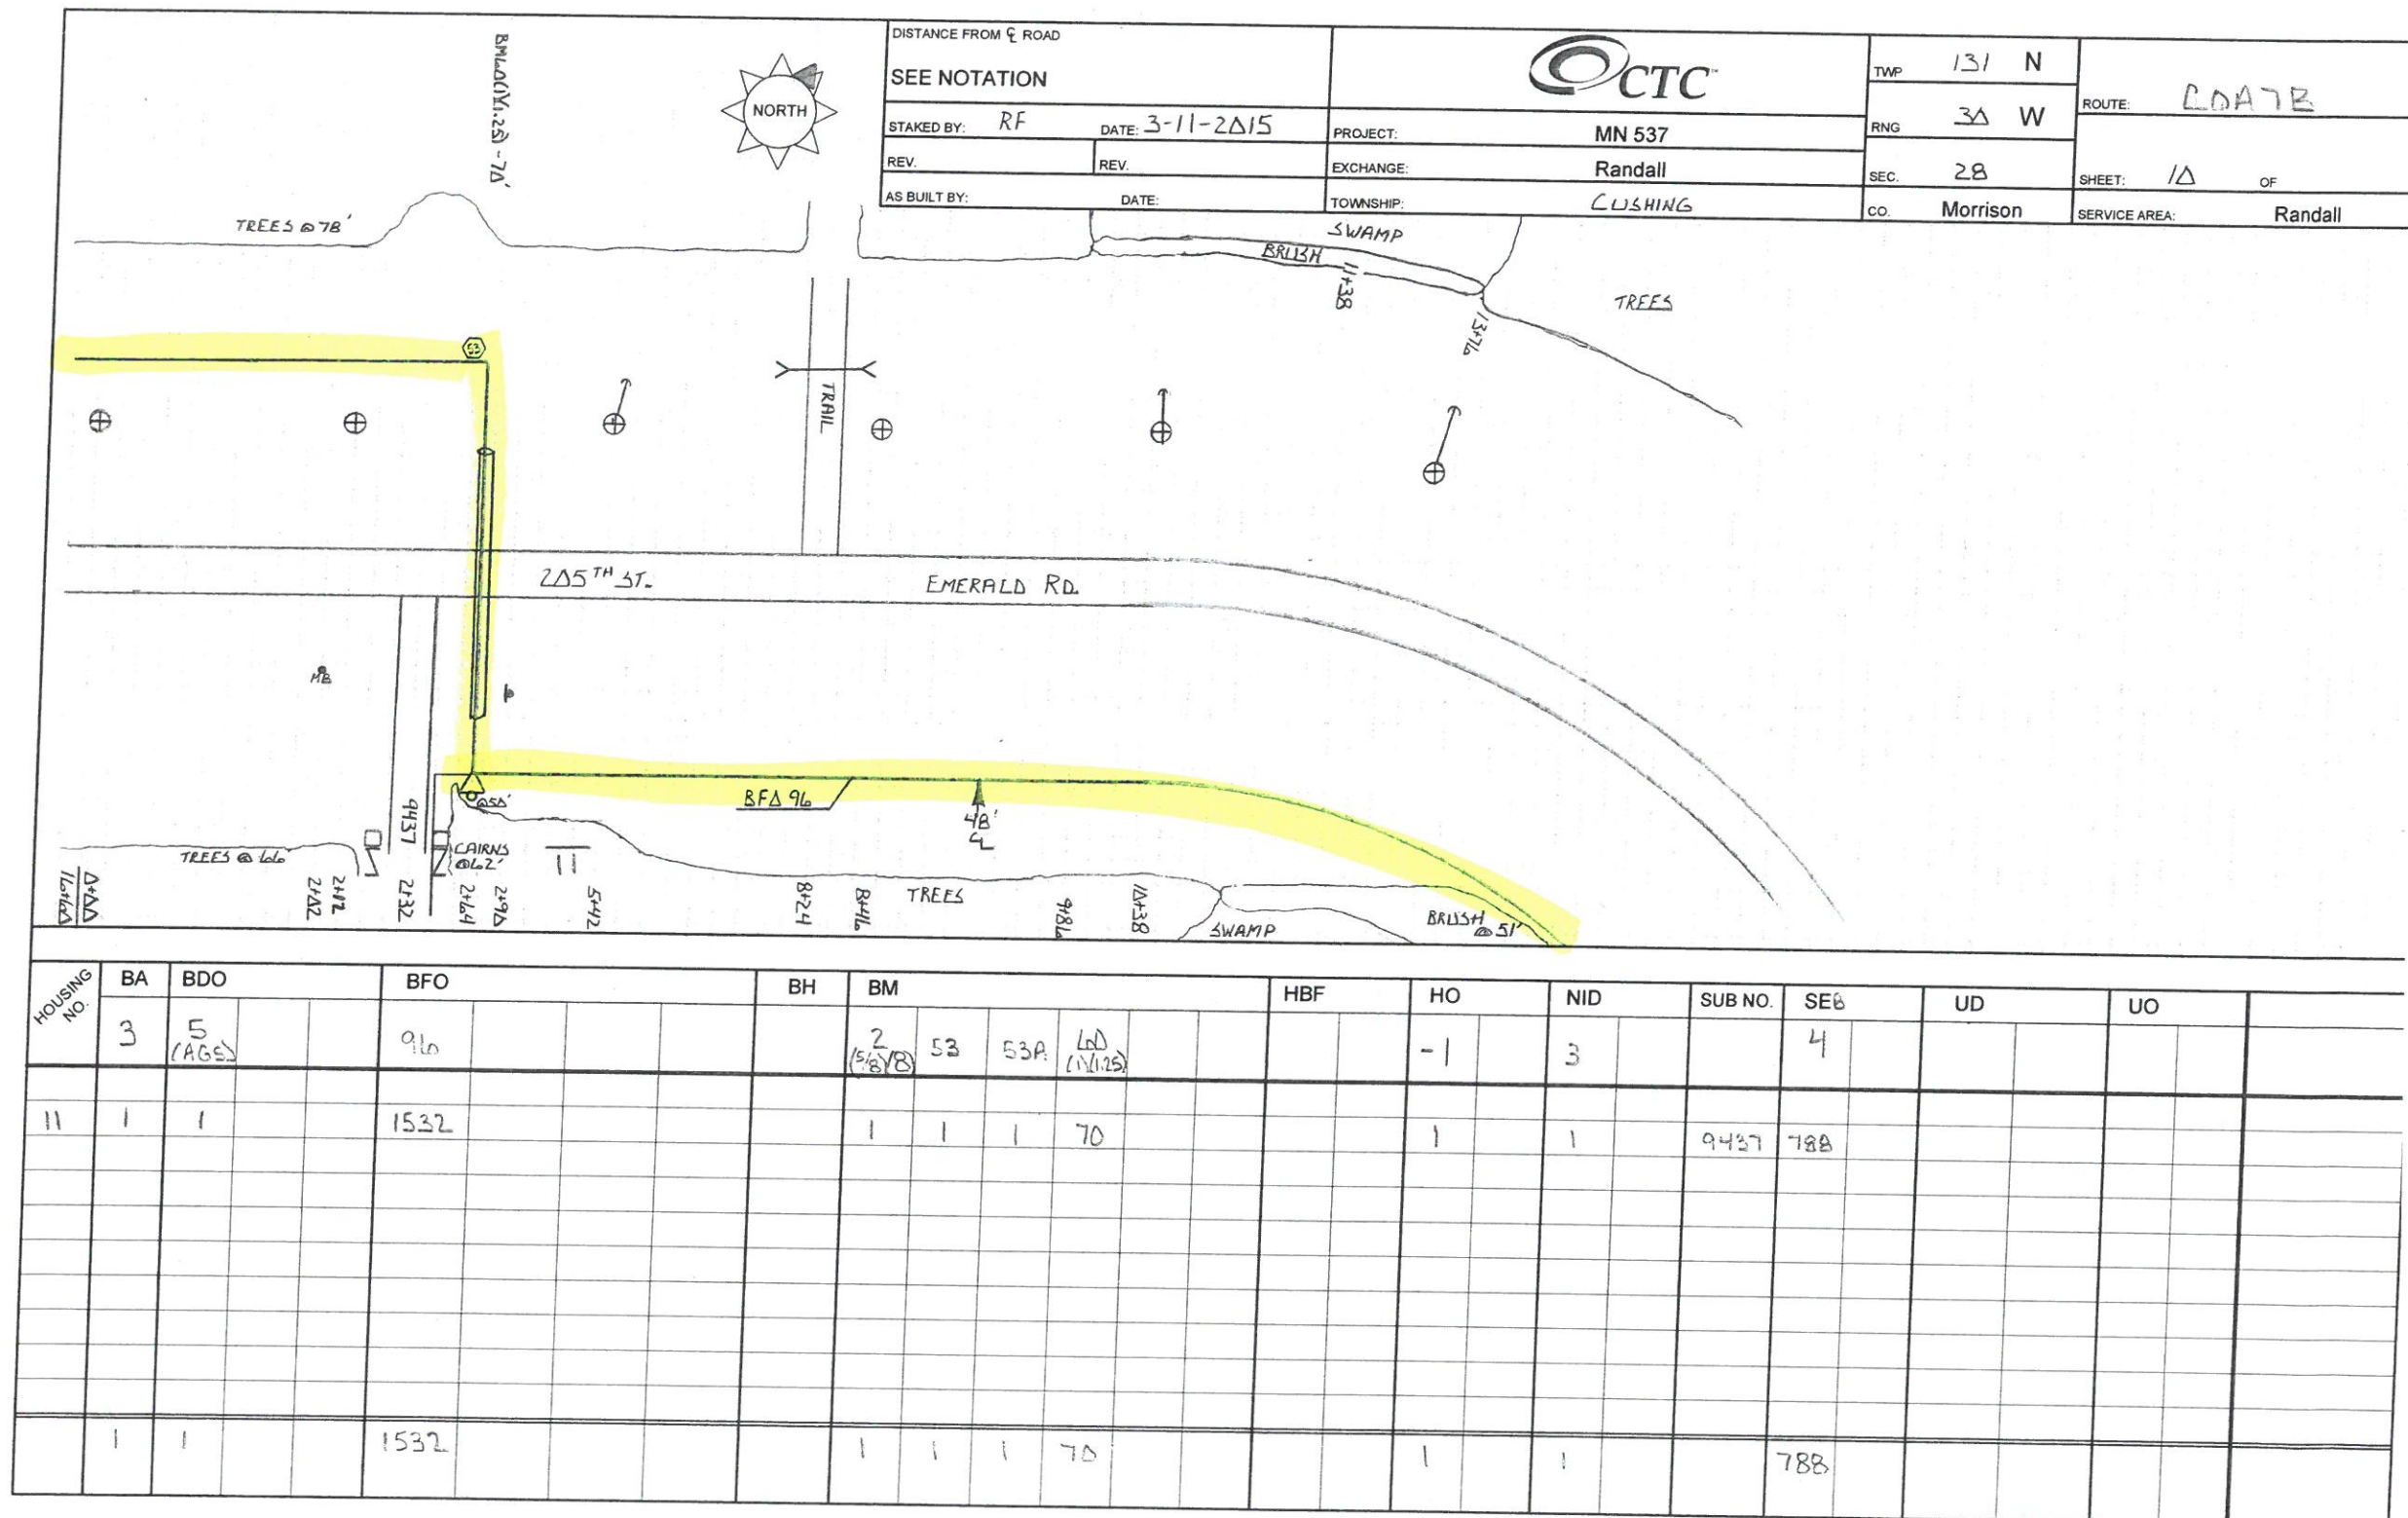



DISTANCE FROM C ROAD

SEE NOTATION

STAKED BY: RF

DATE: 3-11-2015

REV.

REV.

AS BUILT BY:

DATE:



PROJECT:

MN 537

EXCHANGE:

Randall

TOWNSHIP:

CLISHING

TWP 131 N

RNG 30 W


SEC. 28

CO. Morrison

ROUTE: COA7B

SHEET: 13 OF

SERVICE AREA: Randall

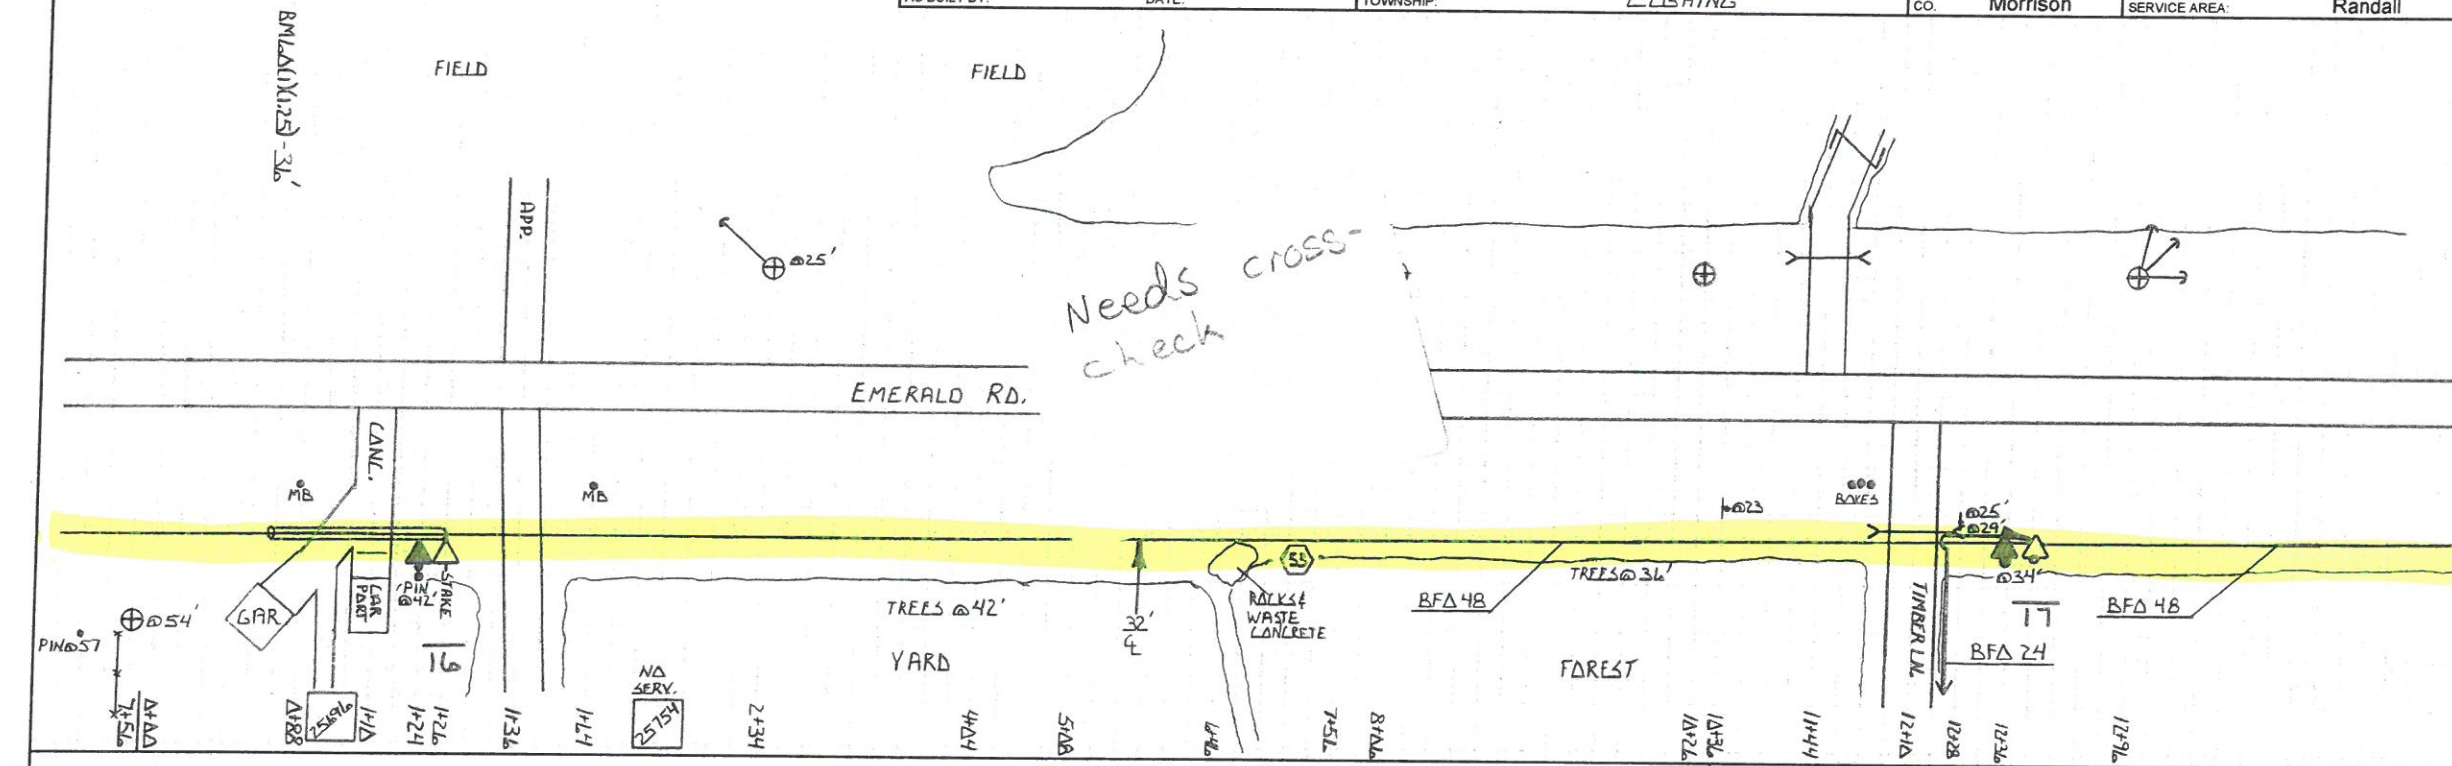

HOUSING NO.	BA	BDO	BFO	BH	BM	HBF	HO	NID	SUB NO.	SE	UD	UO
3	3	5 (AGE)	5 (GE)	48	2 (5A) 8 52 60 (1/125) 61 (3)		-1			134		
16			1	320	1		1		25696			
17	1	1	1188		1 1		9					
	1	1	1	1508	2 1 666		10					

[illegible]