


From	To	PType	Units	Feet	Remarks
(E/18)	E/19	BDX	BFC 100-24	692	

As Built	
Consolidated Telephone Company	
Name:	RST 3-2 E-Rte Sheet 4 of 5
WO:	2013 - Randall
Exch:	Randall
Route:	E 1 D
ROW:	Varies
State:	Minnesota
County:	Morrison
Range:	31W
Twsp:	131N Section: 21
Township: Cushing W	
Staked By:	EMD Date: 6-11-13
Revised By:	Date:
Revised By:	Date:
Revised By:	Date:
As-Built By:	EMD Date: 12-10-13

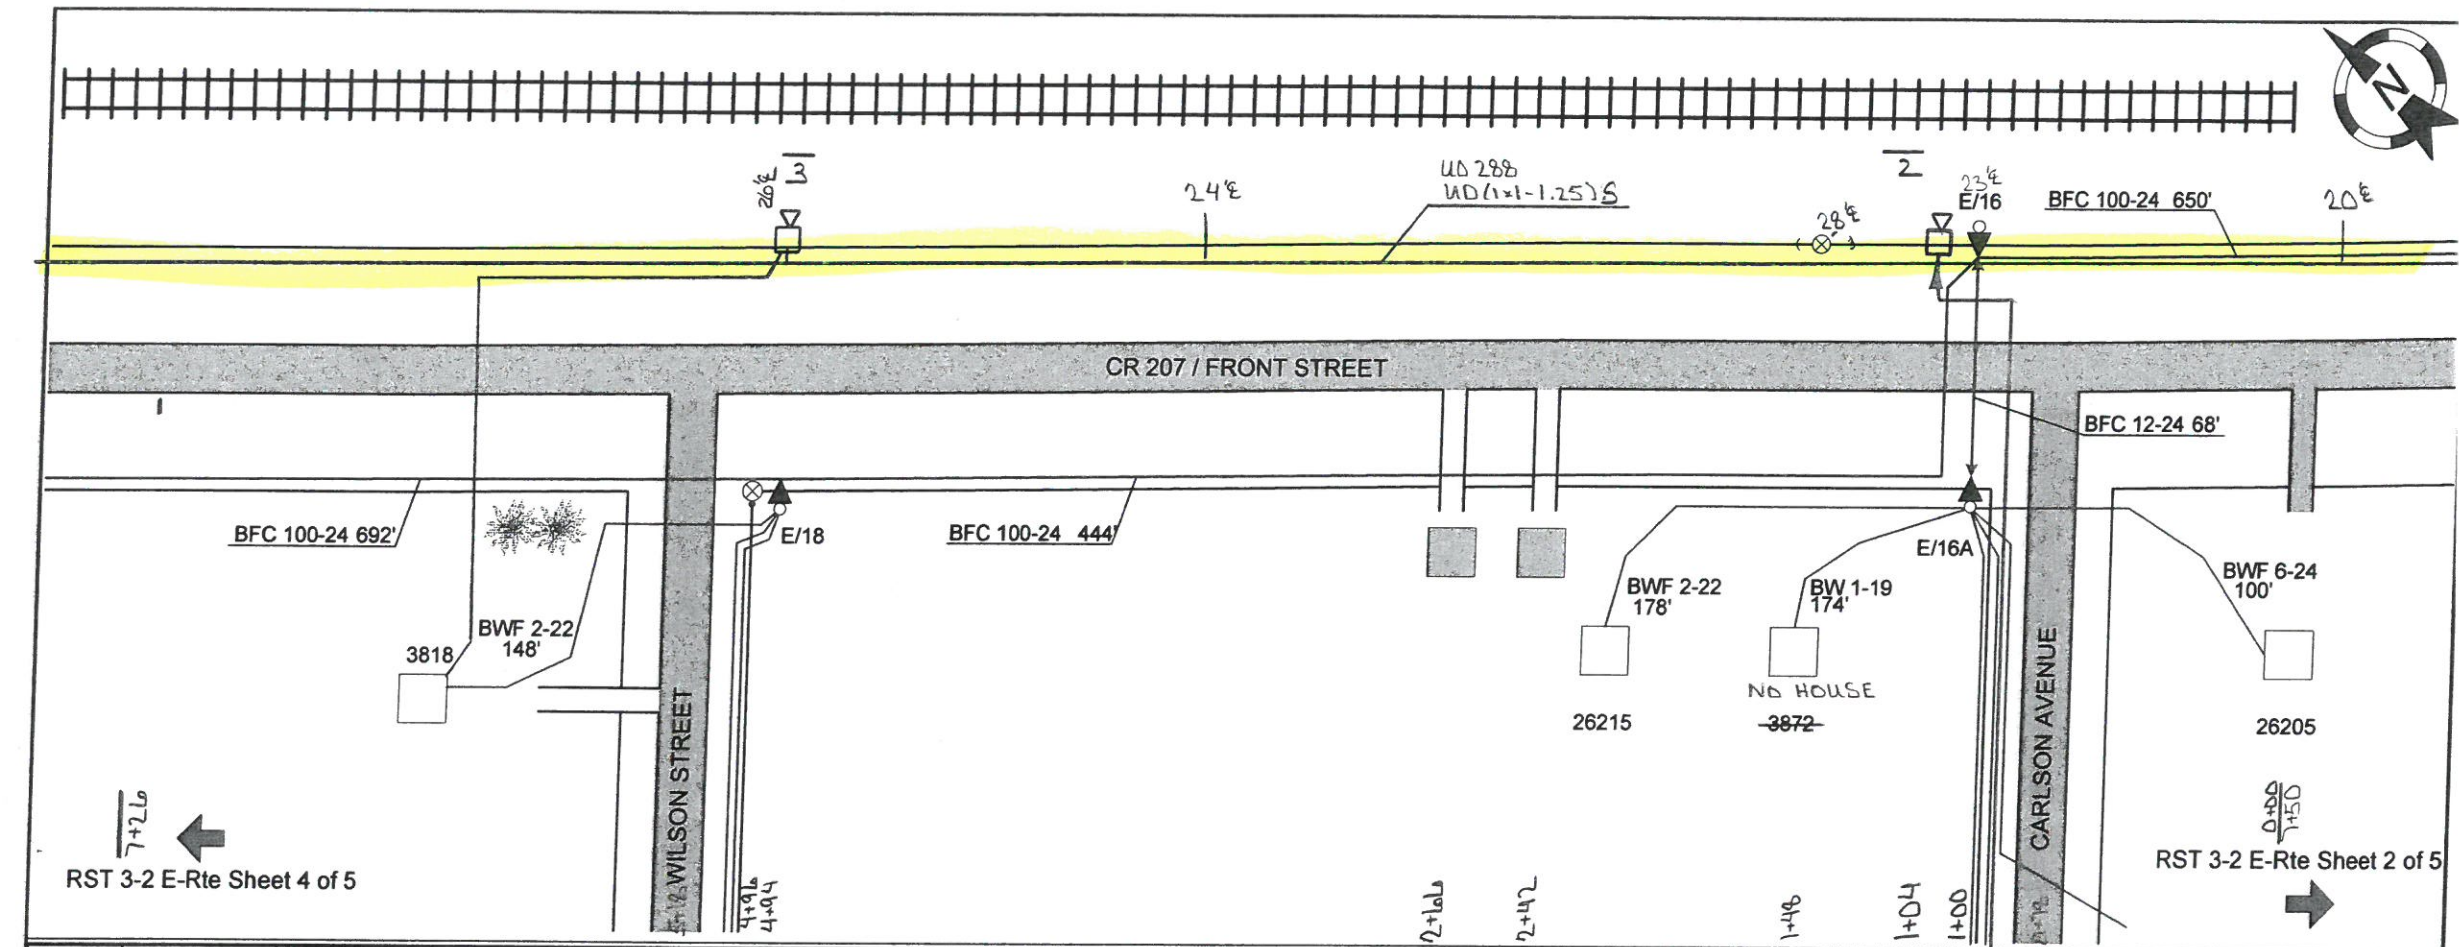

RST 3-2 E-Rte Sheet 4 of 5

RST 3-2 E-Rte Sheet 2 of 5

From	To	PType	Units	Feet	Remarks
E/16	E/18	BD3A	BFC 100-24	444	
E/16	E/16A	BDX	BFC 12-24	68	
(E/15A)	E/16	BDX	BFC 100-24	650	
E/16A	26205 E-16A/F		BWF 6-24	100	
E/16A	26215 E-16A/A		BWF 2-22	178	
E/16A	3872 E-16A/B		BW 1-19	174	
E/18	3818 E-18/A		BWF 2-22	148	

CTC

As Built
Consolidated Telephone Company

Name:

RST 3-2 E-Rte Sheet 3 of 5

WO:

2013 - Randall

Exch:

Randall

Route:

E- 1D

ROW:

Varies

State:

Minnesota

County:

Morrison

Range:

31W

Twsp:

131N Section: 21

Township:

Cushing

Staked By:

EMD

Date:

6-11-13

Revised By:

Date:

Revised By:

Date:

Revised By:


Date:


As-Built By:

EMD

Date:

12-10-13

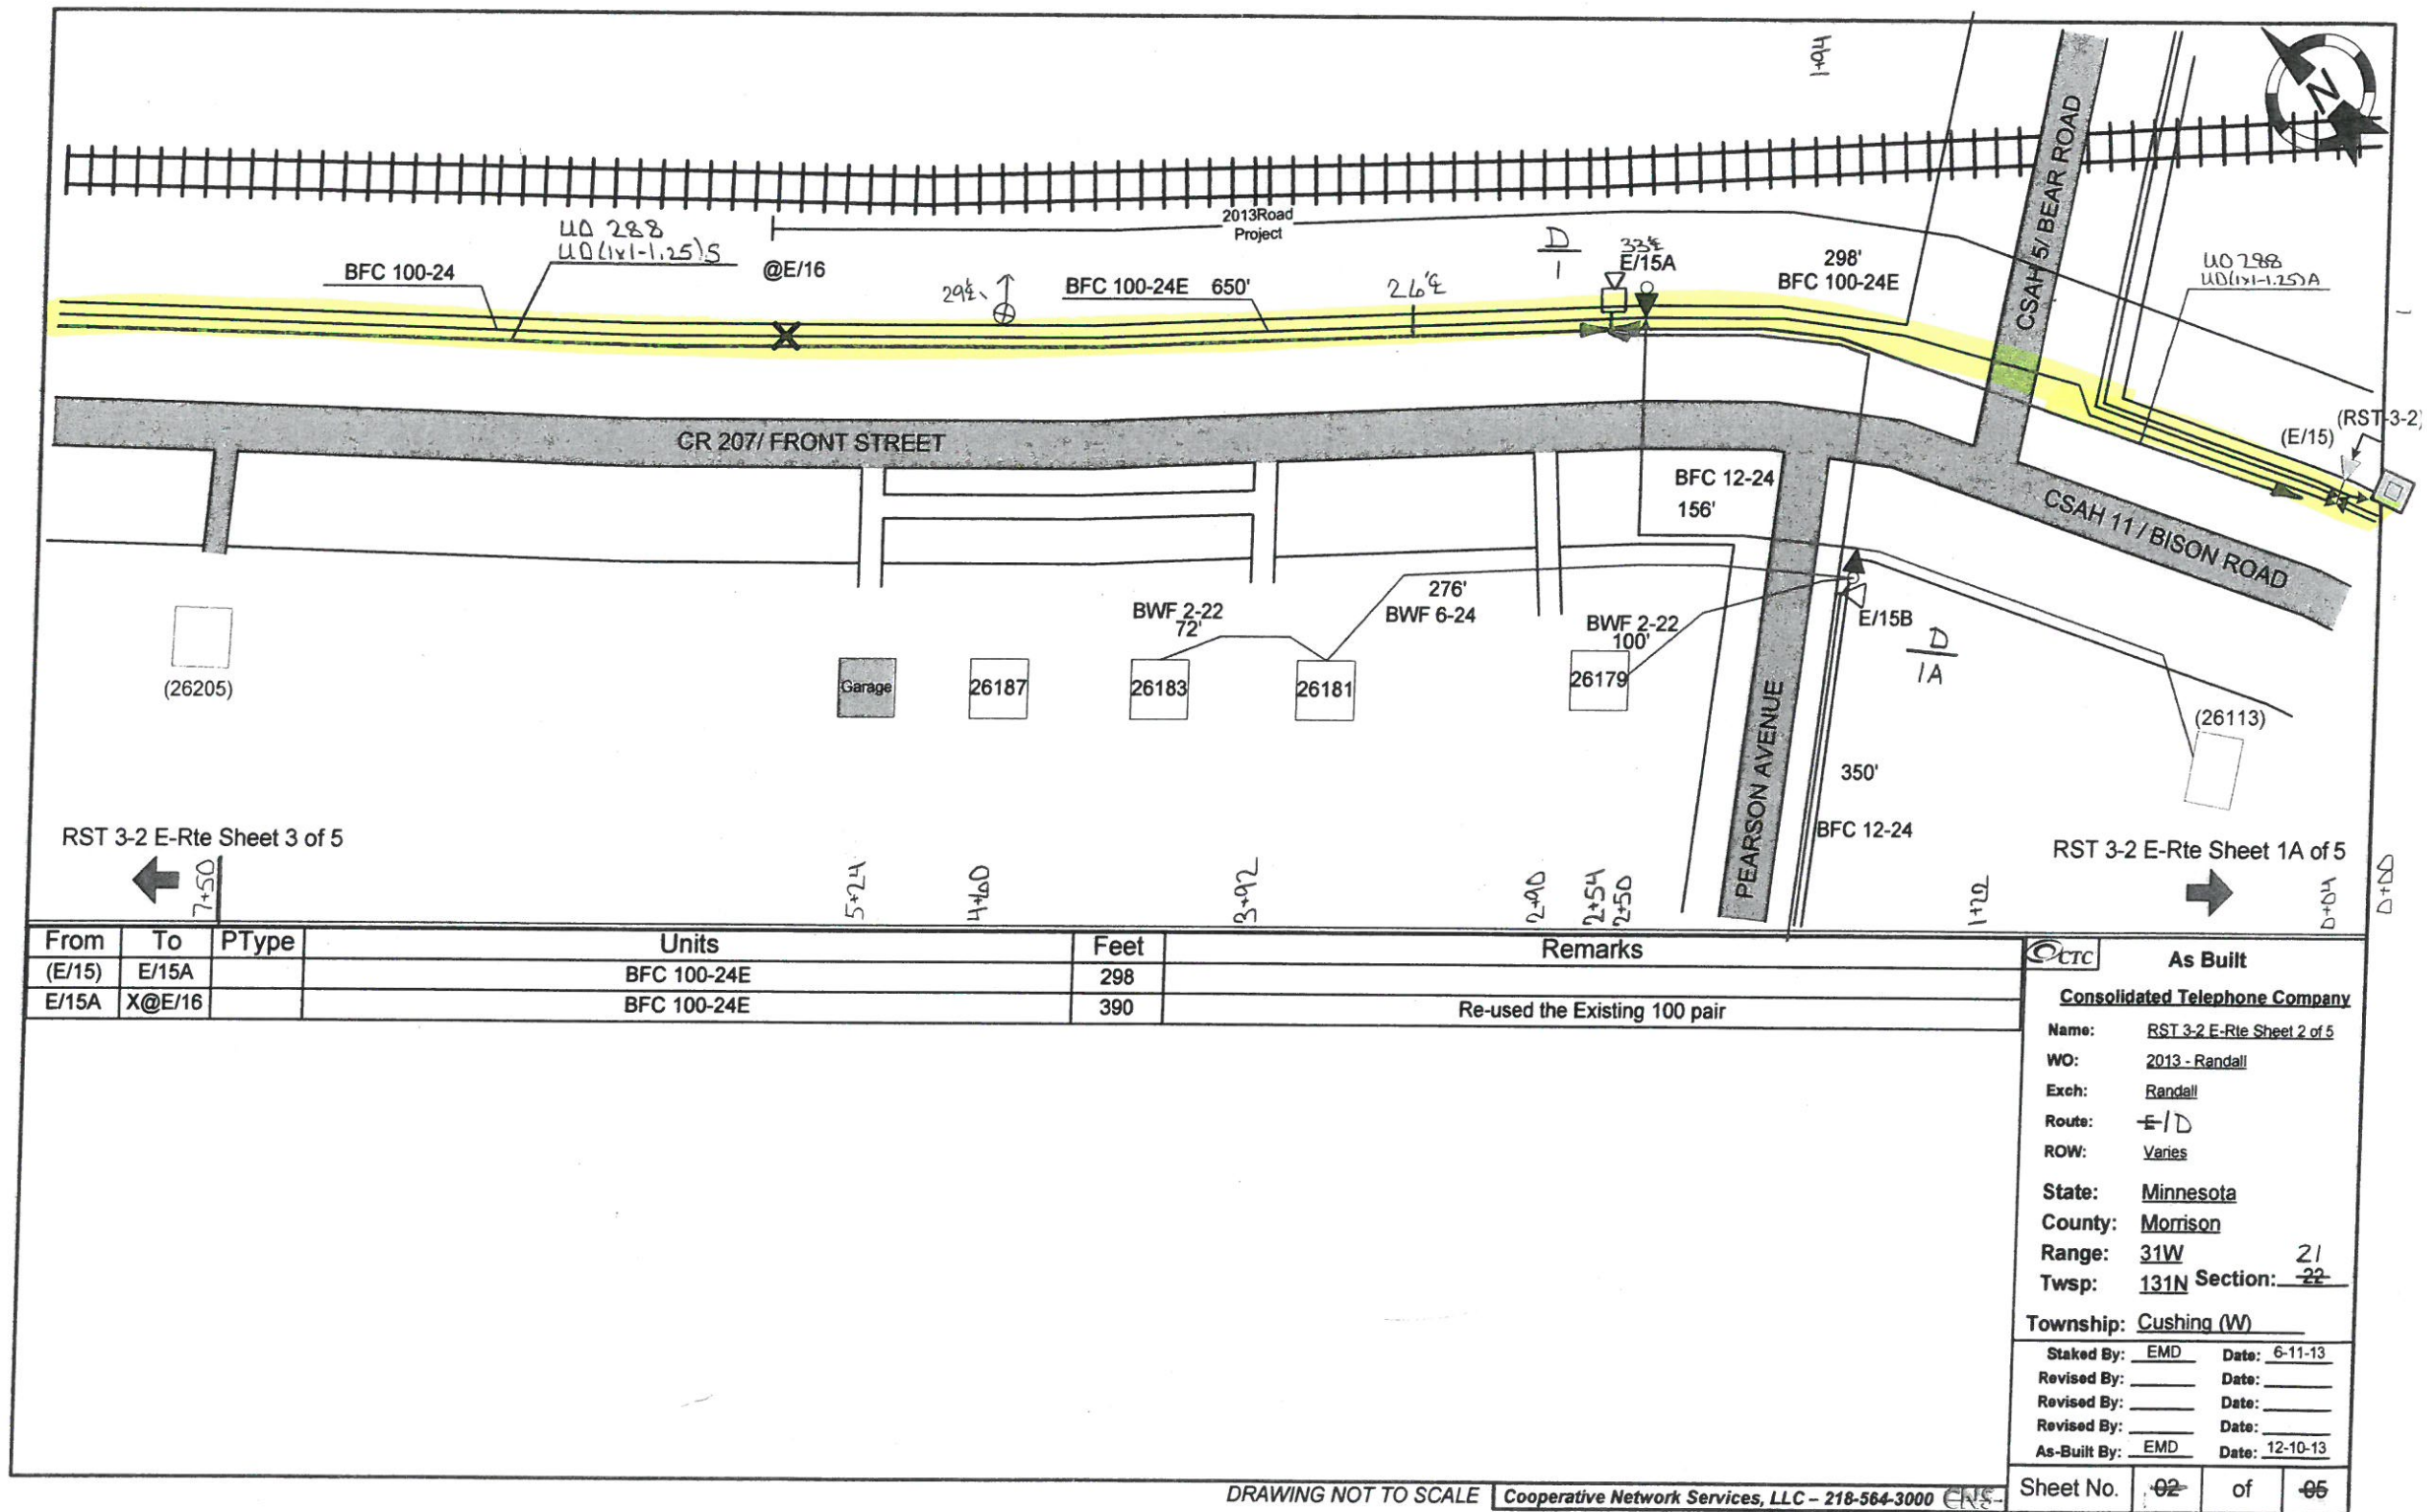

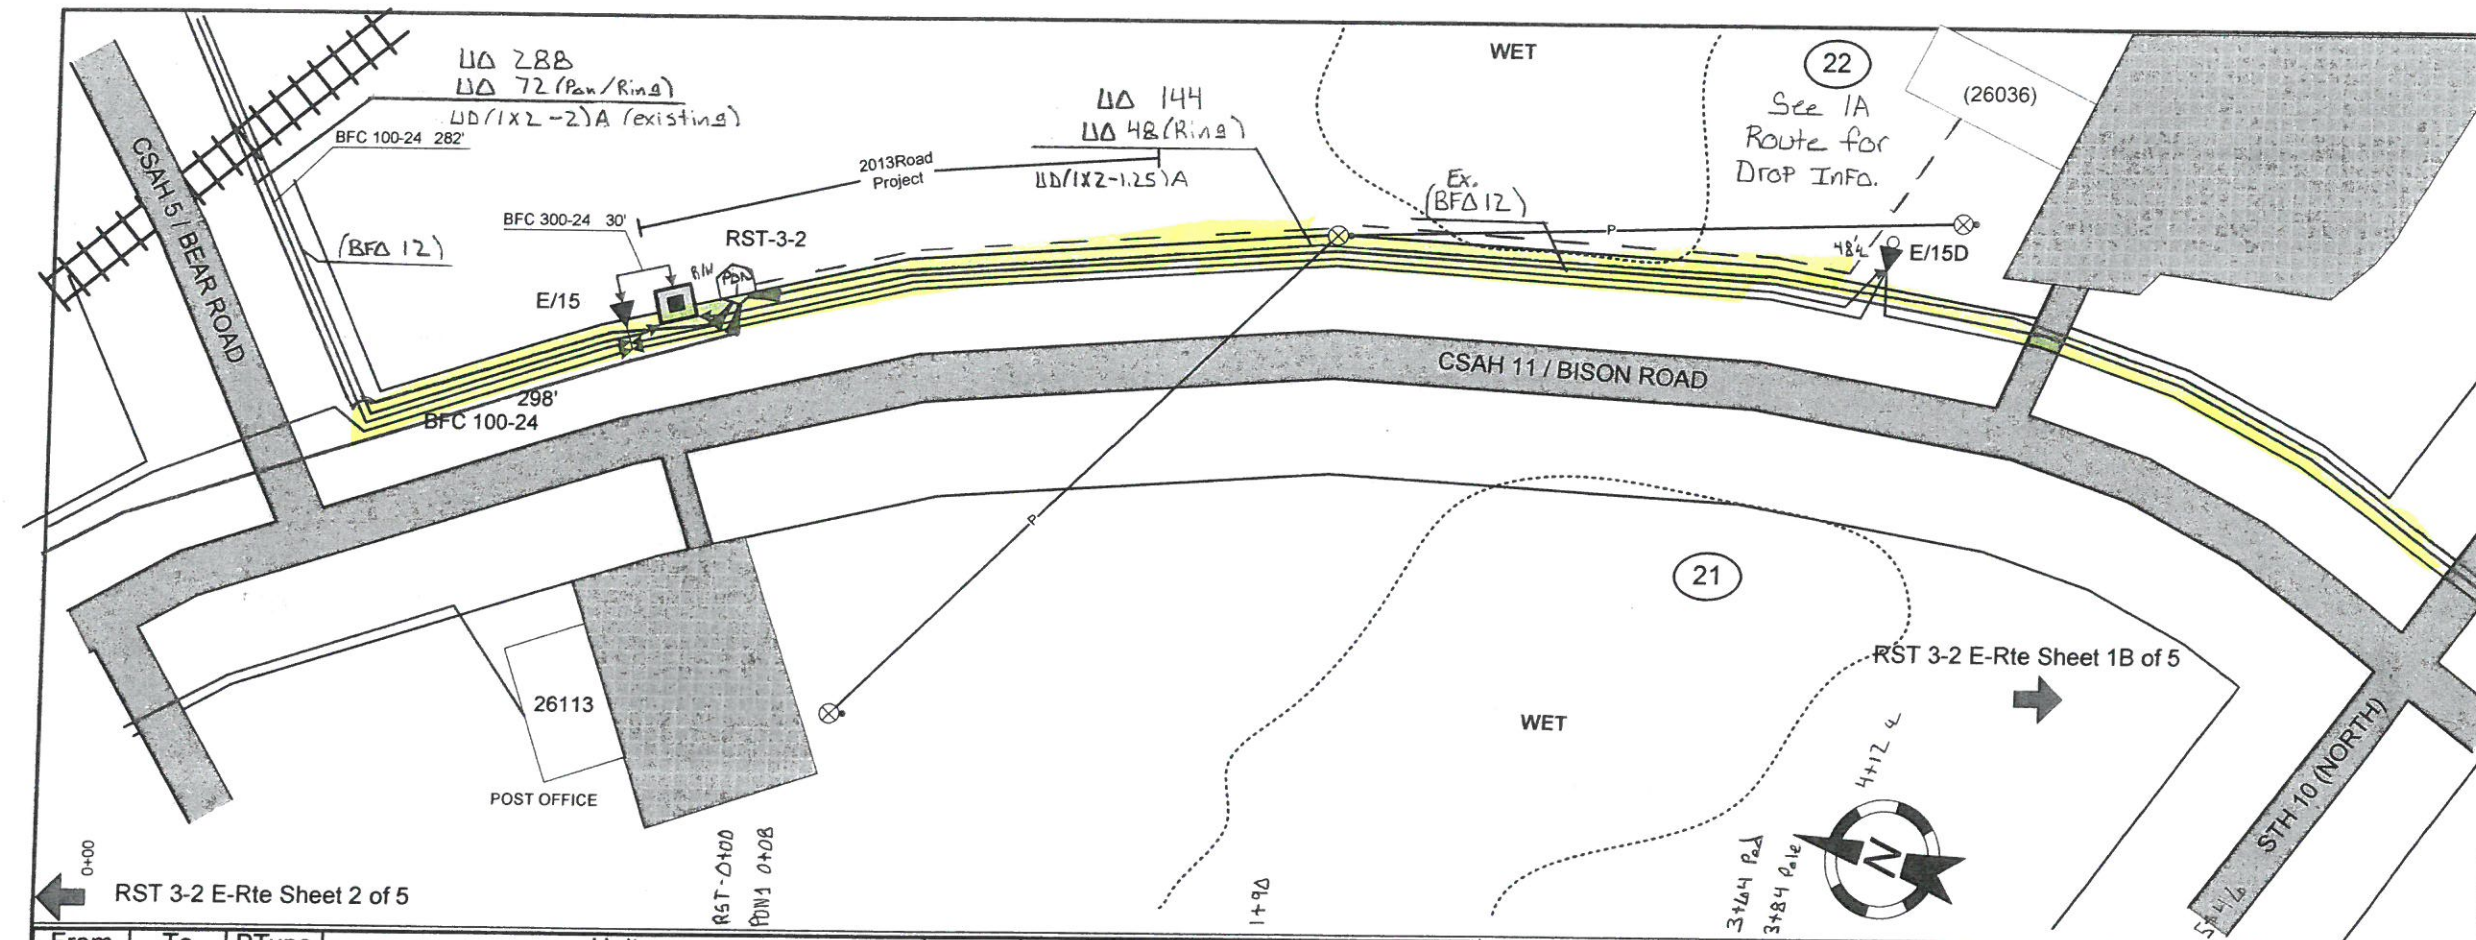

From	To	PType	Units	Feet	BM	Remarks
	RST-3-2				Operator 9	Exposing 100pr 8' deep in the road
	RST-3-2				Operator 48	Exposing 100Pr, Fiber And Power for Road Project

No Units See Sheet 2A

As Built	
Consolidated Telephone Company	
Name:	RST 3-2 E-Rte Sheet 1A of 5
WO:	2013 - Randall
Exch:	Randall
Route:	✓
ROW:	50'
State:	Minnesota
County:	Morrison
Range:	31W
Twsp:	131N Section: 21
Township: Cushing W	
Staked By:	EMD Date: 6-11-13
Revised By:	Date:
Revised By:	Date:
Revised By:	Date:
As-Built By:	EMD Date: 12-10-13