


CONTRACTOR REDLINE
 PIERZ, MN
 FG01015
 MAINTENANCE-COAX PARK AVE
 604 PARK AVE SE
 5130U4899
 PZ01

INSTALL A TOTAL OF 474' OF .625
 COAX. OF THAT TOTAL 215' WILL BE
 AERIAL AND THE REMAINING 259' WILL
 BE IN 1 1/4" DUCT. ALSO SET NEW TAP PED
 AND BRING EXISTING COAX IN FOR A SPLICE BLOCK.

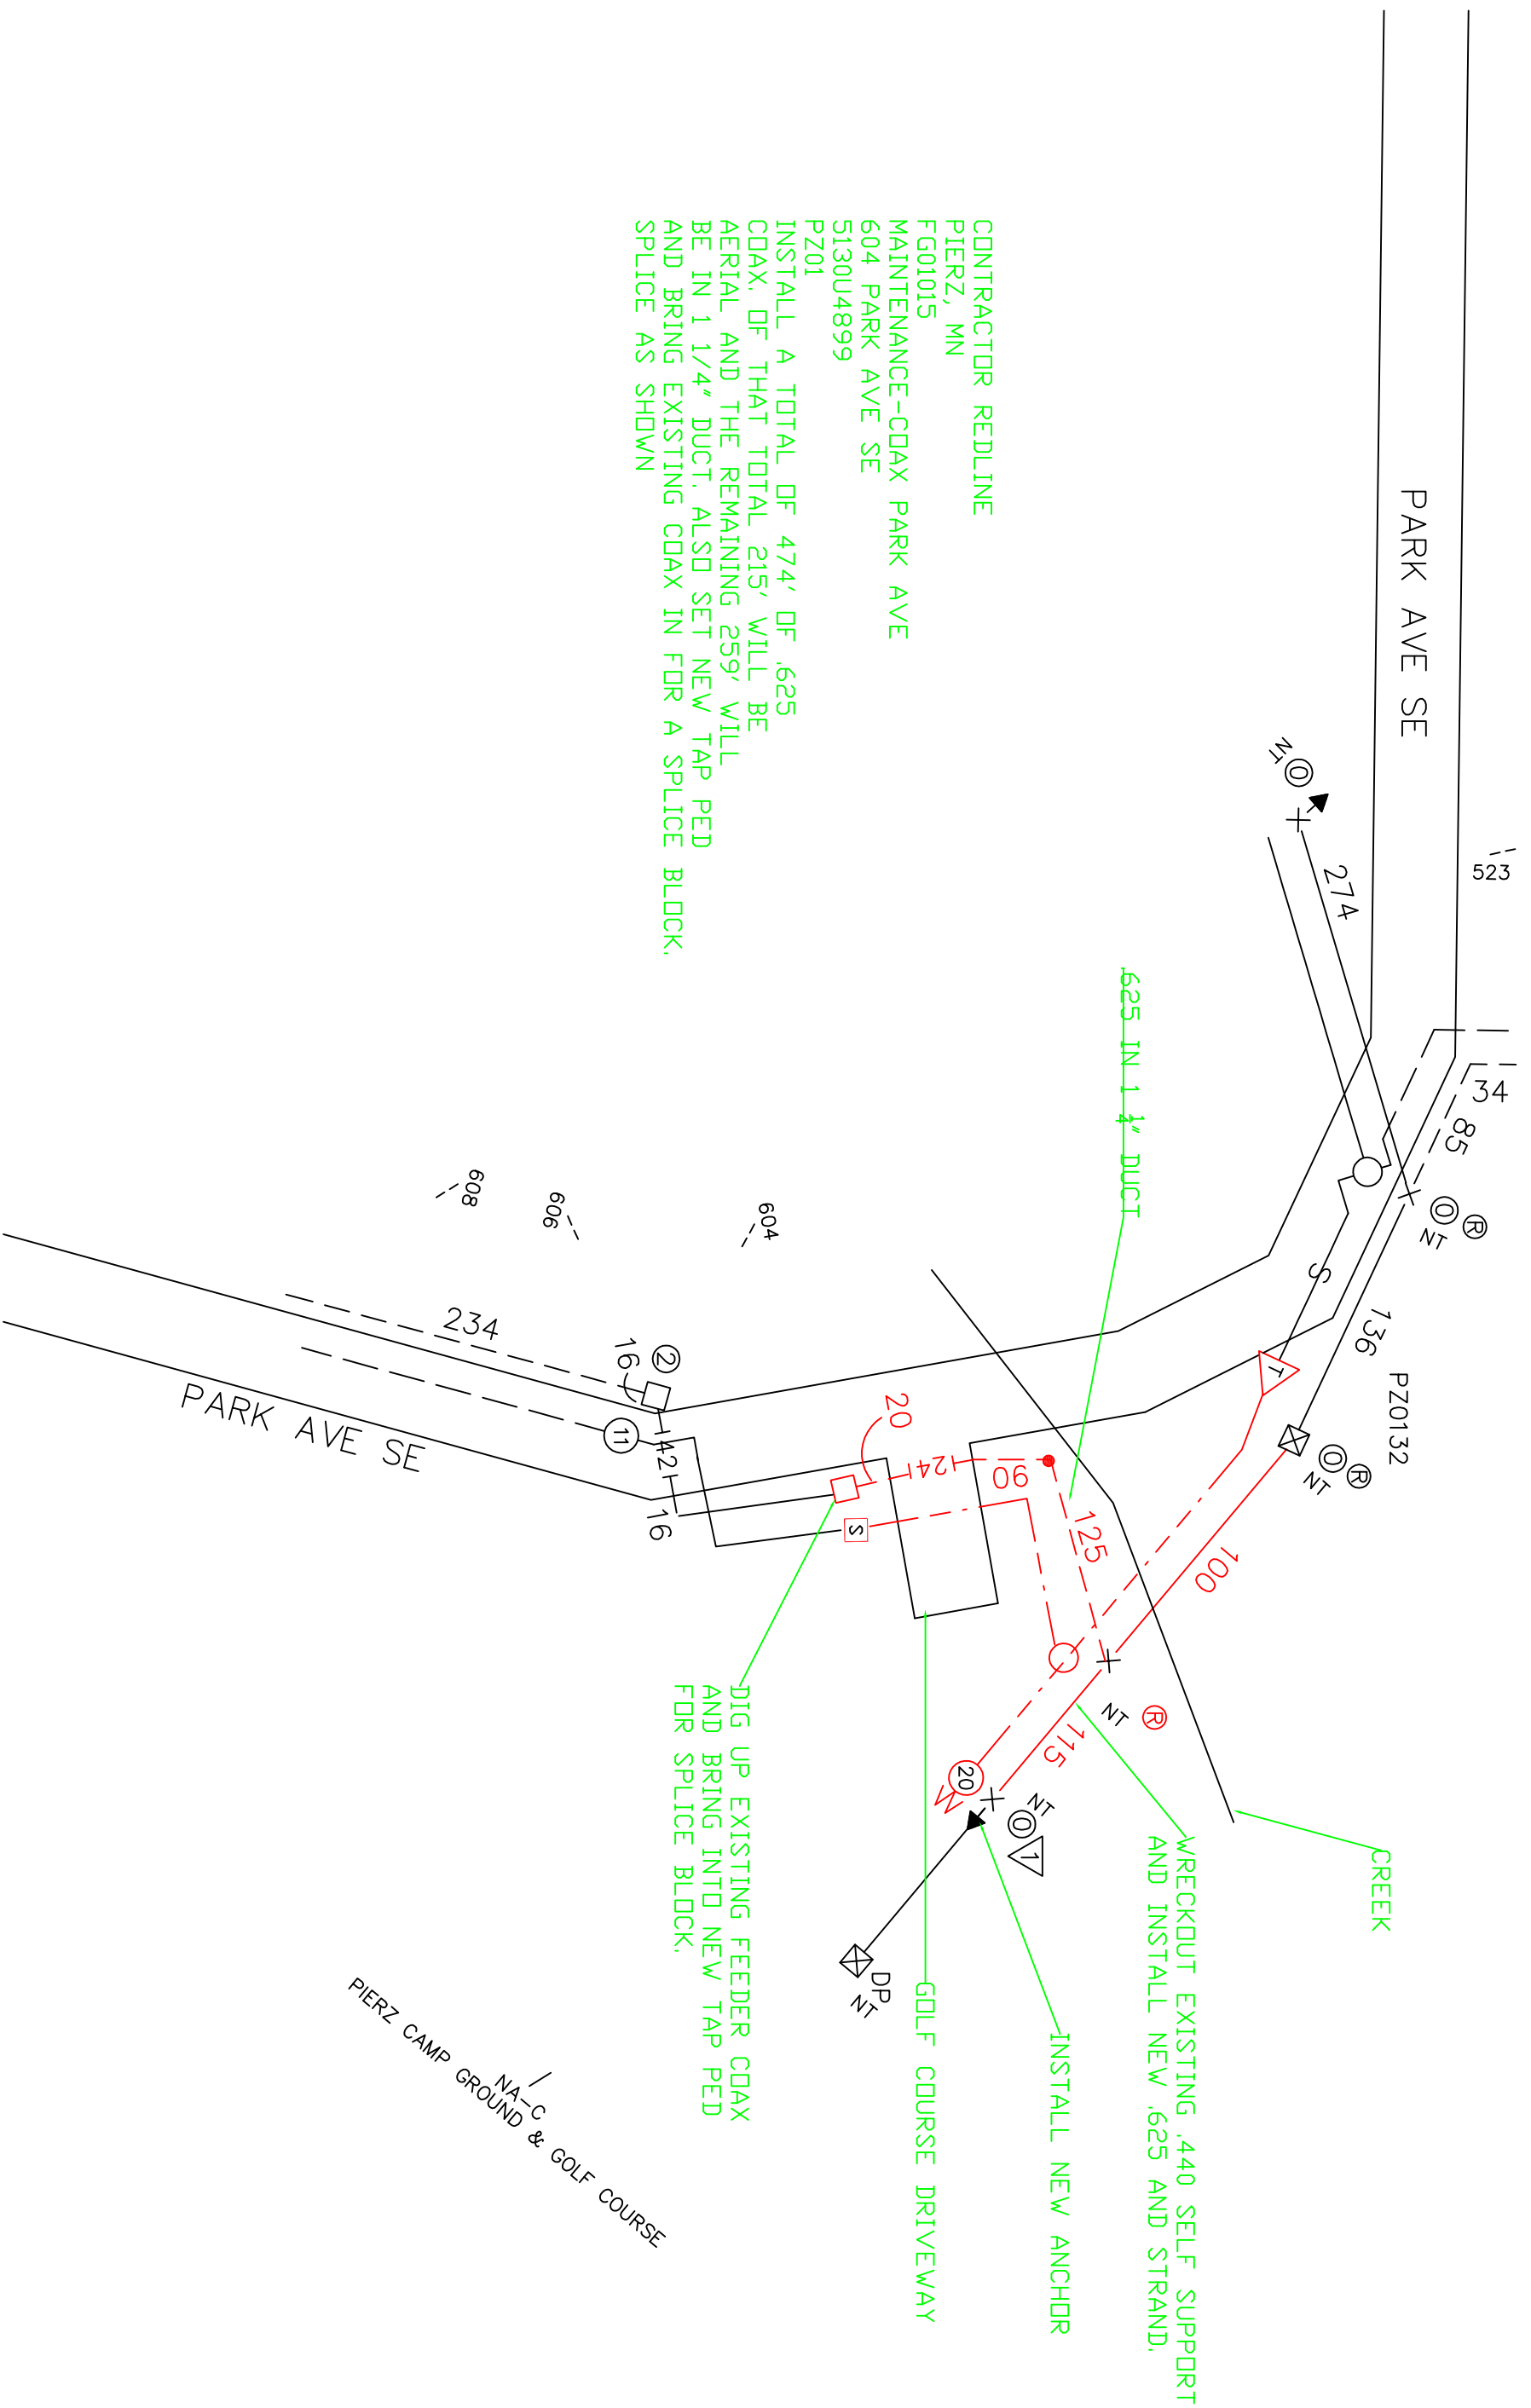

PIERZ CAMP GROUND & GOLF COURSE