

# STAKING SHEET - UNDERGROUND/OVERHEAD


COUNTY Morrison  
 TWP. 128 RG. 29 SEC. 20  
 MAP NO. 90- Swan River  
 SUBDIVISION \_\_\_\_\_  
 BLOCK \_\_\_\_\_ LOT \_\_\_\_\_  
 SERVICE TYPE Residential  
 AMPS 200 VOLTAGE 120/240

STAKED BY Josh DATE 10-15-15  
 CHECKED BY \_\_\_\_\_ DATE \_\_\_\_\_  
**TAIL GATE DISCUSSION**  
 MEETING DATE: \_\_\_\_\_  
 CREW CHIEF: \_\_\_\_\_

NEW CONSTRUCTION  
 SYSTEM IMPROVEMENT  
 REPLACEMENT  
 RETIREMENT  
101 RUS CODE

W.O. NO. 2015 - 0473  
 RETIREMENT W.O. NO. \_\_\_\_\_  
 SHEET NO. 1 OF NO. 2  
 NAME: Tom + Marjorie Bzdok  
 LOC. NO. 090 20-005  
 SUB. 20- Sobieski FD. 2 PH. B  
 ACCT. 12308300 GRP. \_\_\_\_\_  
 PHONE 237-4606 444-7898

PRIMARY WIRE: SIZE \_\_\_\_\_ TYPE: \_\_\_\_\_ RULING SPAN \_\_\_\_\_


POLE NO.	U.R.D. UNIT NO.	SPAN	POLES		PRI-UNIT	MISC.	TRANS.		GROUND	GUYING				SECONDARY O.H.		SECONDARY URD		SEC. WIRE SIZE	METER TYPE	MISC. & REMARKS
			H.&C.	O.H./URD			"G"	"UG"		GR.	NO.	UNIT "E"	LEAD LNTH	ANCHOR		E3-10 No.	SPAN			
Ex 1			40-5	AIP					11											
ADD				A5							1-25	7'		1-3						
2		125	40-5	A5, UA2-2	Reduced Tension				11		1-25	7'		1-3						
	A	6/10		UM1-4, UM1e-1-2, UM1e-34							7-25	48-1					(2) UT2-4, UT26			
	X								6-6							25	UM8	4/0	30A	200A

Address: Greenwood Dr wait for customer to call to install

	LINE FT.	NO WIRE	TOTAL FT.	WIRE SIZE & TYPE
PRI. O.H.	<u>125</u>	<u>2</u>	<u>250</u>	<u>#4 ACSR</u>
PRI. O.H.				
PRI. URD.	<u>6/10</u>	<u>1</u>	<u>6/10</u>	<u>#2 A1</u>
PRI. URD.				
SEC. OH.				
SEC. OH.				
SEC. URD.	<u>25</u>	<u>1</u>	<u>25</u>	<u>4/0</u>
SEC. URD.				

SKETCH OF WORK Ex 1 is 3290' North of 80th St

Fig. 2 of 2  
2015-0473  
090-20-005

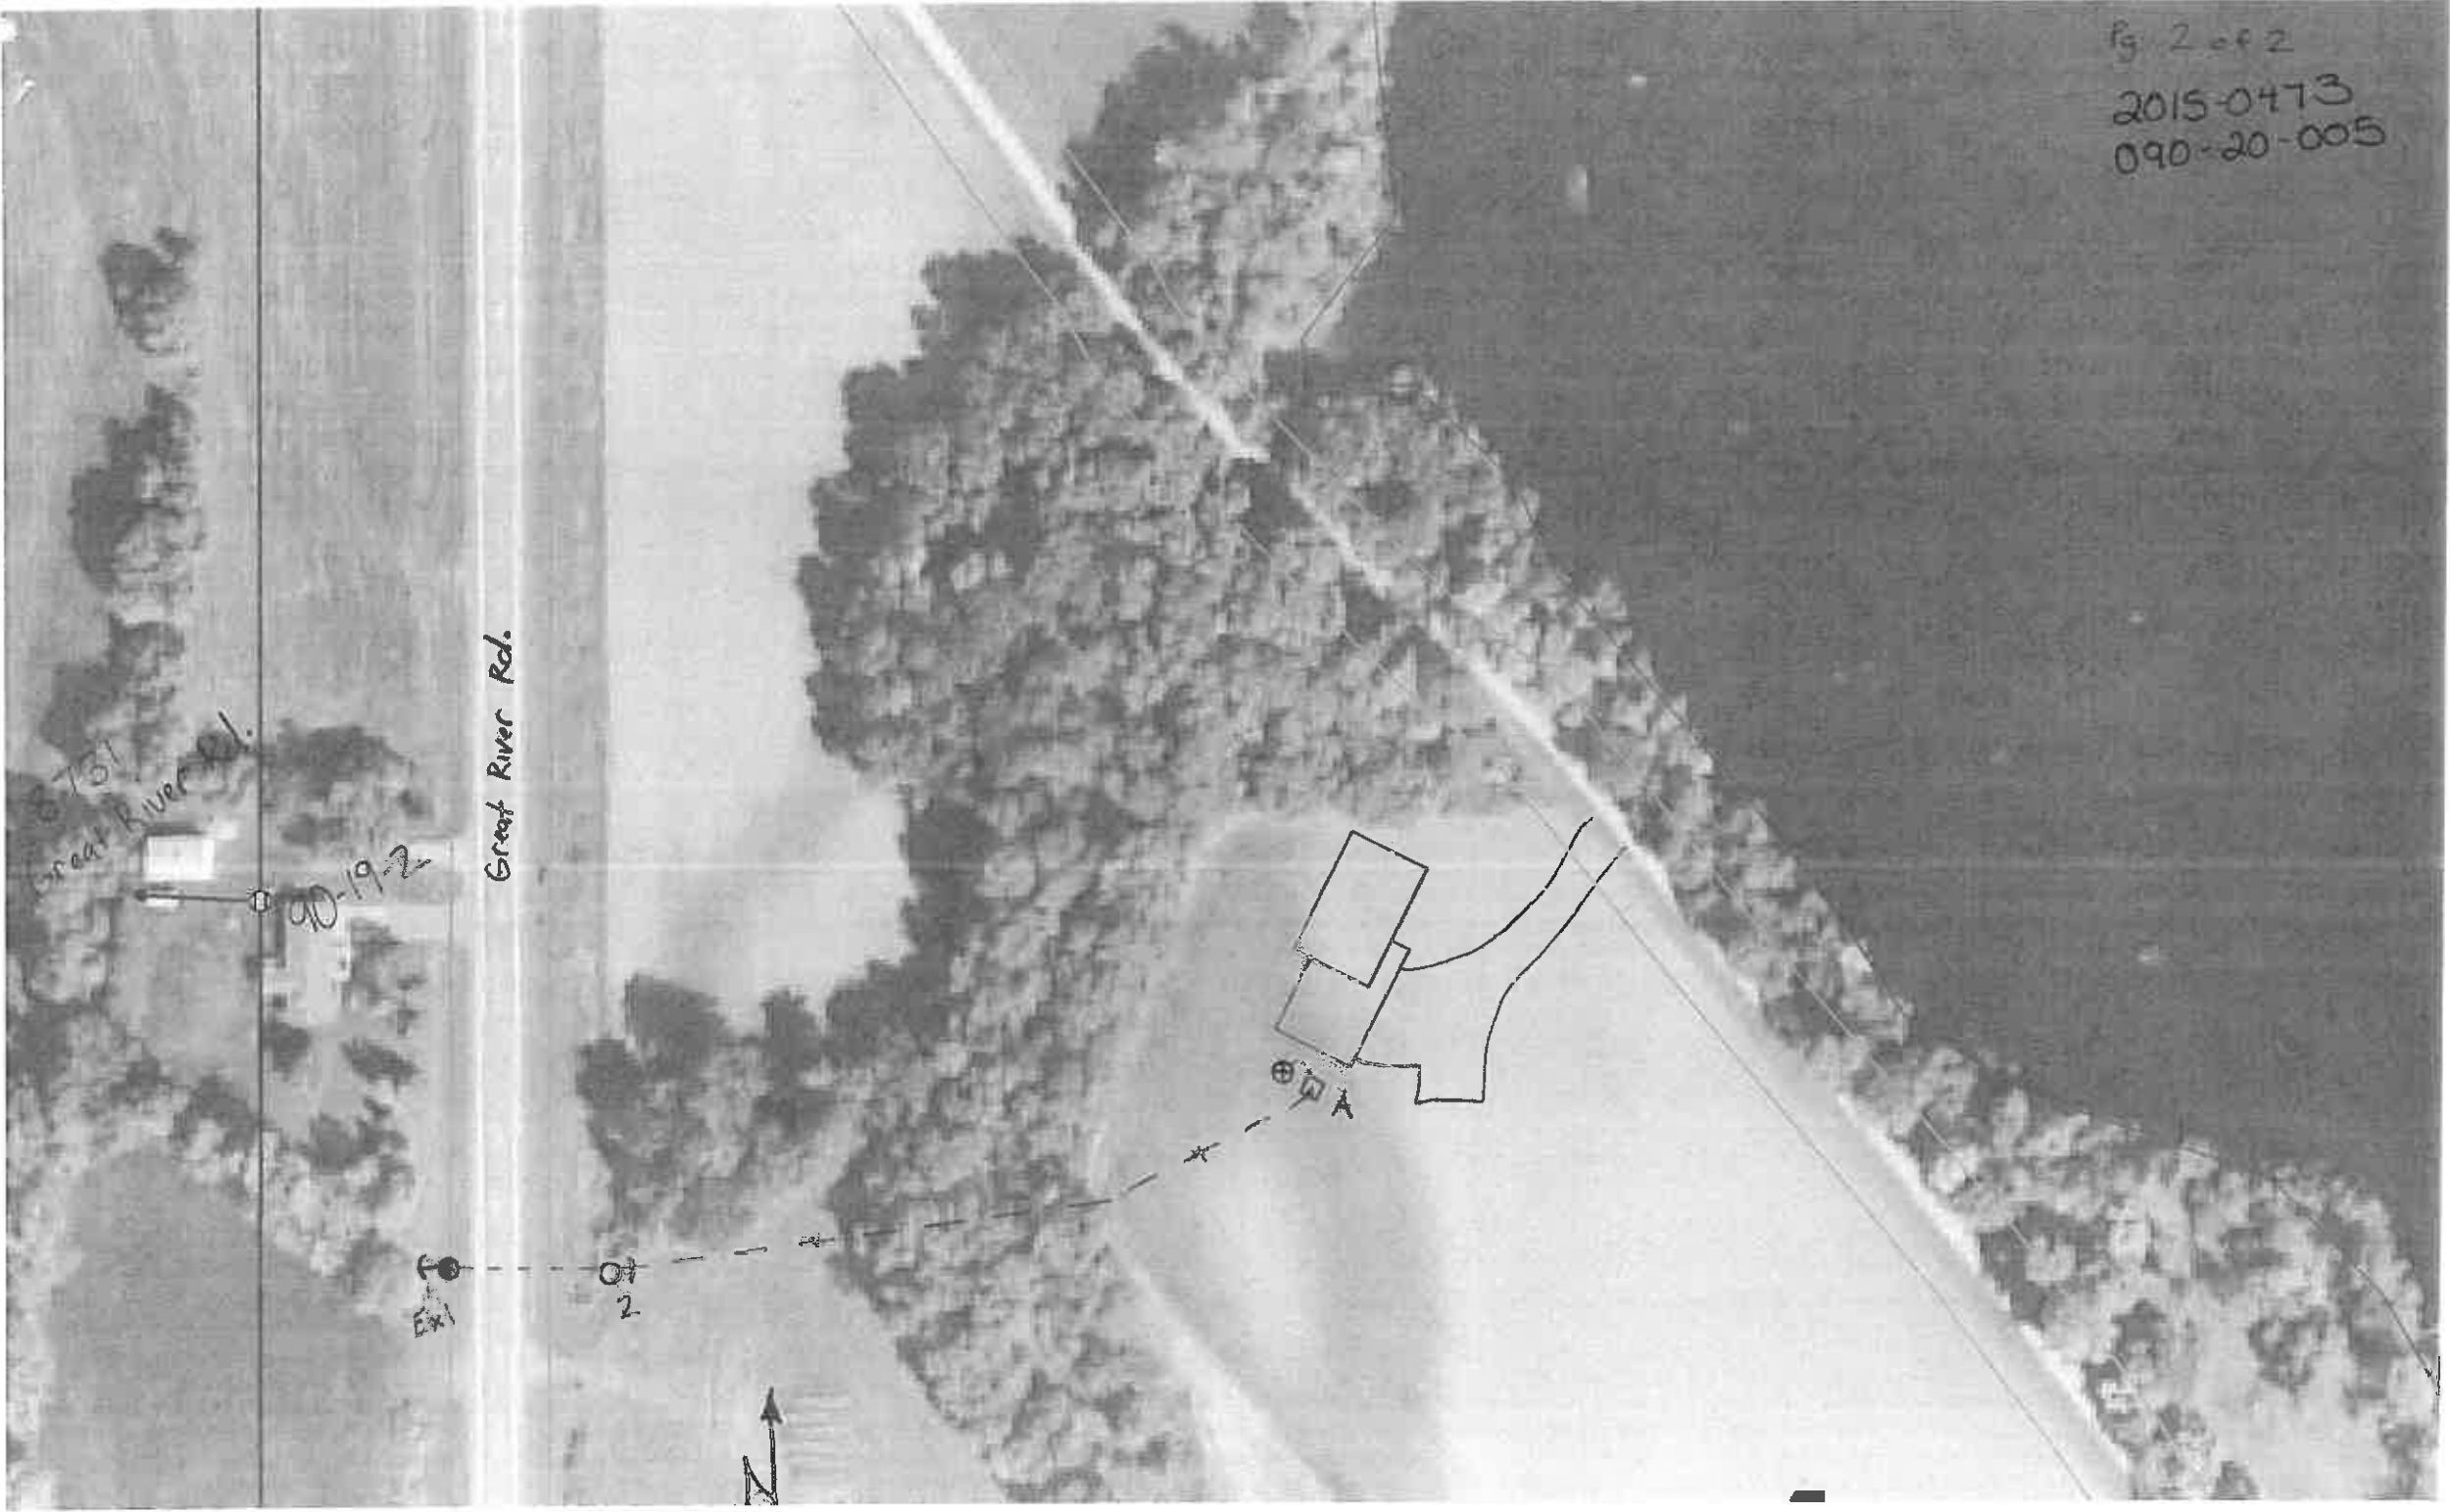

6761  
Great River Rd.

90-19-2

Great River Rd.

Exit

2

A  
B

