


	Gopher State				Tailgate Session				Cty:	Type	Code	Quant	W/O#: 359352	WP#:
	#:	Switching Orders		Source Determined		Sec:	New Const						LOC#: 75-000-09-01503	
	Time OK:	PPE Needed		Potential Hazards		Twp:	Sys Imp						Name: SCOTT J LUBERTS	
	Date OK:	Trees	Weather	Poles	Ins.	Rg:	Ret (RWR)						(H) Phone #:	
	List:	Terrain	Public	Barracading		Signed By: Hiltner			Date: 12/10/2015		(W) Phone #:			
		Power Equip. Needed		Personal Tools		Staked By: Roger Osell			Date: 12/9/2015		(C) Phone #:			
		Sect./Fusing		Supervisor		Elec:			AFF #:		Acct#: 3109404			
COMBINATION STAKING SHEET				Update:	Date:	Comments:				RFCd:		By:	Page: 1 of 2	


Point	Pri. BSpan	Pri. Wire Size	Pole	OH Assy	Grnd.	Guy E	Lead	Anchor F	Trans G	Light M26-5	Ang.	J Box L Ped	Mod	El-bow	Cap	Spl-ice	Pri. Riser	Sec. Span	Sec. Wire	Sec. Unit	CWP Ped/Loop	Misc Assy	Remarks
1						E1-2 E3-10	15	F1-2S															
			40-5	A1	M2-11				G10-10												K15L		
			35-5	A1	M2-11				G10-10												K15L		
A						E1-2 E3-10	15	F1-2S															
			35-5		M2-1					M26-5 HPS								132	1/0 TX	K15L	OWNER LOOP		
			30-6		M2-1					M26-5 HPS								132	1/0 TX	K15L	OWNER LOOP		

Comments 1: CONV / HAZARD	Start Ftg:	End Ftg:
Comments 2:	Start Ftg:	End Ftg:
Comments 3:	Start Ftg:	End Ftg:

Septic: <input type="checkbox"/>	Row 1: NR	Rd Permit <input type="checkbox"/>	Wire/Cables/Ser Size	WIRE FEET	# Wires	Ground FTG			
Priv Elec: <input type="checkbox"/>	Row 2:	Cty Permit <input type="checkbox"/>	1/0 TX	132	1	132			
LP Line: <input type="checkbox"/>	Line Ext\$	Bore/Push\$	Permit\$	Ped/Loop\$	Total\$ NC	1/0 TX	132	1	132
Sprinkler: <input type="checkbox"/>	Socket on Site <input type="checkbox"/> Backfill Comments:		State Permit <input type="checkbox"/>						
Final Grade: <input type="checkbox"/>	Final Grade Comments:		DNR Permit <input type="checkbox"/>						
Brushing: <input type="checkbox"/>	Brushing Comments: NR		Joint Trench <input type="checkbox"/>						
Trees: <input type="checkbox"/>	Trees Comments:		Notify TWP <input type="checkbox"/>						
			Temp. Set:	By:	Comp.:	By:			

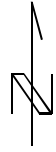

MAP# 75-9-15C

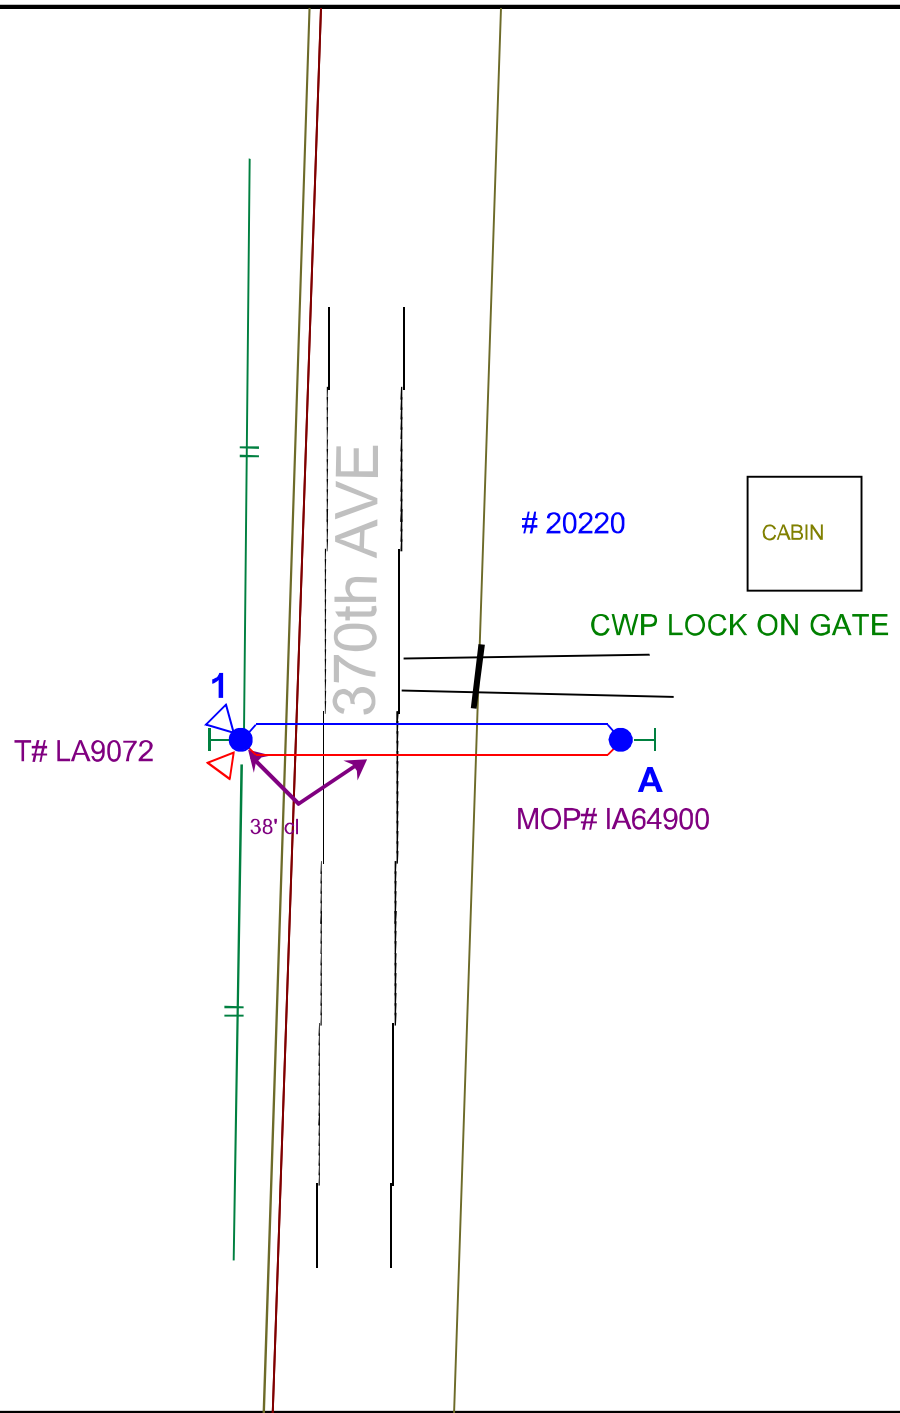

Scale: 1" = 67 feet