


GENERAL LOCATION ONLY. DO NOT USE TO LOCATE FOR EXCAVATION. CALL 1-800-252-1166 FOR ONSITE LOCATIONS AND STAKING.

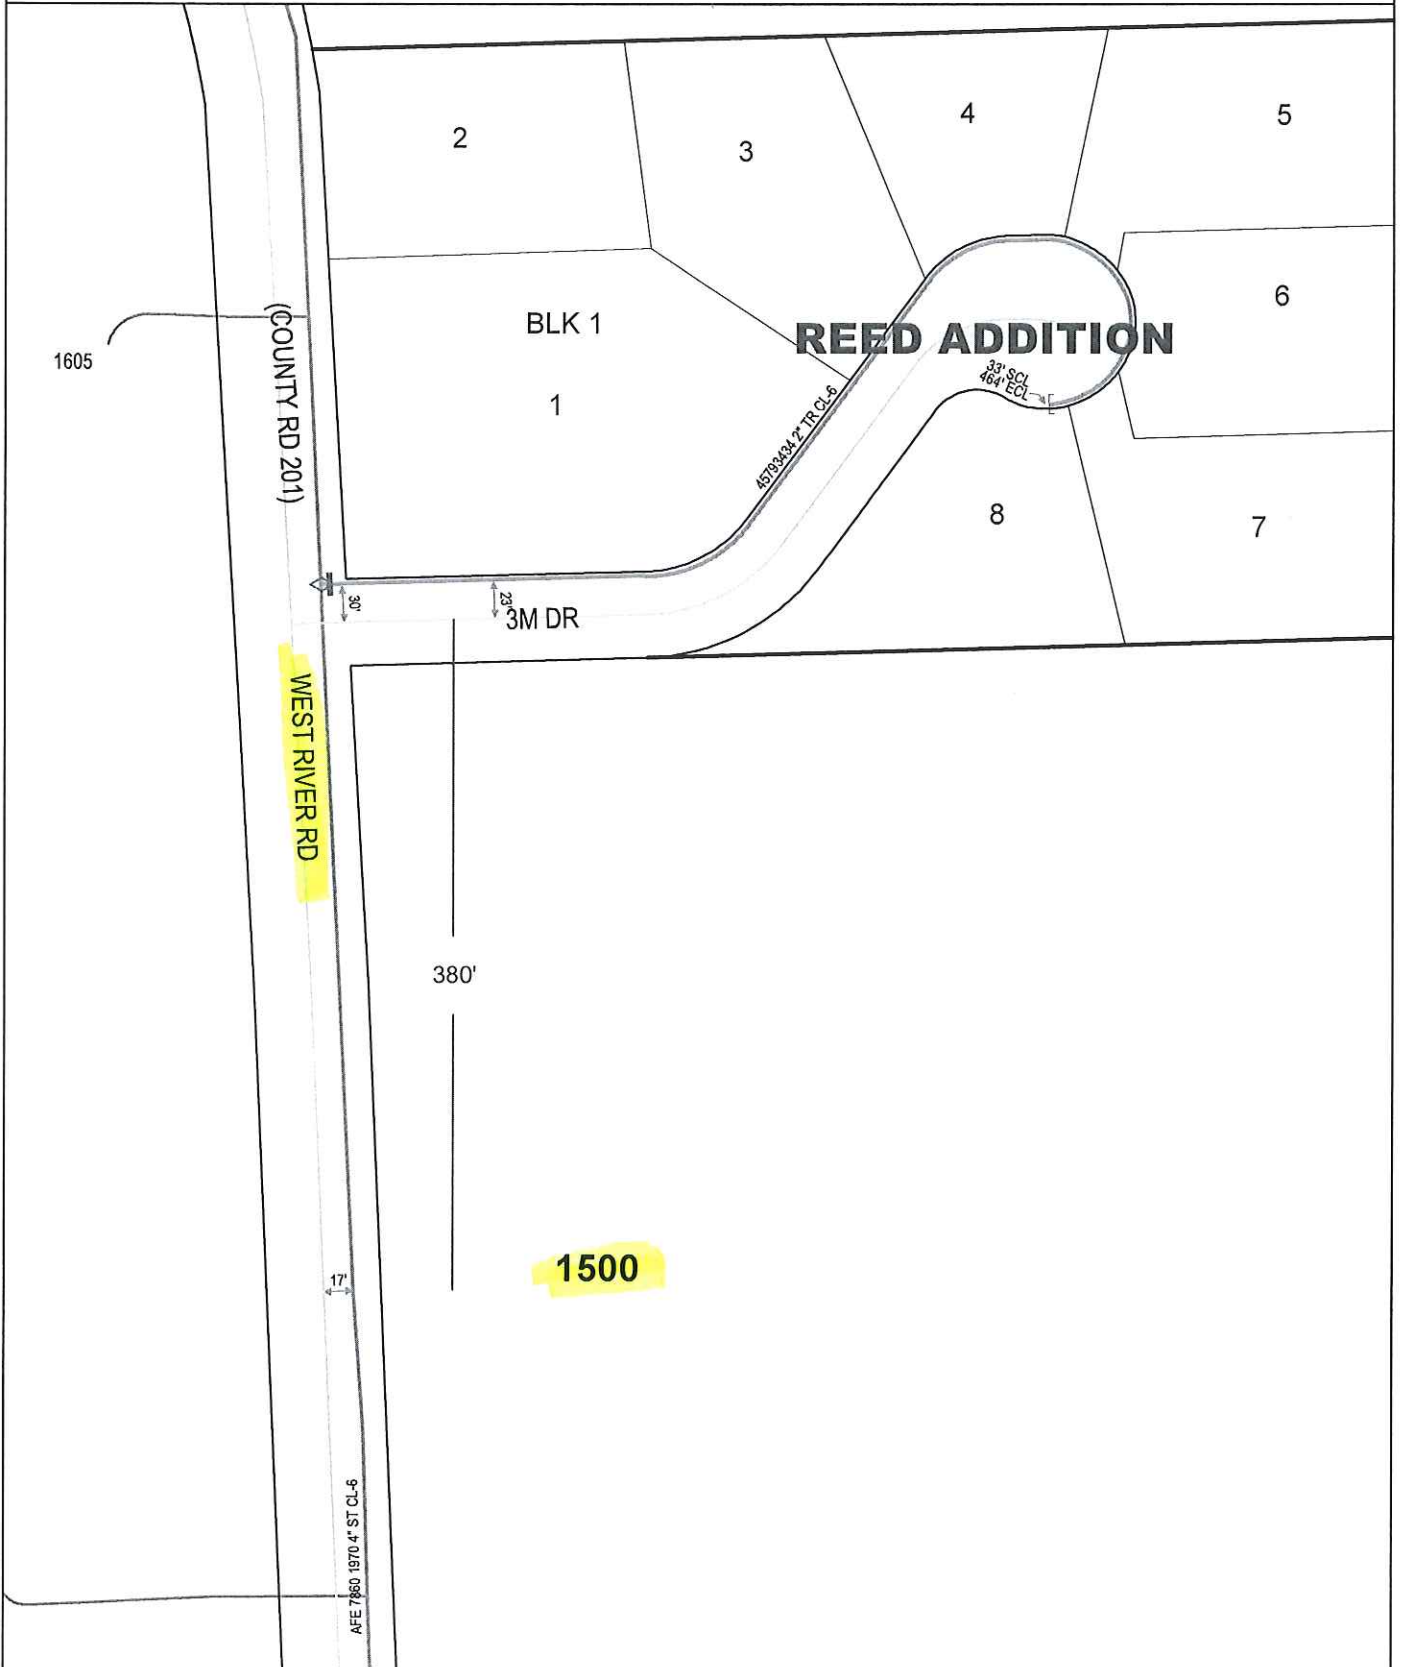

Plotted by: i222382
Plot Date: 6/30/2016

1500 WEST RIVER RD (CO RD 201)
LITTLE FALLS, MN 56345 (MORRISON COUNTY)

Scale: 1" : 100'
CenterPoint Energy
North