



PLAN VIEW: 1"=200'

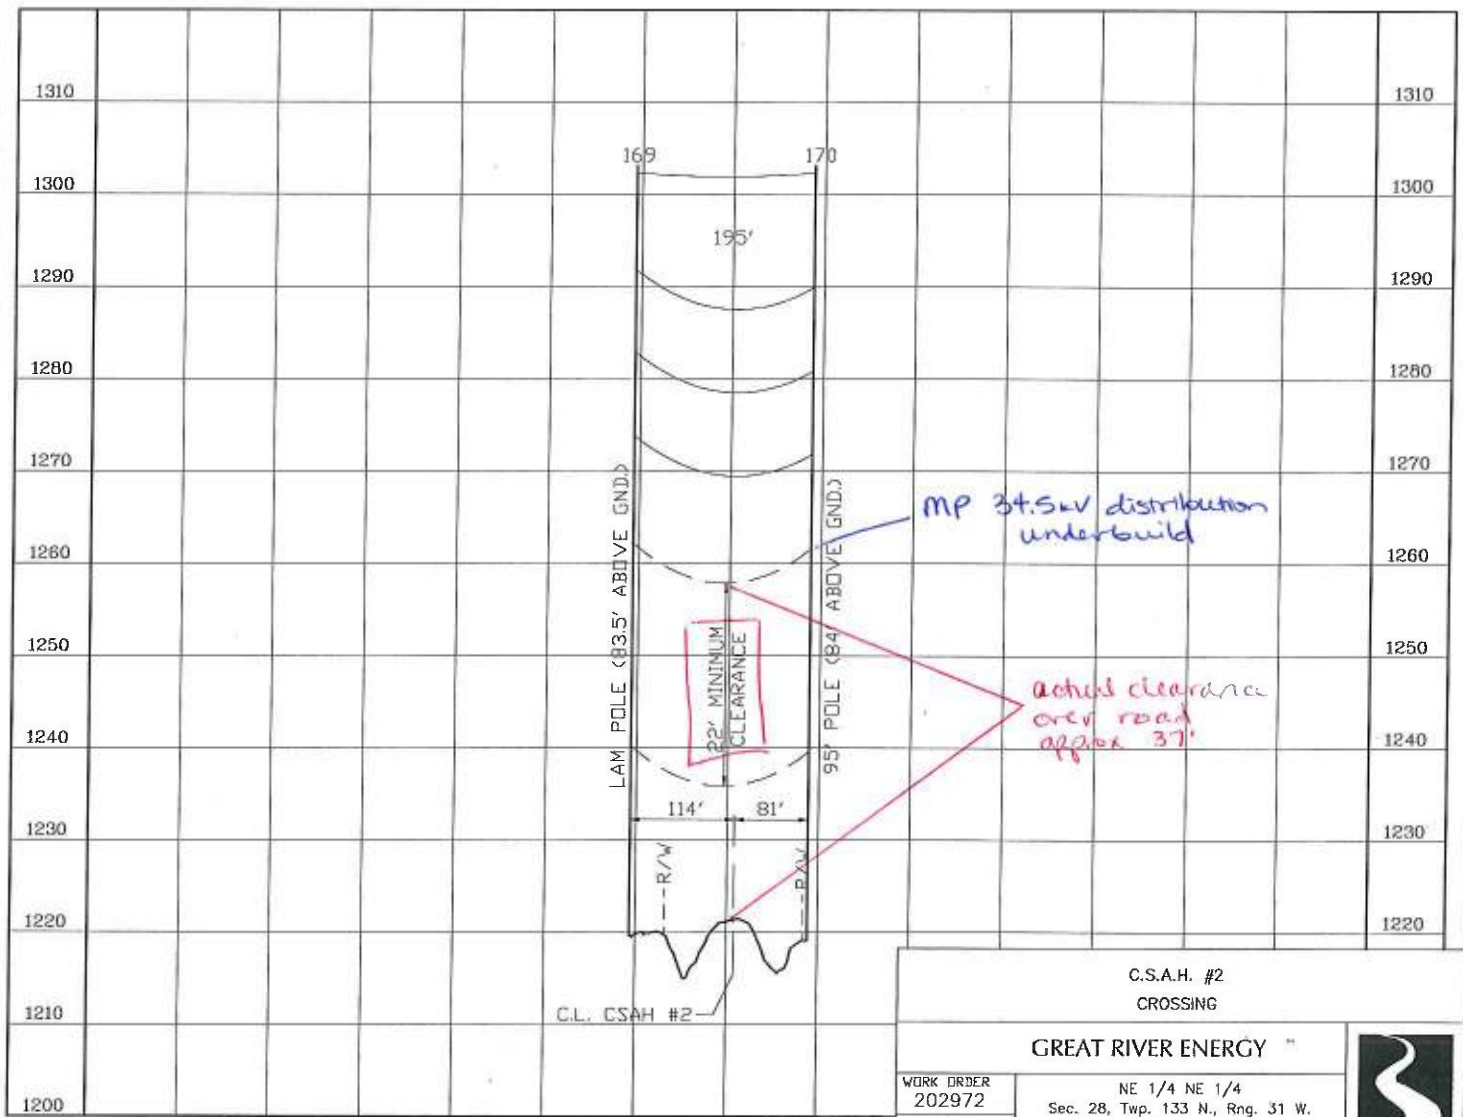

PROFILE VIEW 1"=200' (H)
1"=20' (V)

C.S.A.H. #2 CROSSING		
GREAT RIVER ENERGY		
WORK ORDER 202972	NE 1/4 NE 1/4 Sec. 28, Twp. 133 N., Rng. 31 W. Morrison County, Minnesota	
REVISIONS	DATE 7/25/16	EXHIBIT A
Drawn By: MBN		DWG. NO. CW-MFT-048