


GENERAL LOCATION ONLY. DO NOT USE TO LOCATE FOR EXCAVATION. CALL 1-800-252-1166 FOR ONSITE LOCATIONS AND STAKING.

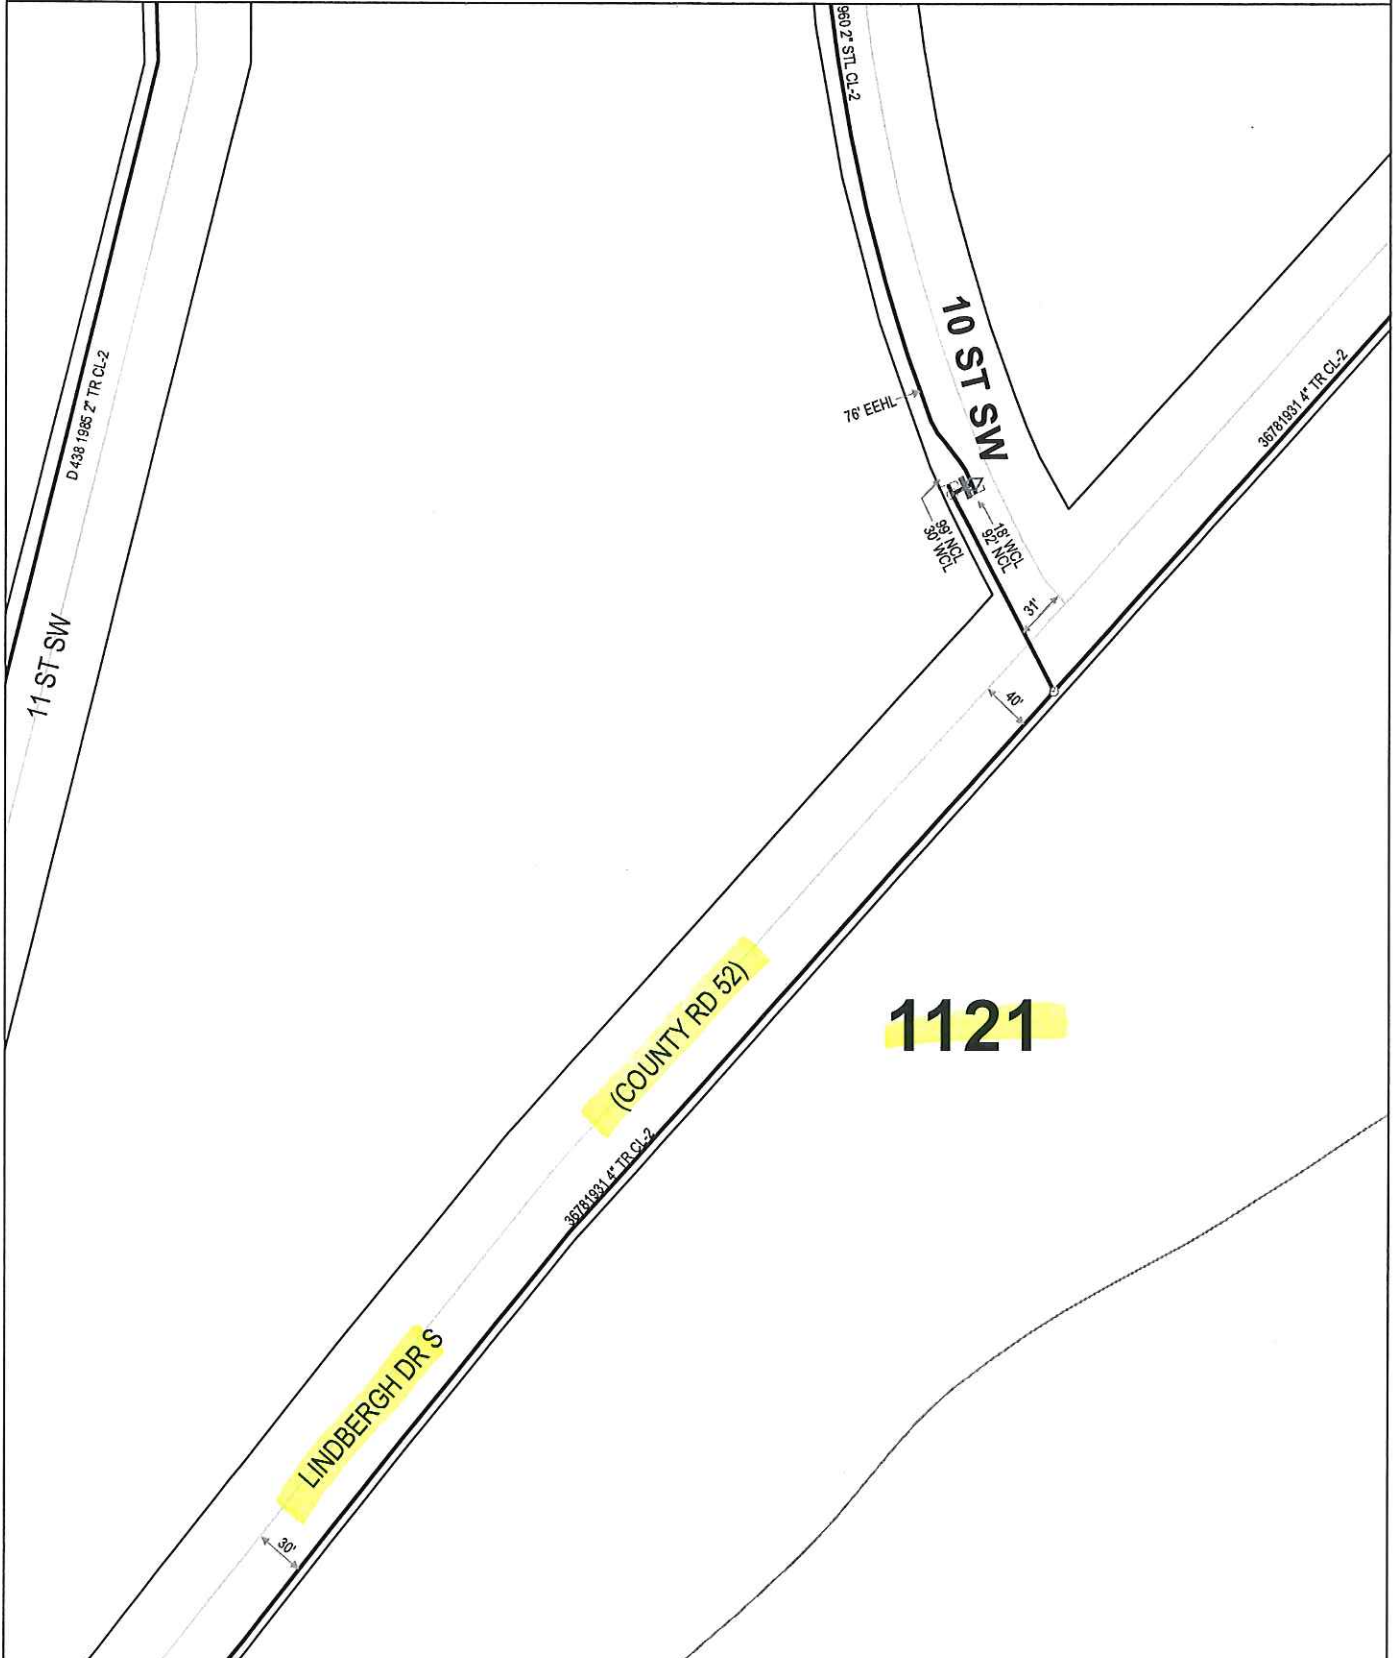

Plotted by: i929684
Plot Date: 10/4/2016

1121 LINDBERGH DR S COUNTY ROAD 52
LITTLE FALLS-MORRISON COUNTY

Scale: 1" : 100'
CenterPoint Energy
North