

MGC# 17-4743

PERMIT
REQUEST
10-06-17


9TH AV NW
LITTLE FALLS

WO# 83577990

Morrison County

4' x 60' TRENCH
SEARCH TO REPAIR
3" GAS MAIN

(CO. RD 201)

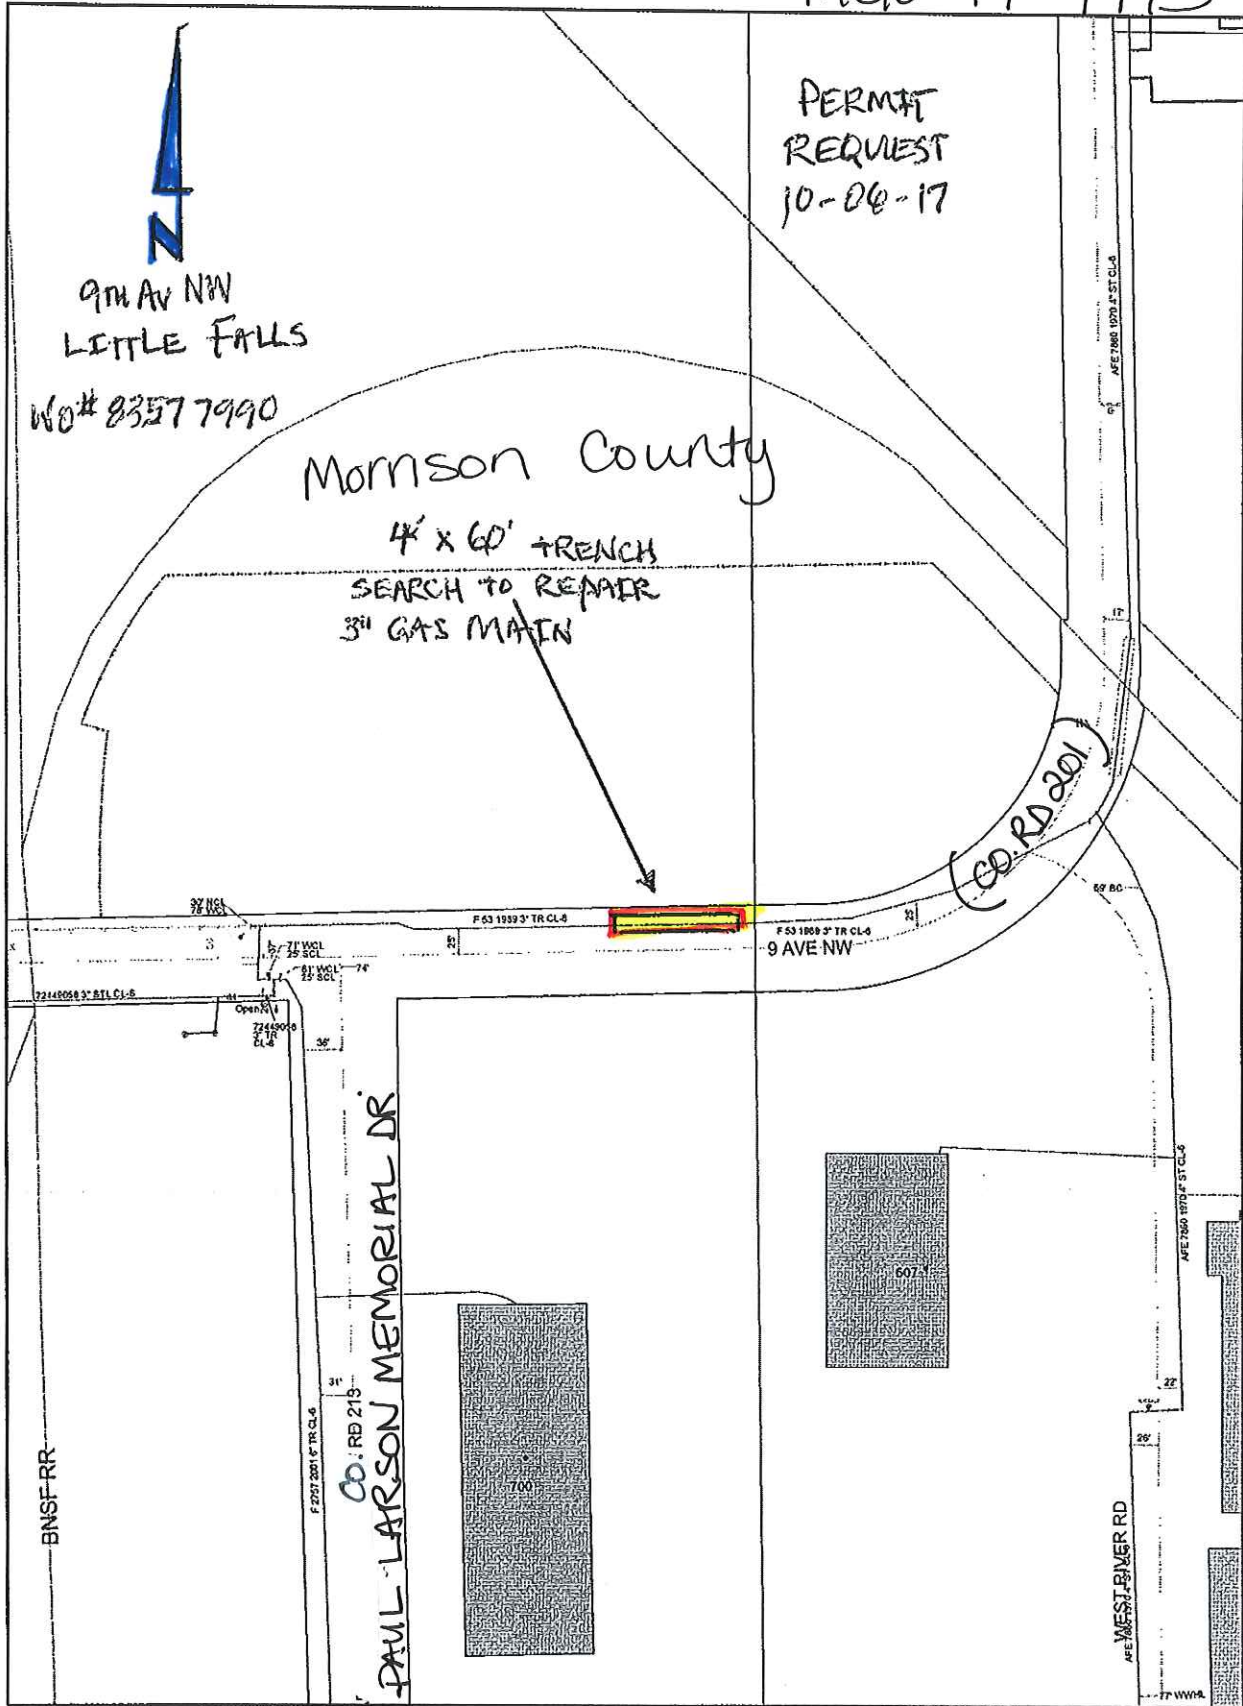

BNSF RR

PAUL LARSON MEMORIAL DR

WEST RIVER RD

9 AVE NW

