


GENERAL LOCATION ONLY. DO NOT USE TO LOCATE FOR EXCAVATION. CALL 1-800-252-1166 FOR ONSITE LOCATIONS AND STAKING.

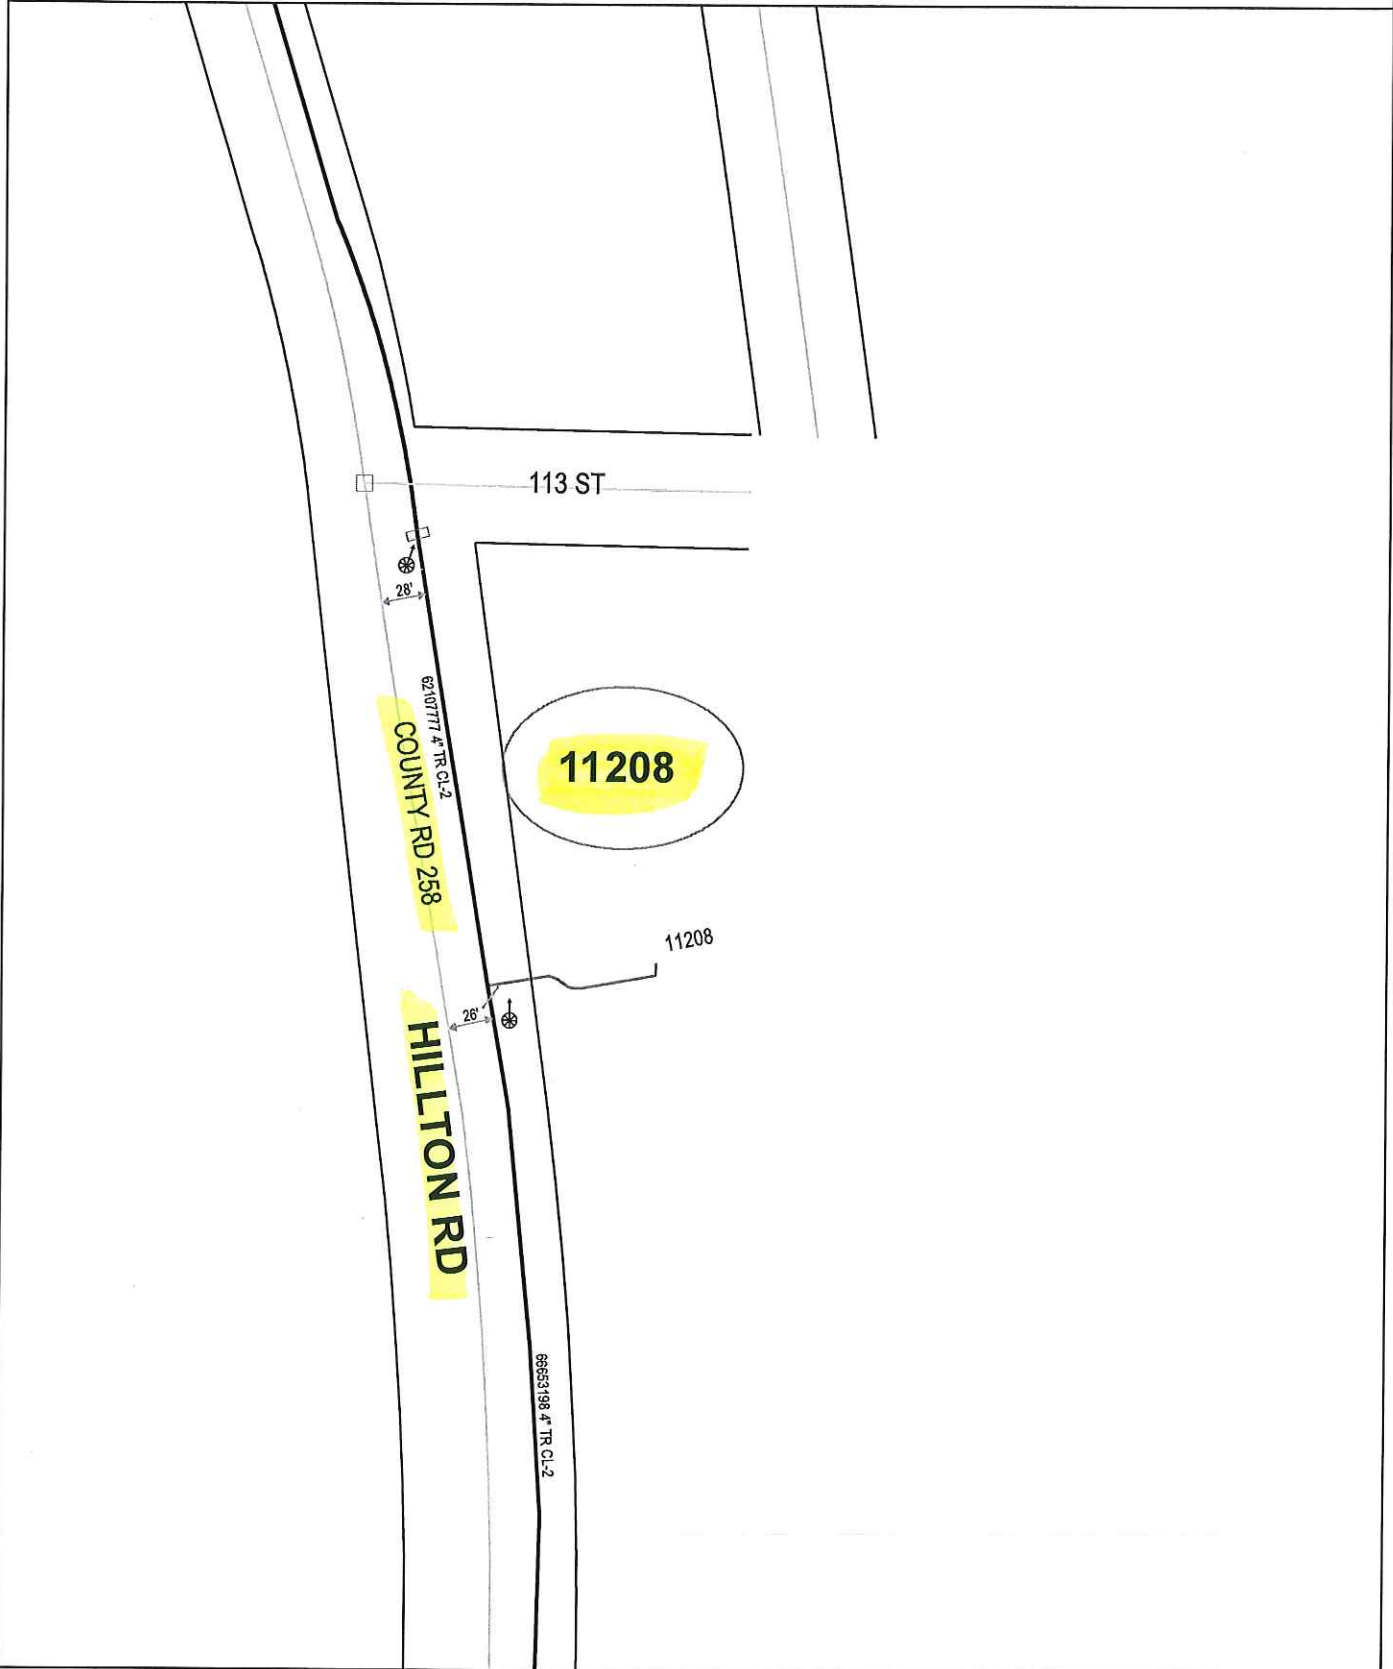

Plotted by: i221539
Plot Date: 11/10/2017

11208 HILLTON RD(COUNTY RD 258)
LITTLE FALLS TWP (MORRISON CO)

Scale: 1" : 100'

