


GENERAL LOCATION ONLY. DO NOT USE TO LOCATE FOR EXCAVATION. CALL 1-800-252-1166 FOR ONSITE LOCATIONS AND STAKING.

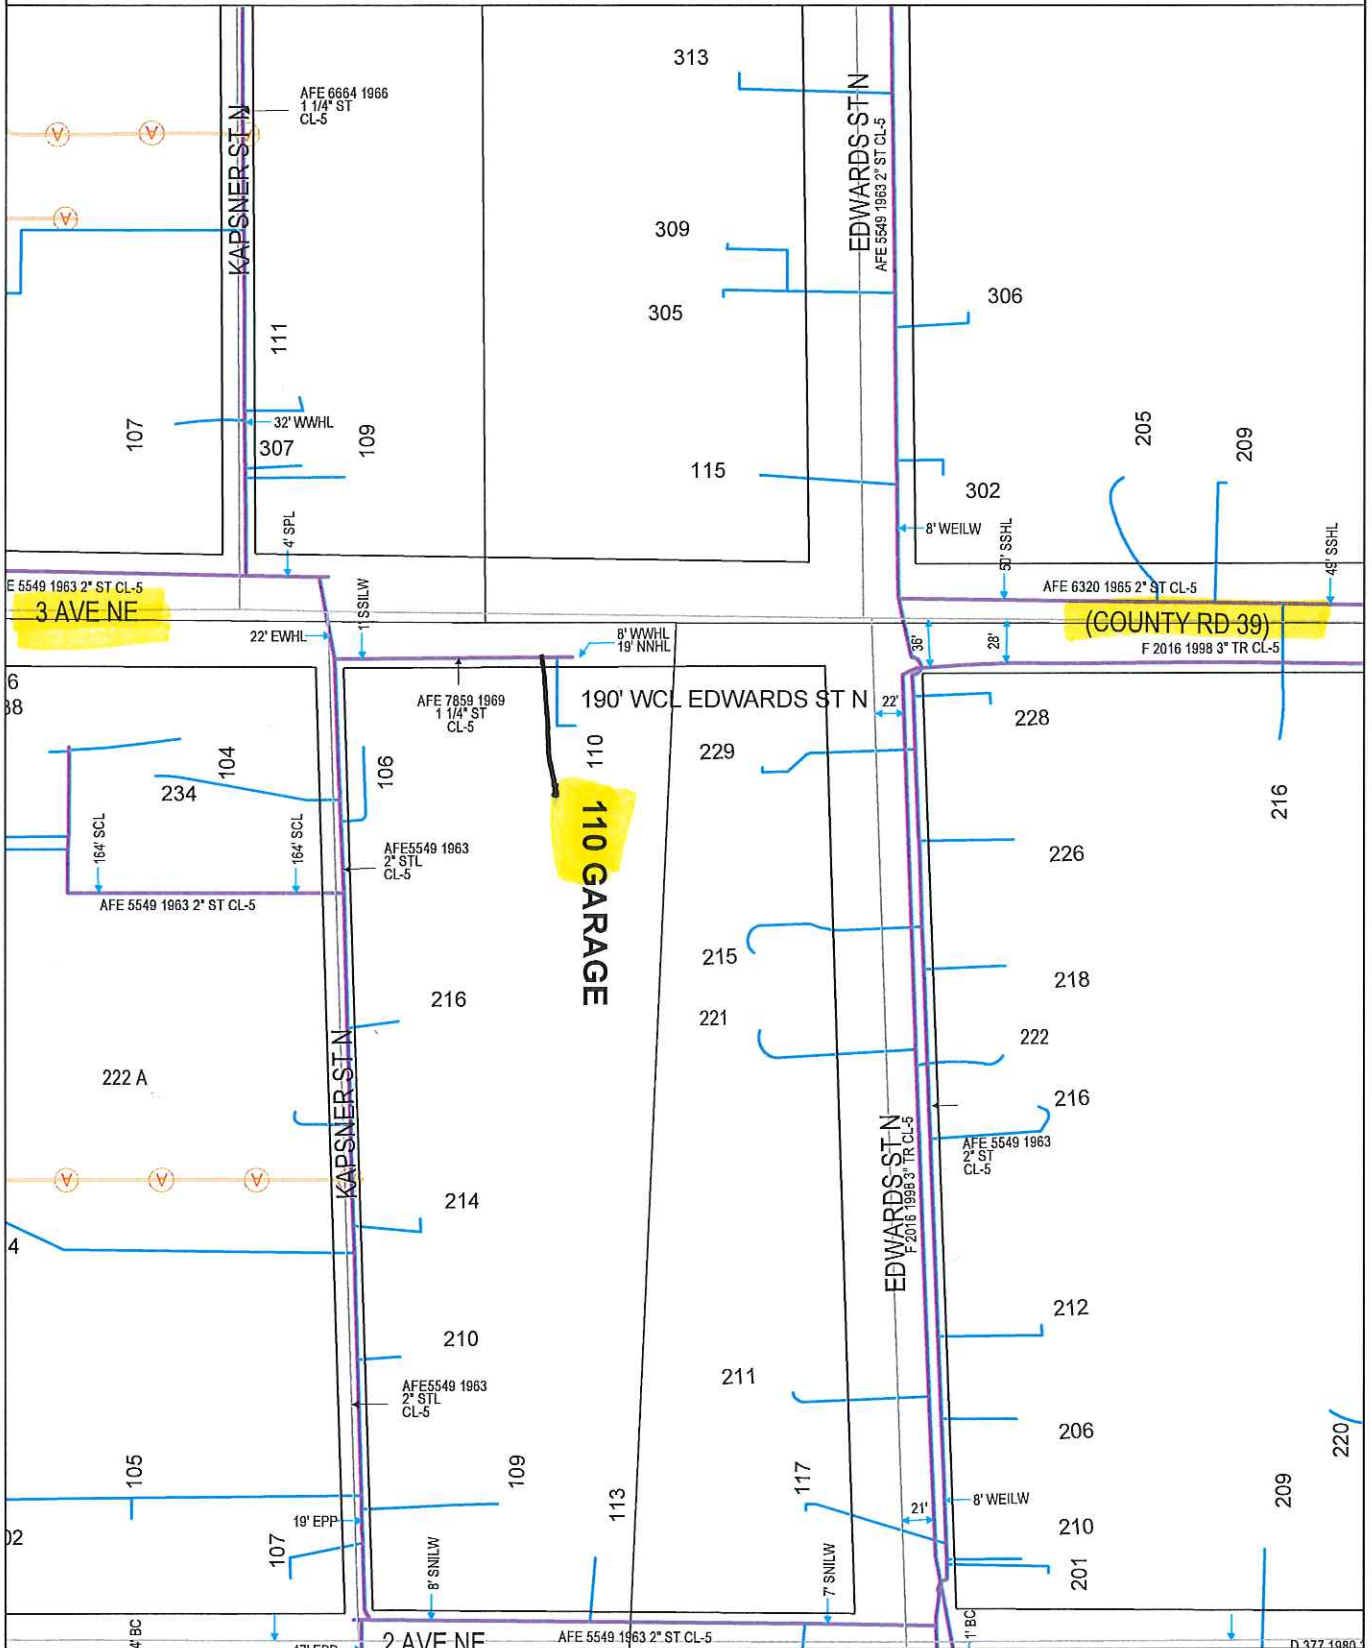

110 GARAGE

Plotted by: i222382
Plot Date: 3/7/2018

110 3RD AVE NE GARAGE (MORRISON CNTY)

PIERZ, MN 56364

Scale: 1" = 100'
CenterPoint Energy
North