GENERAL LOCATION ONLY.
DO NOT USE TO LOCATE FOR EXCAVATION.
CALL 1-800-252-1166 FOR ONSITE LOCATIONS AND STAKING.

CenterPoint Energy

Scale: 1" : 83 '

North

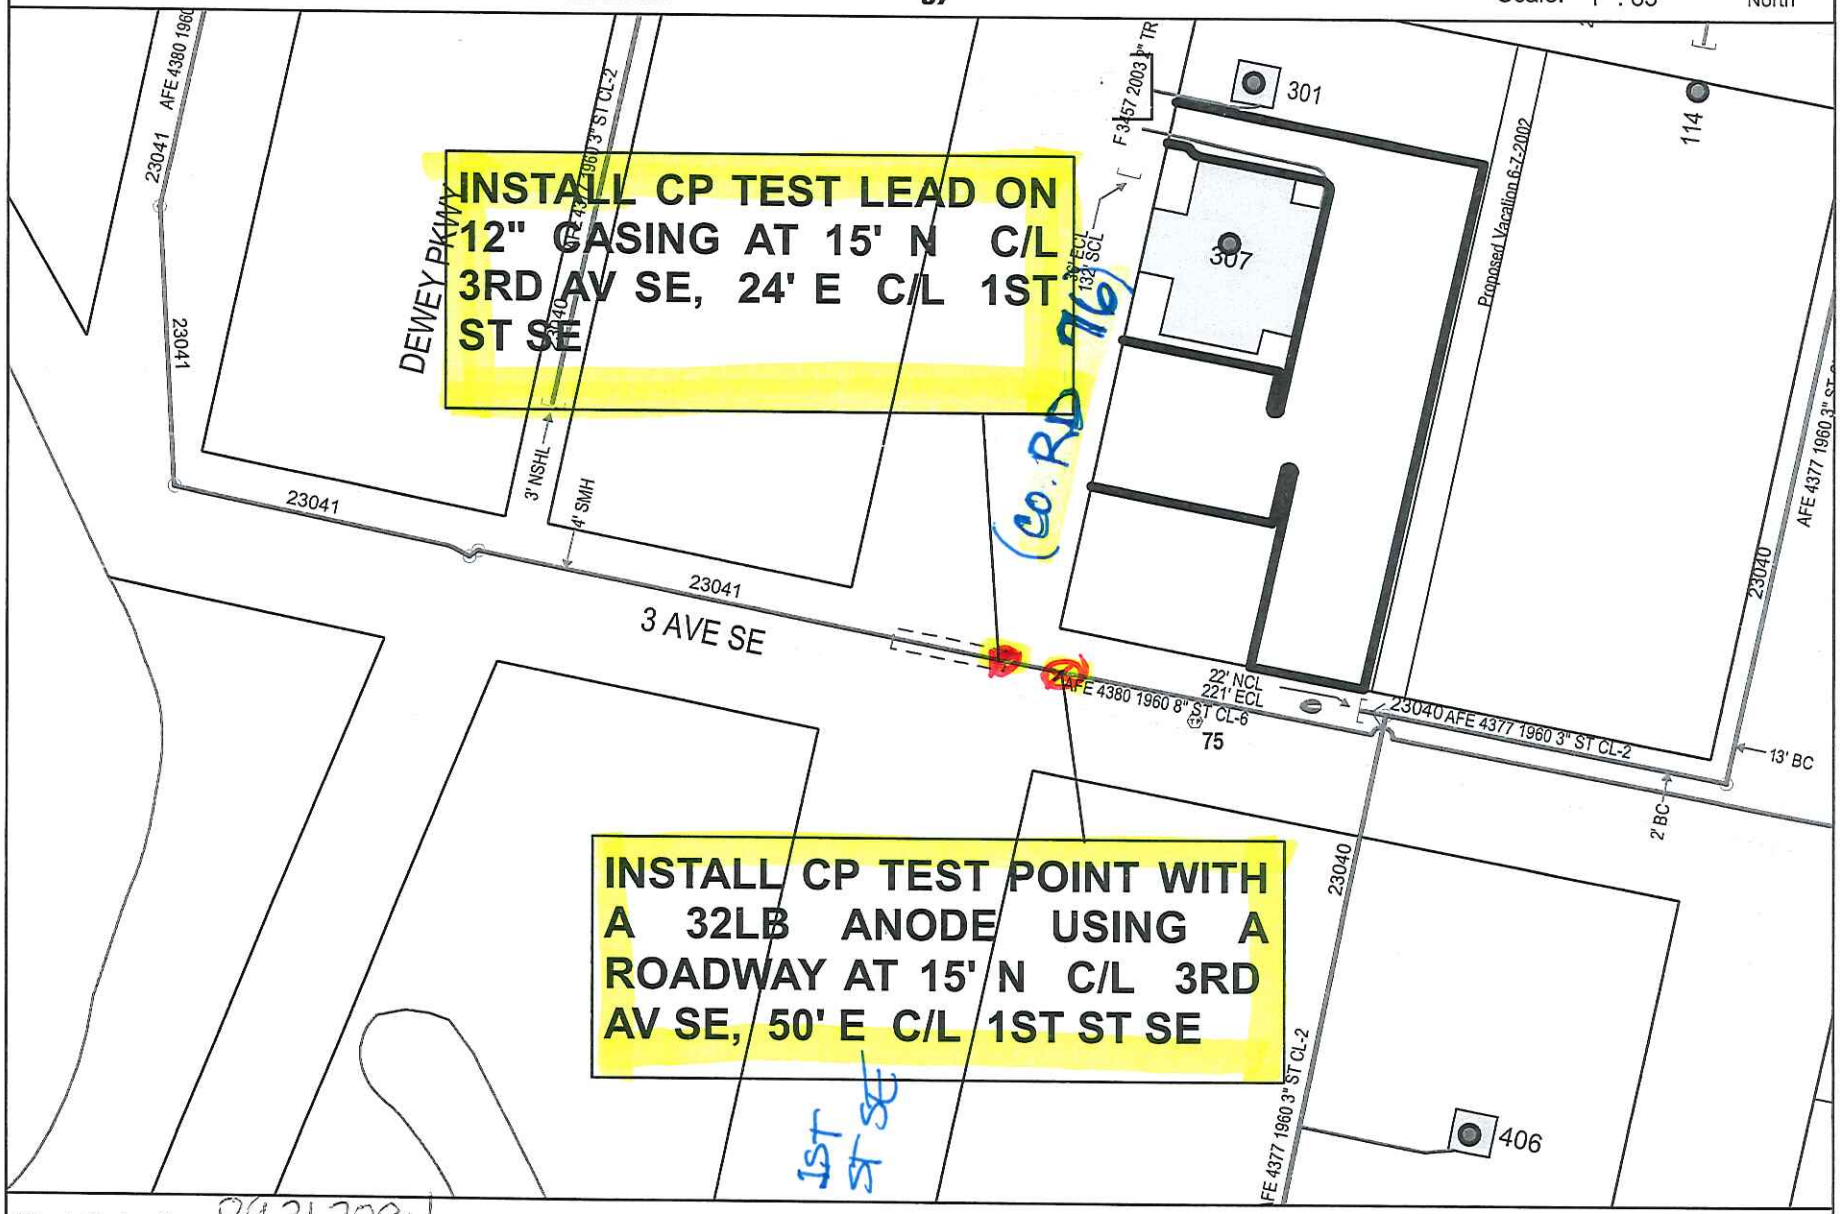

Work Order #: 89212094
Design Date: 02-13-2019
City: LITTLE FALLS
Quad/Sec/Twp/Rng: SW SEC-8/ T-40/ R-32
CP Section #: 23041
CP Area: AL1548-1
Designed By: P TEESELINK
Designer Phone #: 612 910 1378